CHARLES ROSE ARCHITECTS INC www.charlesrosearchitects.com

Charles Rose Architects Inc. (CRA) is providing—see attached list of drawings on electronic media (electronic mail)—in PDF format, based on the following conditions:

- The drawings are copyrighted. The copyright is owned by CRA.
- or consultants without the prior written approval of CRA.
- accuracy to the Working Drawings.
- Drawings.
- nature of electronic media and the translation process.

Your acceptance of these Drawings on electronic media indicates your agreement with the foregoing terms and conditions.

• These Drawings are only for the use of architectural students engaged in school assignments. These Drawings are the property of Charles Rose Architects Inc (CRA).

• These Drawings are not to be changed, revised, or released to any other individuals, companies,

· CRA cautions the user of these Drawings (electronic media in disk form) as referenced above. There may have been revisions to the Working Drawings or field conditions that were not updated in these Drawings. • These Drawings are provided for the convenience of students with no warrantee or implied warrantee of

· CRA shall be held harmless regarding any errors, omissions, or anomalies arising from the use of these

In addition, CRA cautions that errors and omissions in these Drawings may have occurred due to the

ABBREVIATIONS

A/E AB ACOUS ACS PNL AFF ADDL ADJ ALT ALUM ARCH BLDG BLKG BO BOT BTWN BYND CAB CG CEM	Architect/Engineer Anchor Bolt Acoustical Access Panel Above Finished Floor Additional Adjustable, Adjacent, Adjoining Alternate, Altitude Aluminium Architect Building Blocking Bottom Of Bottom Between Beyond Cabinet Corner Guard Cement	LAV LF LH LHR LT MATL MAX MECH MIN MISC MO MTD MTD MTL N NA NIC NO NOM
CER CHAN CJ CLG CLR CMPST CMU COL CONC CONC CONT CORR CSMT CT CTR DBL DEG DEMO DEPT DET DF DIA	Ceramic Channel Construction Joint Ceiling Clear Composite Concrete Masonry Unit Column Concrete Continuous Corridor Casement Ceramic Tile Center, Contour Double Degree Demolition Department Detail Drinking Fountain Diameter	NTS OC OFF OPNG OPP PART PC PERF PERIM PL PLAM PLAS PLYWD PNL PNL PNT PTD PR PRCST PREFAB QTY
DIM DISP DN DWG E EA EFS EL ELEC ELEC ELEV EMER ENCL ENGR ENTR EOS EPDM EQ EQUIP EXT	Dimension Dampproofing Down Drawing East Each EXTERIOR FINISH SYSTEM Elevation Electric Elevator Emergency Enclosure Engineer Entrance Edge of Slab Ethylene Propylene Dione Monomer Equal Equipment Exterior	R RAD RCP RD REC REF REG REINF REQD RH RHR RM RO RV S SAF SC SCHED
FA FD FE CAB FE FH CAB FIN FLR FLUOR FOC FOF FOM FOS FSTP FT FTG FURN FURR GALV GEN GL	Fire Alarm Floor Drain Fire Extinguisher Cabinet Fire Extinguisher Fire Hose Cabinet Finished Floor or Flooring Fluorescent Face of Concrete Face of Finish Face of Masonry Face of Stud Firestopping Foot or Feet Footing Furniture Furring Galvanized Generator Glass	SECT SGL SIM SPEC SS; ST. S' STD STL STOR STRUCT SUSP T TO TOC TEL TEMP TOF TOFF THRESH THRU TOL TOS
GL GWB GYP HDWD HGT HM HORIZ HR HVAC IN INSUL INSUL INSUL JAN JT KIT L	Gypsum Wall Board Gypsum Hardwood Height Hollow Metal Horizontal Hour Heating, Ventilation, Air Conditioning Inch or Inches Insultaion Interior Janitor Joint Kitchen Left Lamination	TYP UNEX UNFIN UON VCT VERT VEST VIF VNR VR W W/ W/O WD WT WP

	Lavatory Linear Foot
	Left Hand
	Left Hand Reverse Light
	Lighting
	Material Maximum
	Mechanical
	Minimum Miscellaneous
	Masonry Opening
	Mounted Metal
	North
	Not Applicable Not in Contract
	Number
	Nominal Not in Scale
	On Center
	Office Opening
	Opposite
	Particle or Partial
	Precast Perforated
	Perimeter Plate
	Plastic Laminate
	Plaster Plywood
	Panel
	Paint Painted
	Pair Precast
	Prefabricated
	Quantity
	Riser Radius
	Reflected Ceiling Plan
	Roof Drain Recessed
	Reference
	Register Reinforce or Reinforcing
	Required Right Hand
	Right Hand Reverse
	Room Rough Opeing
	Roof Vent
	South Sound Absorptive Finish
	Solid Core Schedule or Scheduled
	Section
	Single Similar
OTI	Specification Stainless Steel
STL	Standard
	Steel Storage
	Structural
	Suspended Tread
	Top Of
	Top of Concrete Telephone
	Temporary
	Top of Footing Top of Finished Floor
	Threshold Through
	Tolerance
	Top of Slab or Top of Steel Typical
	Unexcavated
	Unfinished Unless Otherwise Noted
	Vinyl Composition Tile
	Vertical Vestibule
	Contractor to Verify in Field
	Veneer Vapor Retarder
	West
	With Without
	Wood
	Weight Waterproofing
	-

BUILDING SECTION DET# BUILDING DETAIL ELEV# SHT# ELEVATION (# Ax.x # INTERIOR ELEVATION $\langle \# \rangle$ ROOM NAME ROOM NUMBER 005 (101A) DOOR NUMBER $\langle \# \rangle$ WINDOW NUMBER WALL TYPE DET# PLAN/SECTION DETAIL T.O. EL. : 0'-0" ELEVATION MARKER 19'-3.5" CLG HT, AFF ALIGN ALIGN SURFACES 1REVISION MARKER REVISION CLOUD

GENERAL SYMBOLS

\bigcirc	Copyright 2010	

			1				1 1							
AL				E.										
CD SET 04.02.2009 ELECTRICAL	UZ.Z0.2009 PERMIT/CD 11.06.2008 FINAL STRUC 10.22.2008	7 C 008	C.D. 06.06.2008	- SE		600	ELECTRICAL 02.26.2009 DERMIT/CD		7 C	308	- SE 008			
SET CTF CTF	0.2(0.2(0.2(2.2(2.2(2.2(6.2(0.2(2.2(CTF 6.2(6 2(2.2	6.2(MIT 9.2(
2D (2) (2) (2) (2) (2) (2) (2) (2) (2) (2)		PER)8.2	0.00	РЕР 15.1	DRAWING INDEX	CD (9	С.2 2.2 РЕВ	1 . .	PER 98.2	0.0 0.0	PER)5.1			
		x	x	x	C1.0 CODE SUMMARY SHEET	x		- - X		x	X	M0.1 MECHANICAL COVER SHEET		
	X	x	X	х	C1.1 CODE SUMMARY SHEET	X		Х	х	Х	х	M0.2 MECHANICAL DIAGRAMS AND OSA REQUIREMENTS		
		X			C2.0 ADA ACCESSIBILITY REQUIREMENTS	X	+ +	X		X	X	M1.1 MECHANICAL LOWER LEVEL M1.2 MECHANICAL LOWER LEVEL		
			x	x	A1.0 SITE PLAN	X X		X X	x	X X	X X	M1.2 MECHANICAL LOWER LEVEL M1.3 MECHANICAL LOWER LEVEL		
X	X	x	x	x	A2.1 LOWER LEVEL PLAN - STUDIO					Х	x	M2.1 MECHANICAL THESIS BLDG. UPPER LEVEL		
X	X	x	X	X	A2.2 UPPER LEVEL PLAN - STUDIO	X		x		<u>X</u>	X	M2.2 MECHANICAL STUDIO BLDG. UPPER LEVEL		
X X		 X	X X	X	A2.2AMONITOR PLAN A2.2B UPPER LEVEL GRID GEOMETRY					Х	X	M6.1 MECHANICAL DETAIL SHEET		
x			X	x	A2.3 ROOF PLAN - STUDIO	X				х	x	E0.1 LEGEND, ONE LINE & DETAIL		
x	X	X	X	X	A2.4 LOWER LEVEL PLAN - THESIS	X		Х		Х	X	E0.2 ELECTRICAL PANEL & FIXTURE SCHEDULES		
X X		X	X X	X X	A2.5 UPPER LEVEL PLAN - THESIS A2.6 CLERESTORY, ROOF PLAN - THESIS	X X		x x	X X	X X	X X	E2.1 STUDIO LOWER F/P E2.1T THESIS LOWER F/P		
X X		x	X	X	A2.7 LOWER LEVEL REFLECTED CEILING PLAN - STUDIO	X		x	x	X	X	E2.2 UPPER FLOOR PLAN		
x x	X		x	х	A2.8 UPPER LEVEL REFLECTED CEILING PLAN - STUDIO	x	x	Х	Х	Х	х	E2.2T UPPER FLOOR PLAN		
X X	X		X	X	A2.9 LOWER LEVEL REFLECTED CEILING PLAN - THESIS		X					E2.00 SITE PLAN POWER & SIGNAL		
 X	X X		X X	X X	A2.10 UPPER LEVEL REFLECTED CEILING PLAN - THESIS A3.1 EXTERIOR ELEVATIONS - STUDIO	x		x		x	x	P0.1 PLUMBING SCHEDULES AND LEGEND		
X			X	X	A3.2 EXTERIOR ELEVATIONS - THESIS			X		x	X	P1.0 PLUMBING FOUNDATION PLAN		
	X	X	X	X	A4.1 BUILDING SECTIONS - STUDIO	x				Х	X	P1.1 PLUMBING LOWER LEVEL		
X X	 X	 X	X X	X X	A4.2 BUILDING SECTIONS - THESIS A5.1 INTERIOR ELEVATIONS	X X		 X		X X	X X	P1.2 PLUMBING LOWER LEVEL P1.3 PLUMBING LOWER LEVEL		
X	X		x	X	A5.2 INTERIOR ELEVATIONS		+	x		× X	× X	P2.1 PLUMBING UPPER LEVEL THESIS		
x	X		x	х	A5.3 INTERIOR ELEVATIONS					х	x	P2.2 PLUMBING UPPER LEVEL		
x	X		x	X	A5.4 INTERIOR ELEVATIONS - THESIS	X				X	X	P2.3 PLUMBING UPPER LEVEL		
X X		X	X X	X X	A6.1 WALL SECTIONS A6.2 WALL SECTIONS	X				X	X	P6.1 PLUMBING DETAILS		
x			x	X	A6.3 WALL SECTIONS									
X		X	x	х	A6.4 EXTERIOR & WINDOW DETAILS									
X			X	X	A6.5 PLAN & SECTION DETAILS - THESIS A7.1 STAIR DETAILS - STUDIO	_								
X			X X	X X	A7.2 EXTERIOR STAIR DETAILS - THESIS	_				KE	· v •			
			x	х	A7.3 INTERIOR STAIR DETAILS - THESIS						<u>. T .</u>			
x			X	X	A7.4 ENLARGED BATHROOM PLANS & ELEVATIONS	_				х	ISSUE	ED		
 X			X X	X X	A8.1 MILLWORK A8.2 MILLWORK	RE-ISSUED, NO CHANGES								
X	X		x	X	A8.3 INTERIOR DETAILS	_								
			x		A8.4 MONITOR DETAILS				2		\sim	~~~~~~~~~~~~~~~~~~~~~~~~~~~~~~~~~~~~~~~		
 X	 X	X	X X	X X	A9.1 PARTITION TYPES A9.2 FINISH SCHEDULE	_				> <u>DE</u>	FERR	ED SUBMITTALS:		
X	X	x	x	X	A9.3 DOOR SCHEDULE	-				<pre>{ 1</pre>	SPRIN	KLERS		
										\ \				
	X	V	X	X	S0.1 DRAWING INDEX AND LIST OF ABBREVIATIONS S0.2 GENERAL STRUCTURAL NOTES							IIC DESIGN CALCULATIONS AND		
		X	X X	X X	S0.3 GENERAL STRUCTURAL NOTES CONT.	_	DETAILS FOR MECHANICAL EQUIPMENT							
	X	x	x	х	S2.1 STUDIO FOUNDATION PLAN					- .		AIN WALLS		
	X		x	X	S2.1A STUDIO FOUNDATION SLAB PLAN	_				(DRAWINGS AND CALCULATIONS FOR		
		x	X X	X X	S2.2 STUDIO UPPER LEVEL FRAMING PLAN S2.2A STUDIO UPPER LEVEL DECK PLAN	_				{				
	X X	x	X	X	S2.3 STUDIO ROOF FRAMING PLAN					6				
	X	X	X	X	S2.3A STUDIO HIGH ROOF FRAMING PLAN					$\langle $	SUSF	PENDED CEILINGS, TO COMPLY WITH \int		
		X	X X	X	S2.4 THESIS FOUNDATION PLAN S2.4A THESIS FOUNDATION SLAB PLAN	_				(
	X	x	X	x	S2.5 THESIS UPPER LEVEL FRAMING PLAN	\neg				\smile	\sim			
	X	x	x	x	S2.6 THESIS ROOF FRAMING PLAN									
	X	X	X	X	S3.1 BRACED FRAME ELEVATIONS S5.1 CONCRETE DETAILS	_								
		x	X X	X X	S5.1 CONCRETE DETAILS S5.2 CONCRETE DETAILS	-								
	X		x	X	S5.3 CONCRETE DETAILS									
	X		X	X	S5.4 CONCRETE DETAILS									
		x	X X	X X	S6.1 STEEL DETAILS S6.2 STEEL DETAILS	\neg								
	X X		x	X	S6.3 STEEL DETAILS									
	X		X	X	S6.4 STEEL DETAILS									
		X X	X X	X X	S6.5 STEEL DETAILS S6.6 STEEL DETAILS	_								
		X	X	X	S6.7 BRACED FRAME DETAILS	\neg								
	X	x	x	x	S6.8 STEEL DETAILS									
	X	x	X	X	S7.1 WOOD DETAILS	_								
			X X	X X	S7.2 WOOD DETAILS S7.3 WOOD DETAILS									
	x	x	x	X	S7.4 WOOD DETAILS									
	X		X	X	S7.5 WOOD DETAILS									

	10122002		DRAWING,	P

OWNER OREGON COLLEGE OF ART & CRAFT 8245 SW BARNES ROAD

PORTLAND, OR 97225 TEL: (503) 297-5544

OWNER'S REPRESENTATIVE TEAM-BUILD, BRUCE FICKETT 425 NW10TH AVENUE, SUITE 201-A PORTLAND, OR 97209 TEL: (503) 546-6123 FAX: (503) 467-4800

ARCHITECT CHARLES ROSE ARCHITECTS INC. 115 WILLOW AVE. SOMERVILLE, MA 02144 TEL: (617) 628-5033 FAX: (617) 628-7033

ASSOCIATE ARCHITECT COLAB ARCHITECTURE + URBAN DESIGN 421 SW 6TH AVENUE, SUITE 1250 PORTLAND, OR 97204 TEL: (503) 827-5339 FAX: (503) 827-8164


> STRUCTURAL ENGINEER KPFF CONSULTING ENGINEERS 111 SW 5TH AVENUE, SUITE 2500 PORTLAND, OR 97204 TEL: (503) 227-3251 FAX: (503) 227-7980

> > MECHANICAL ENGINEER MEP CONSULTING, LLC 828 NW 19th Ave. PORTLAND, OR 97209 TEL: (503) 248-5300 FAX: (503) 248-6305

ELECTRICAL ENGINEER HK ENGINEERING 15365 SW DIVISION STREET SHERWOOD, OR 97140 TEL: (503)625-4443 FAX: (503)625-4187

CODE CONSULTANT EVERGREEN ENGINEERING 7431 NW EVERGREEN PARKWAY, SUITE 210 HILLSBORO, OREGON 97124 TEL: (503) 439.8777 FAX: (503) 439.8767

> SPECIFICATION WRITER WRITE ANGLE 404 SE 6TH AVENUE PORTLAND, OR 97214 TEL: 503. 595.9593 FAX: 503. 595.9594

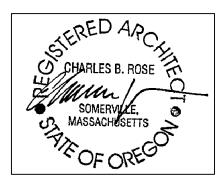



PAINTING, & PHOTOGRAPHY STUDIOS


OREGON COLLEGE OF ART & CRAFT PORTLAND, OR 97225


CONSTRUCTION SET VOLUME ONE


APRIL 2, 2009 CHARLES ROSE ARCHITECTS INC.

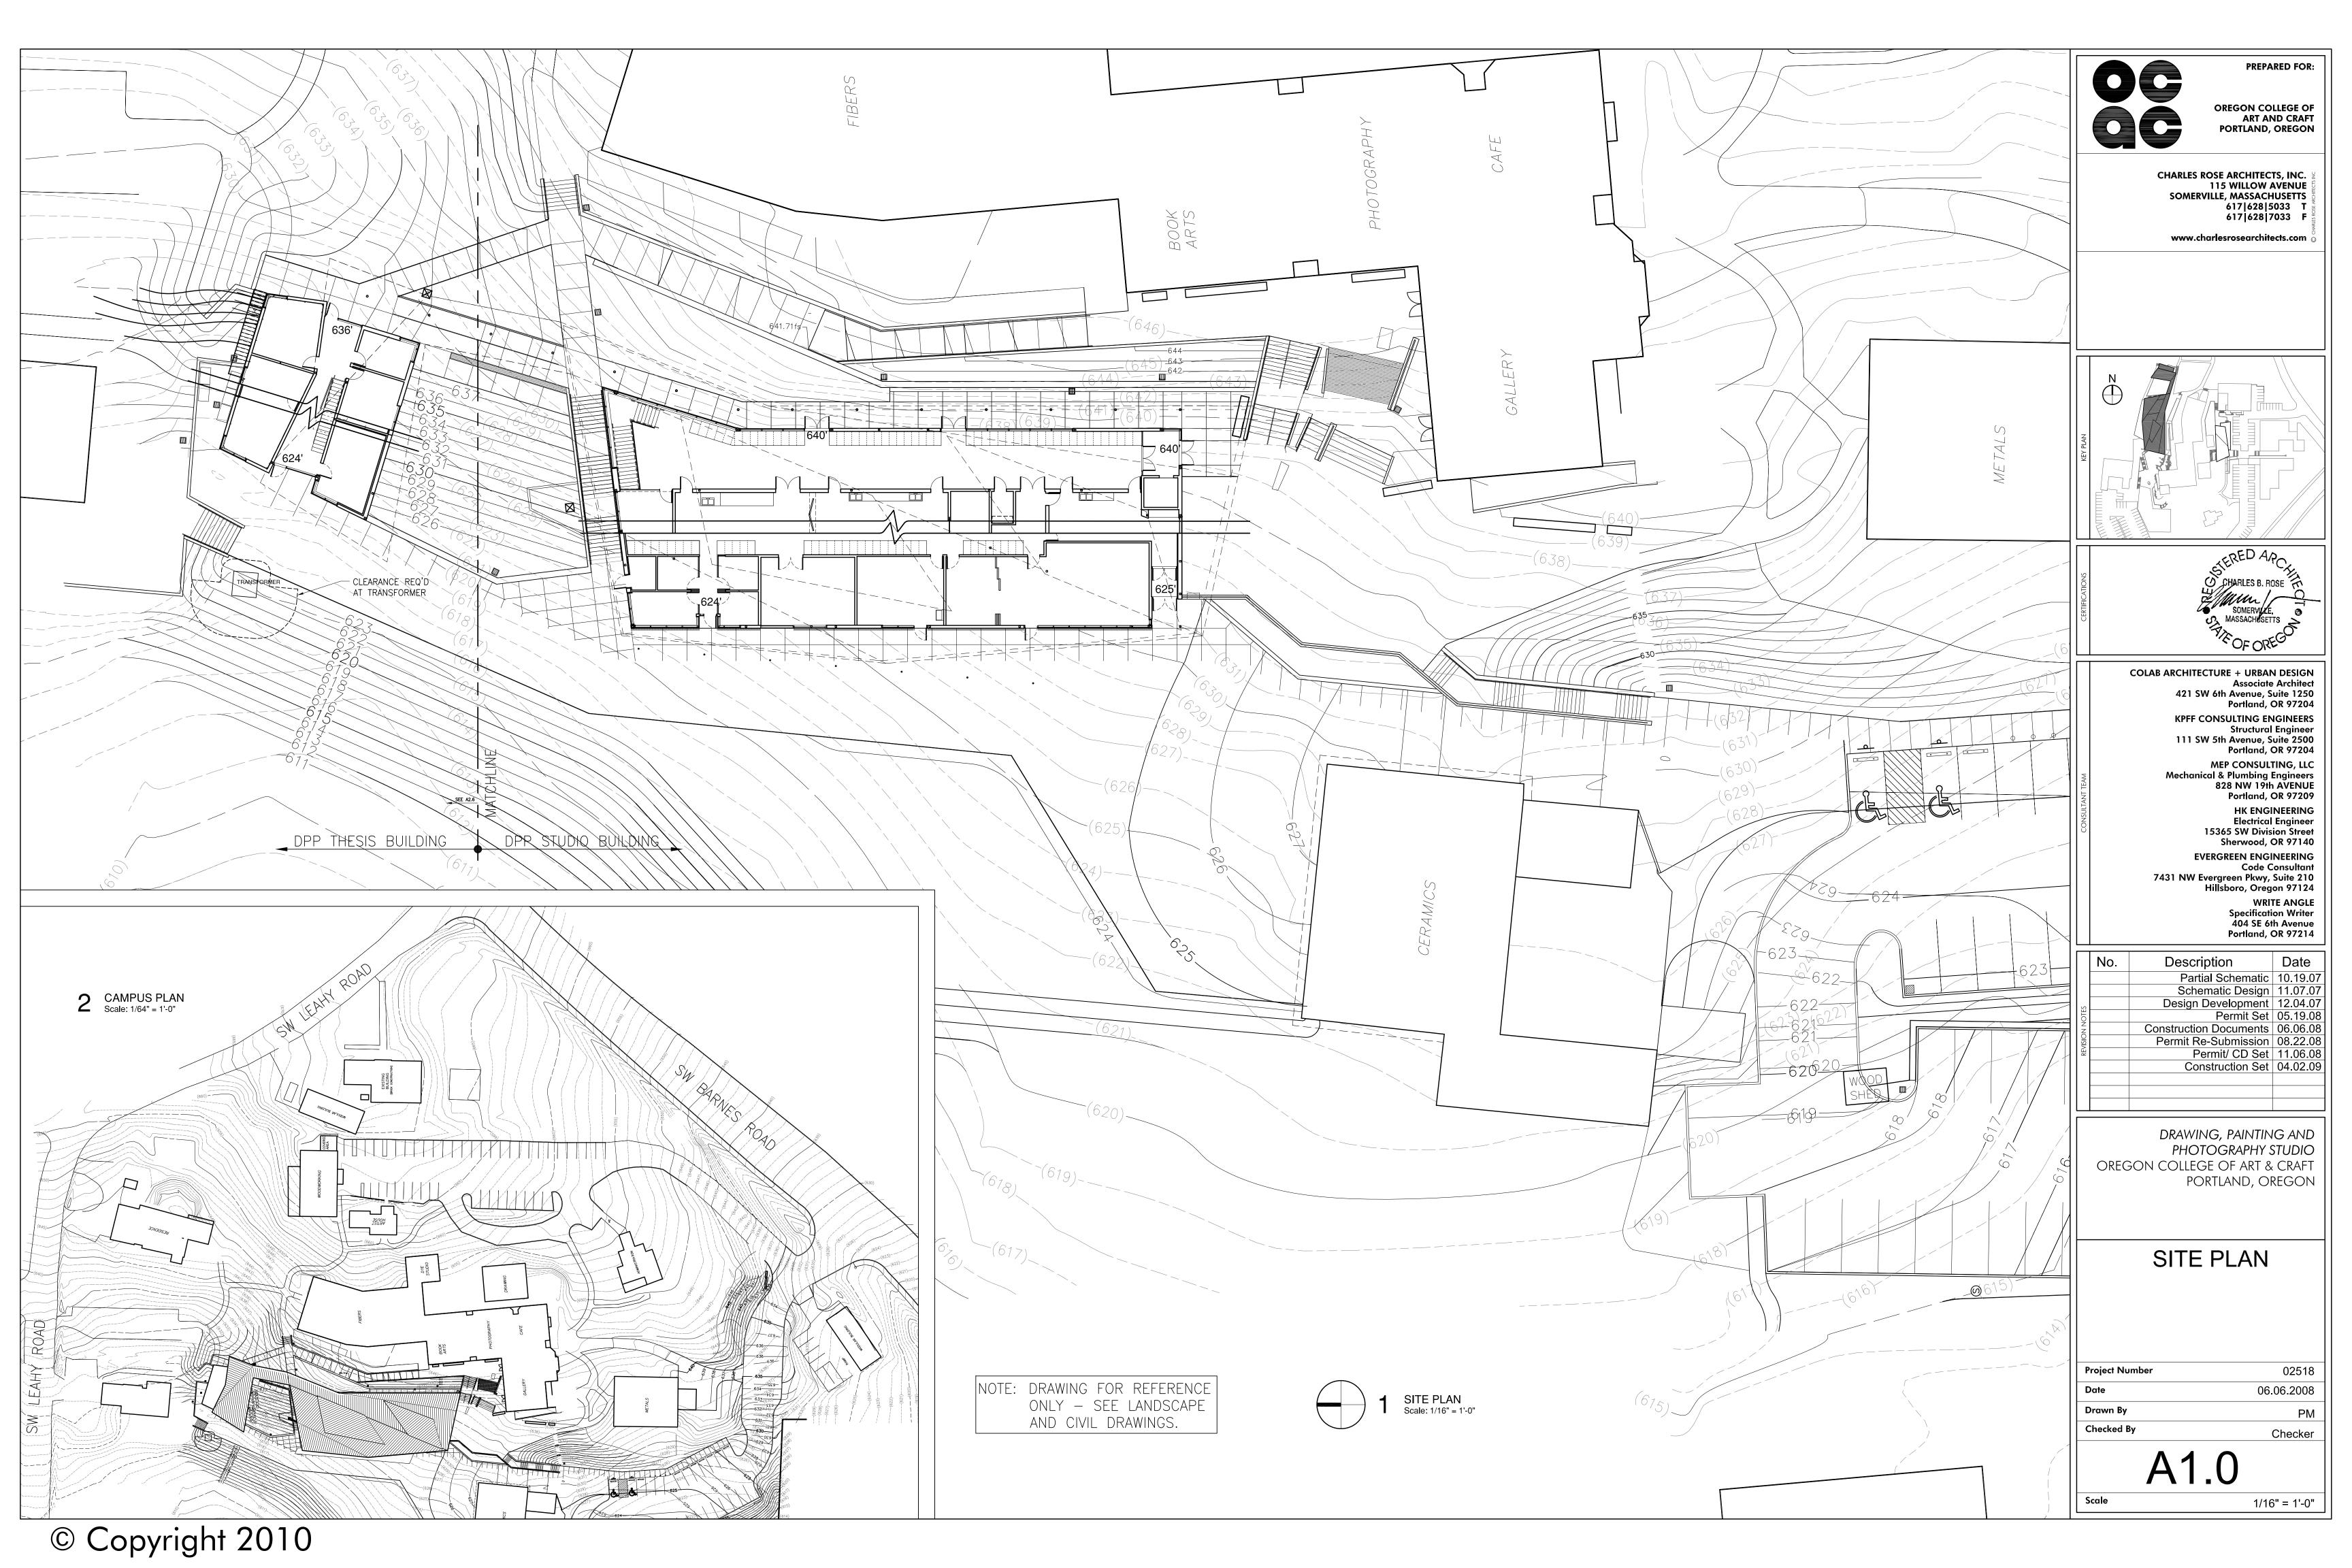


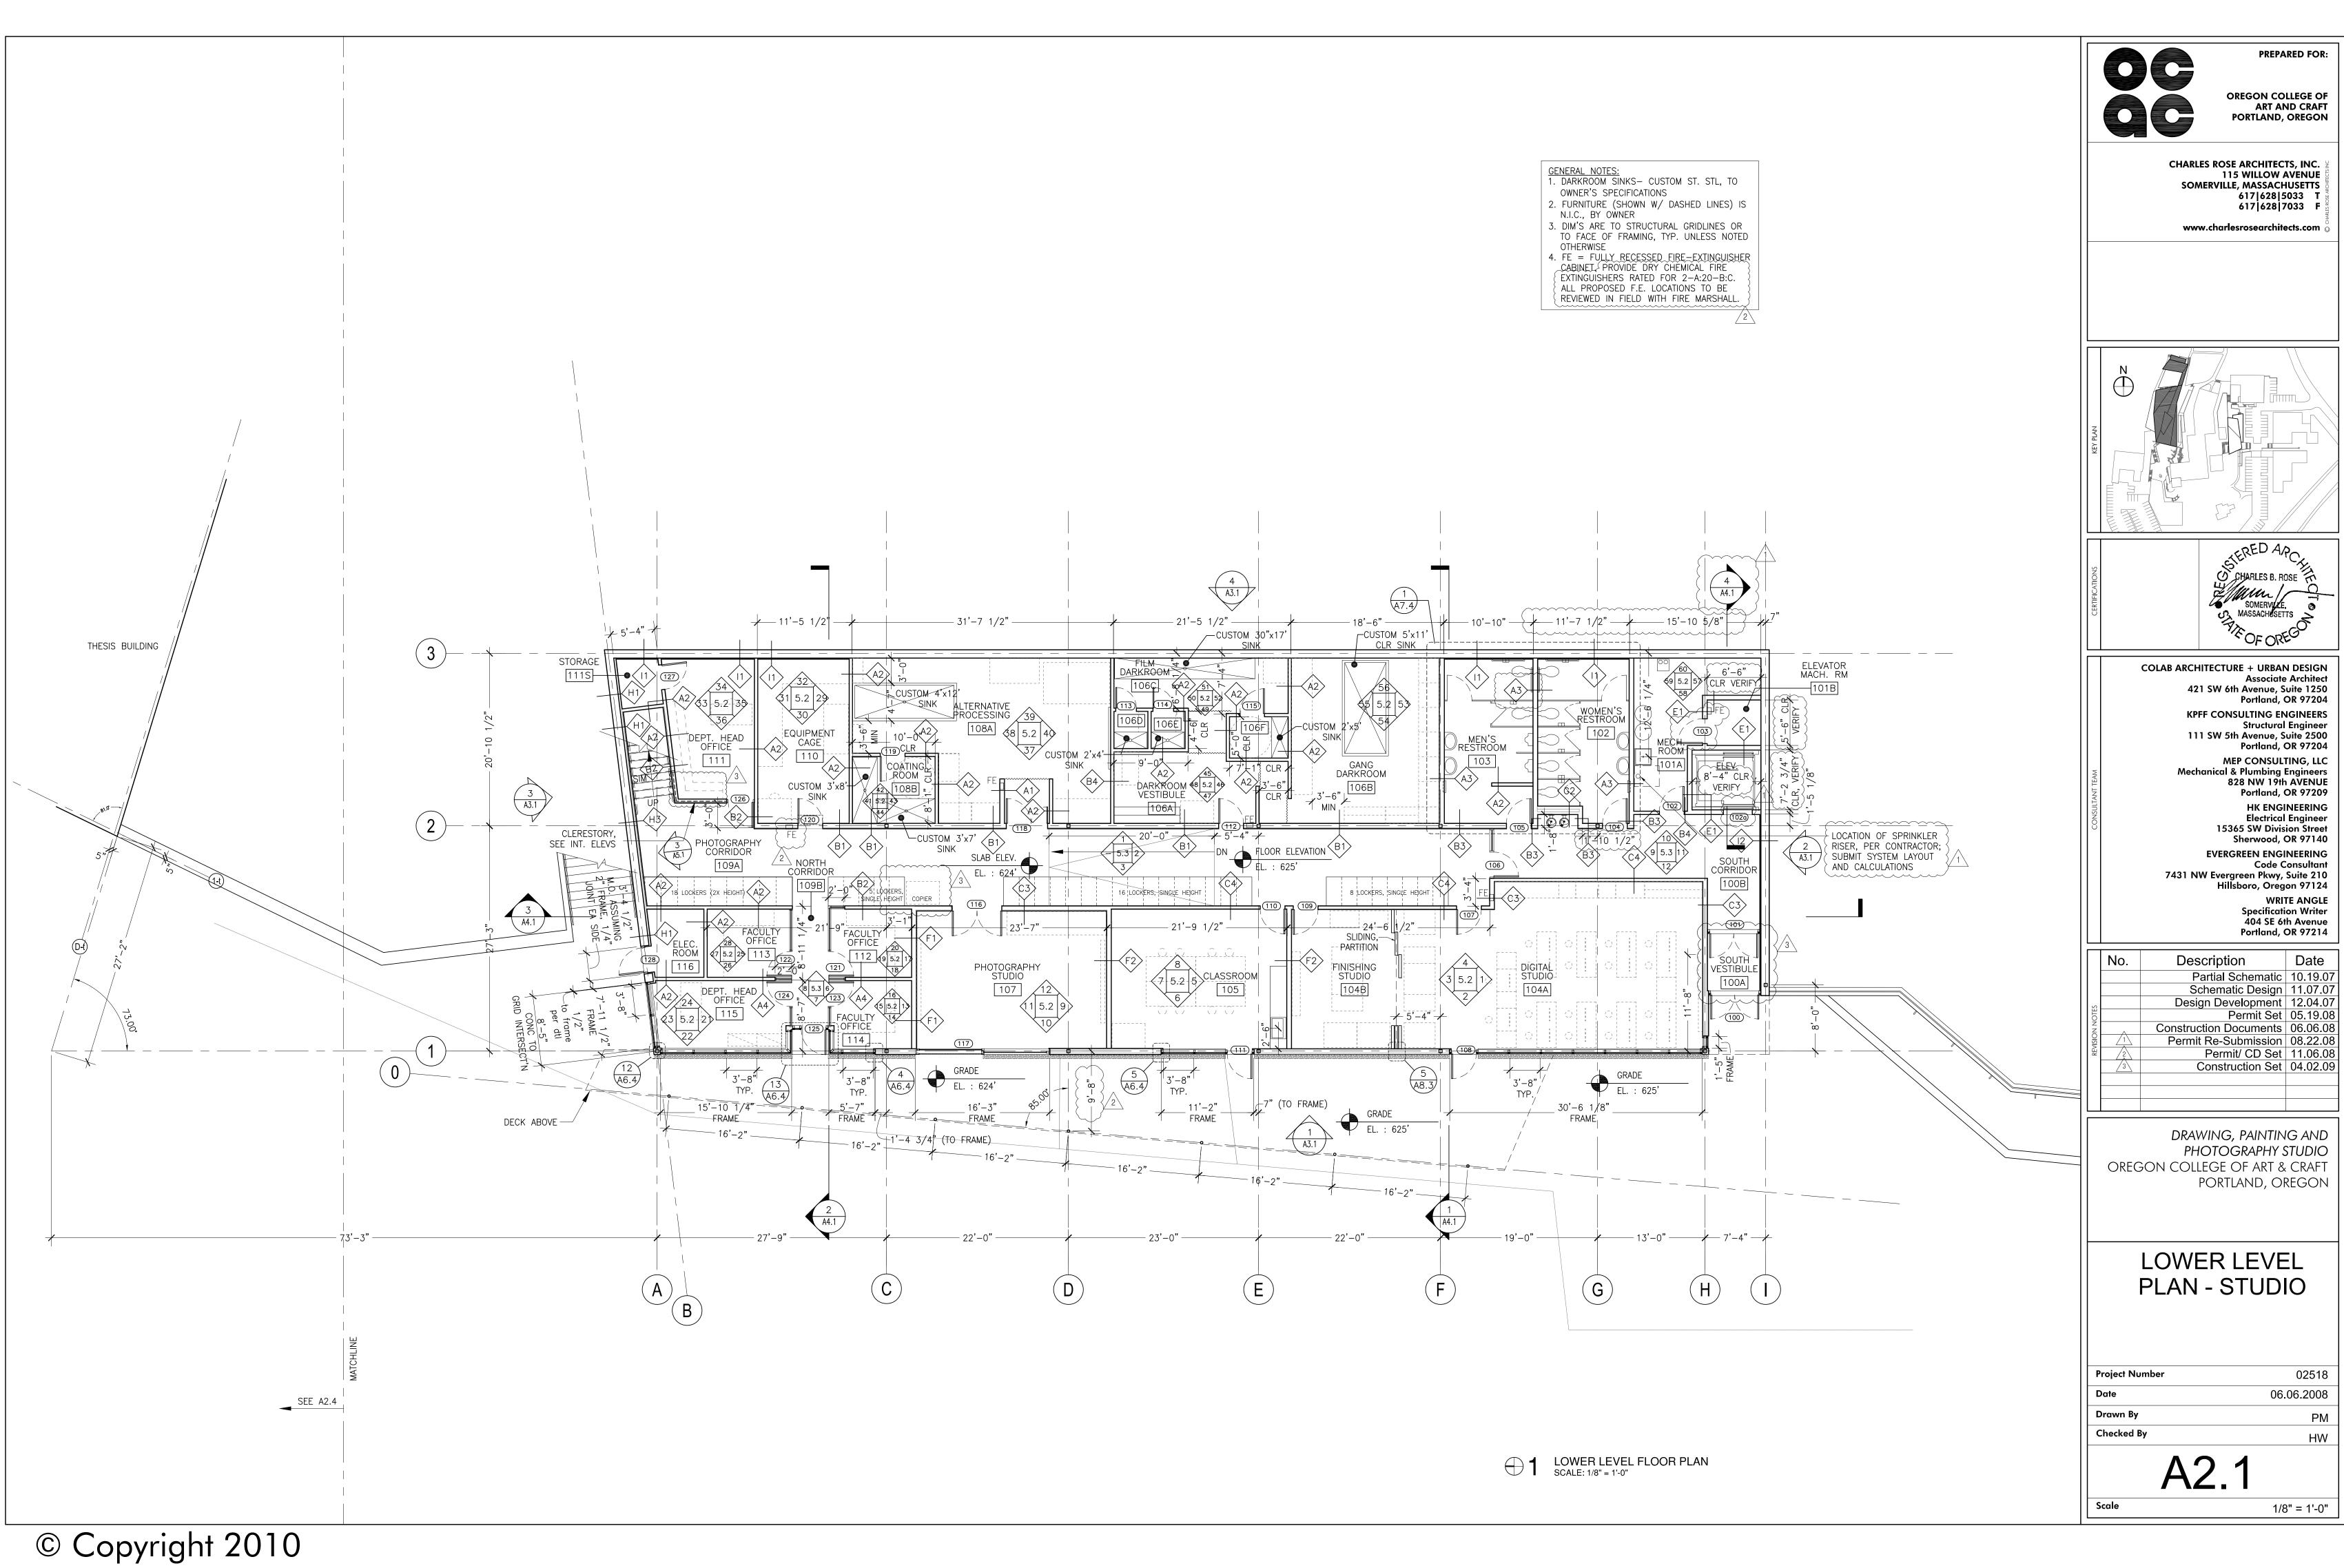


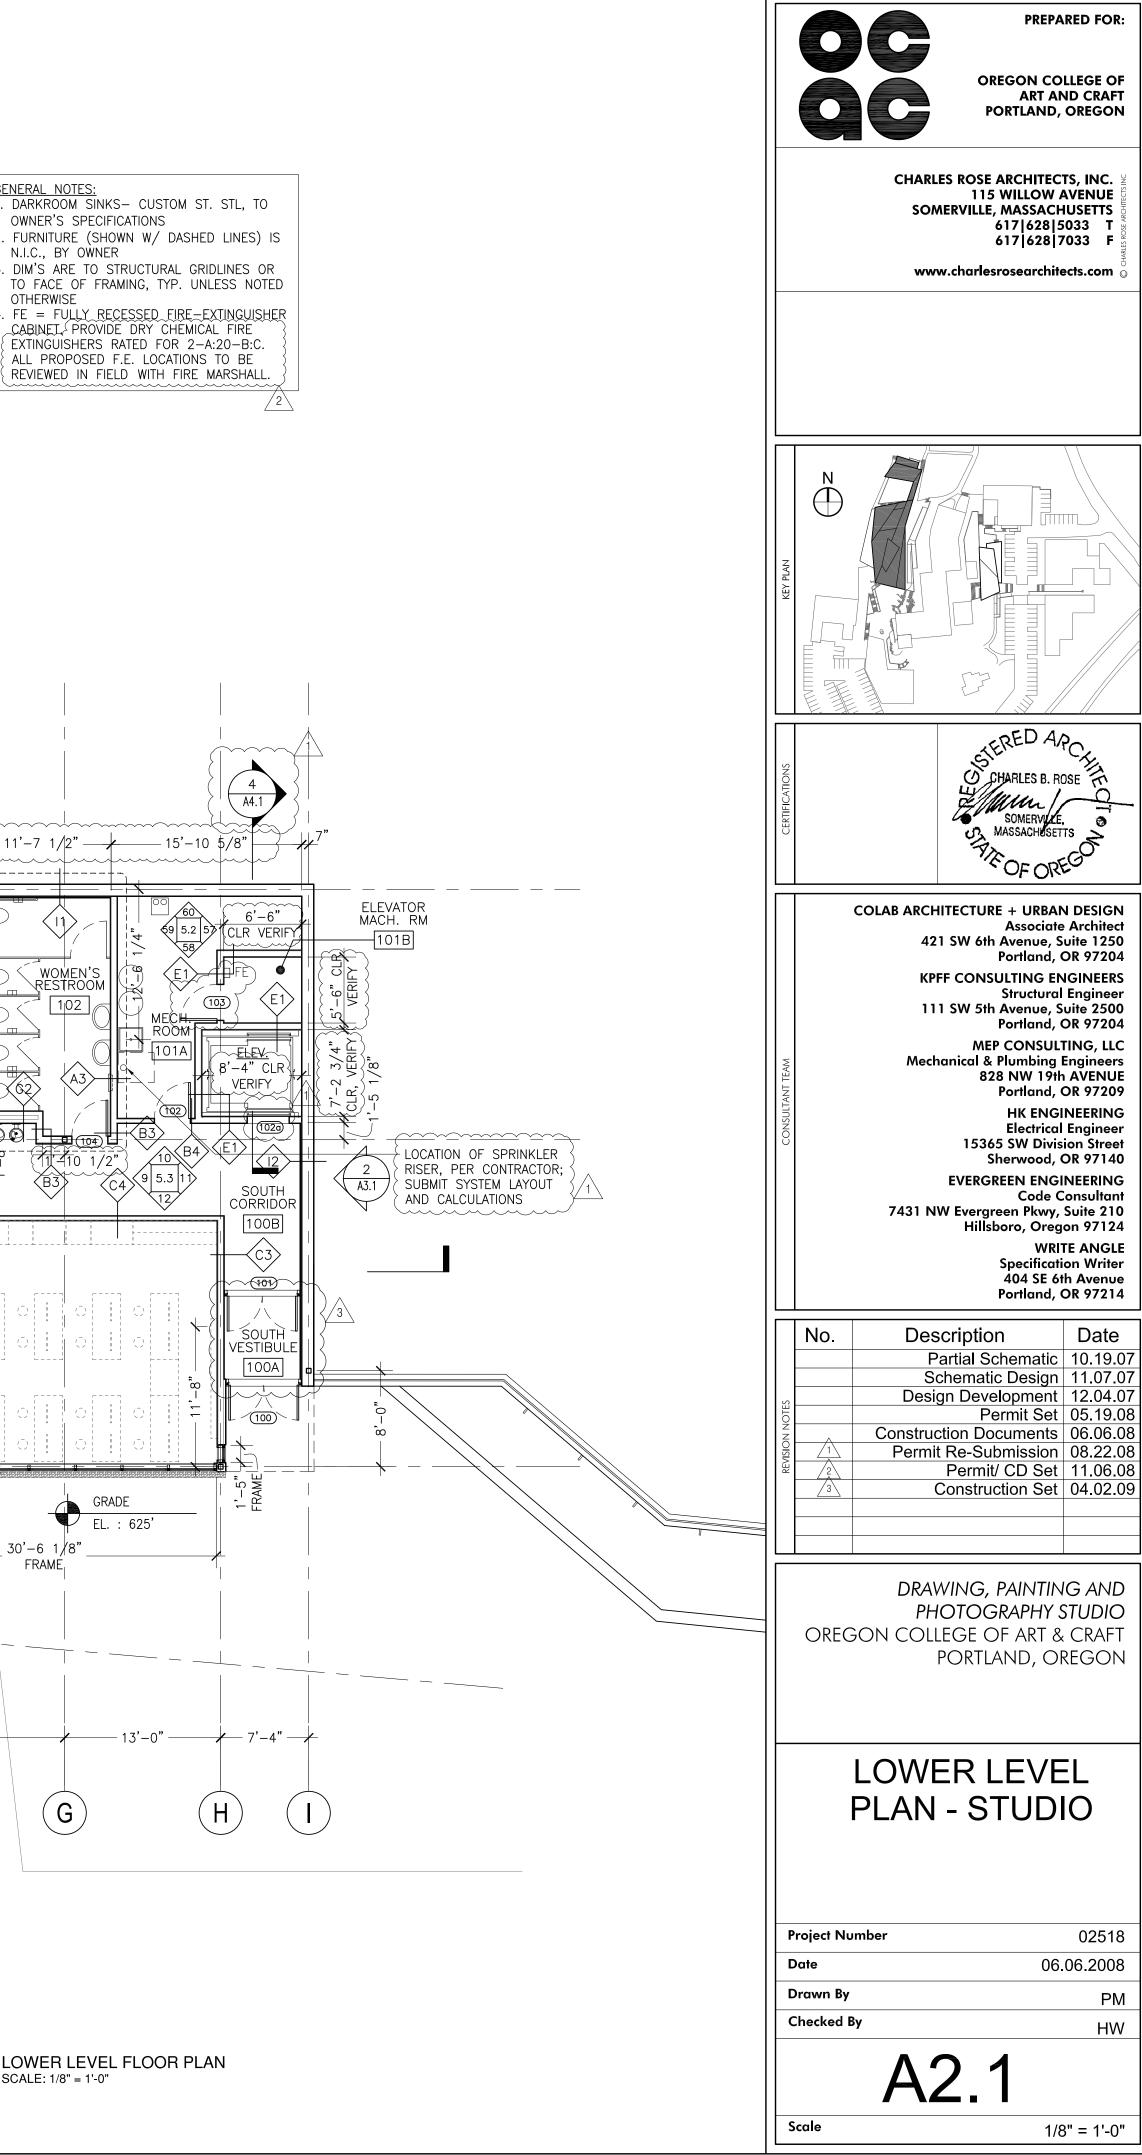

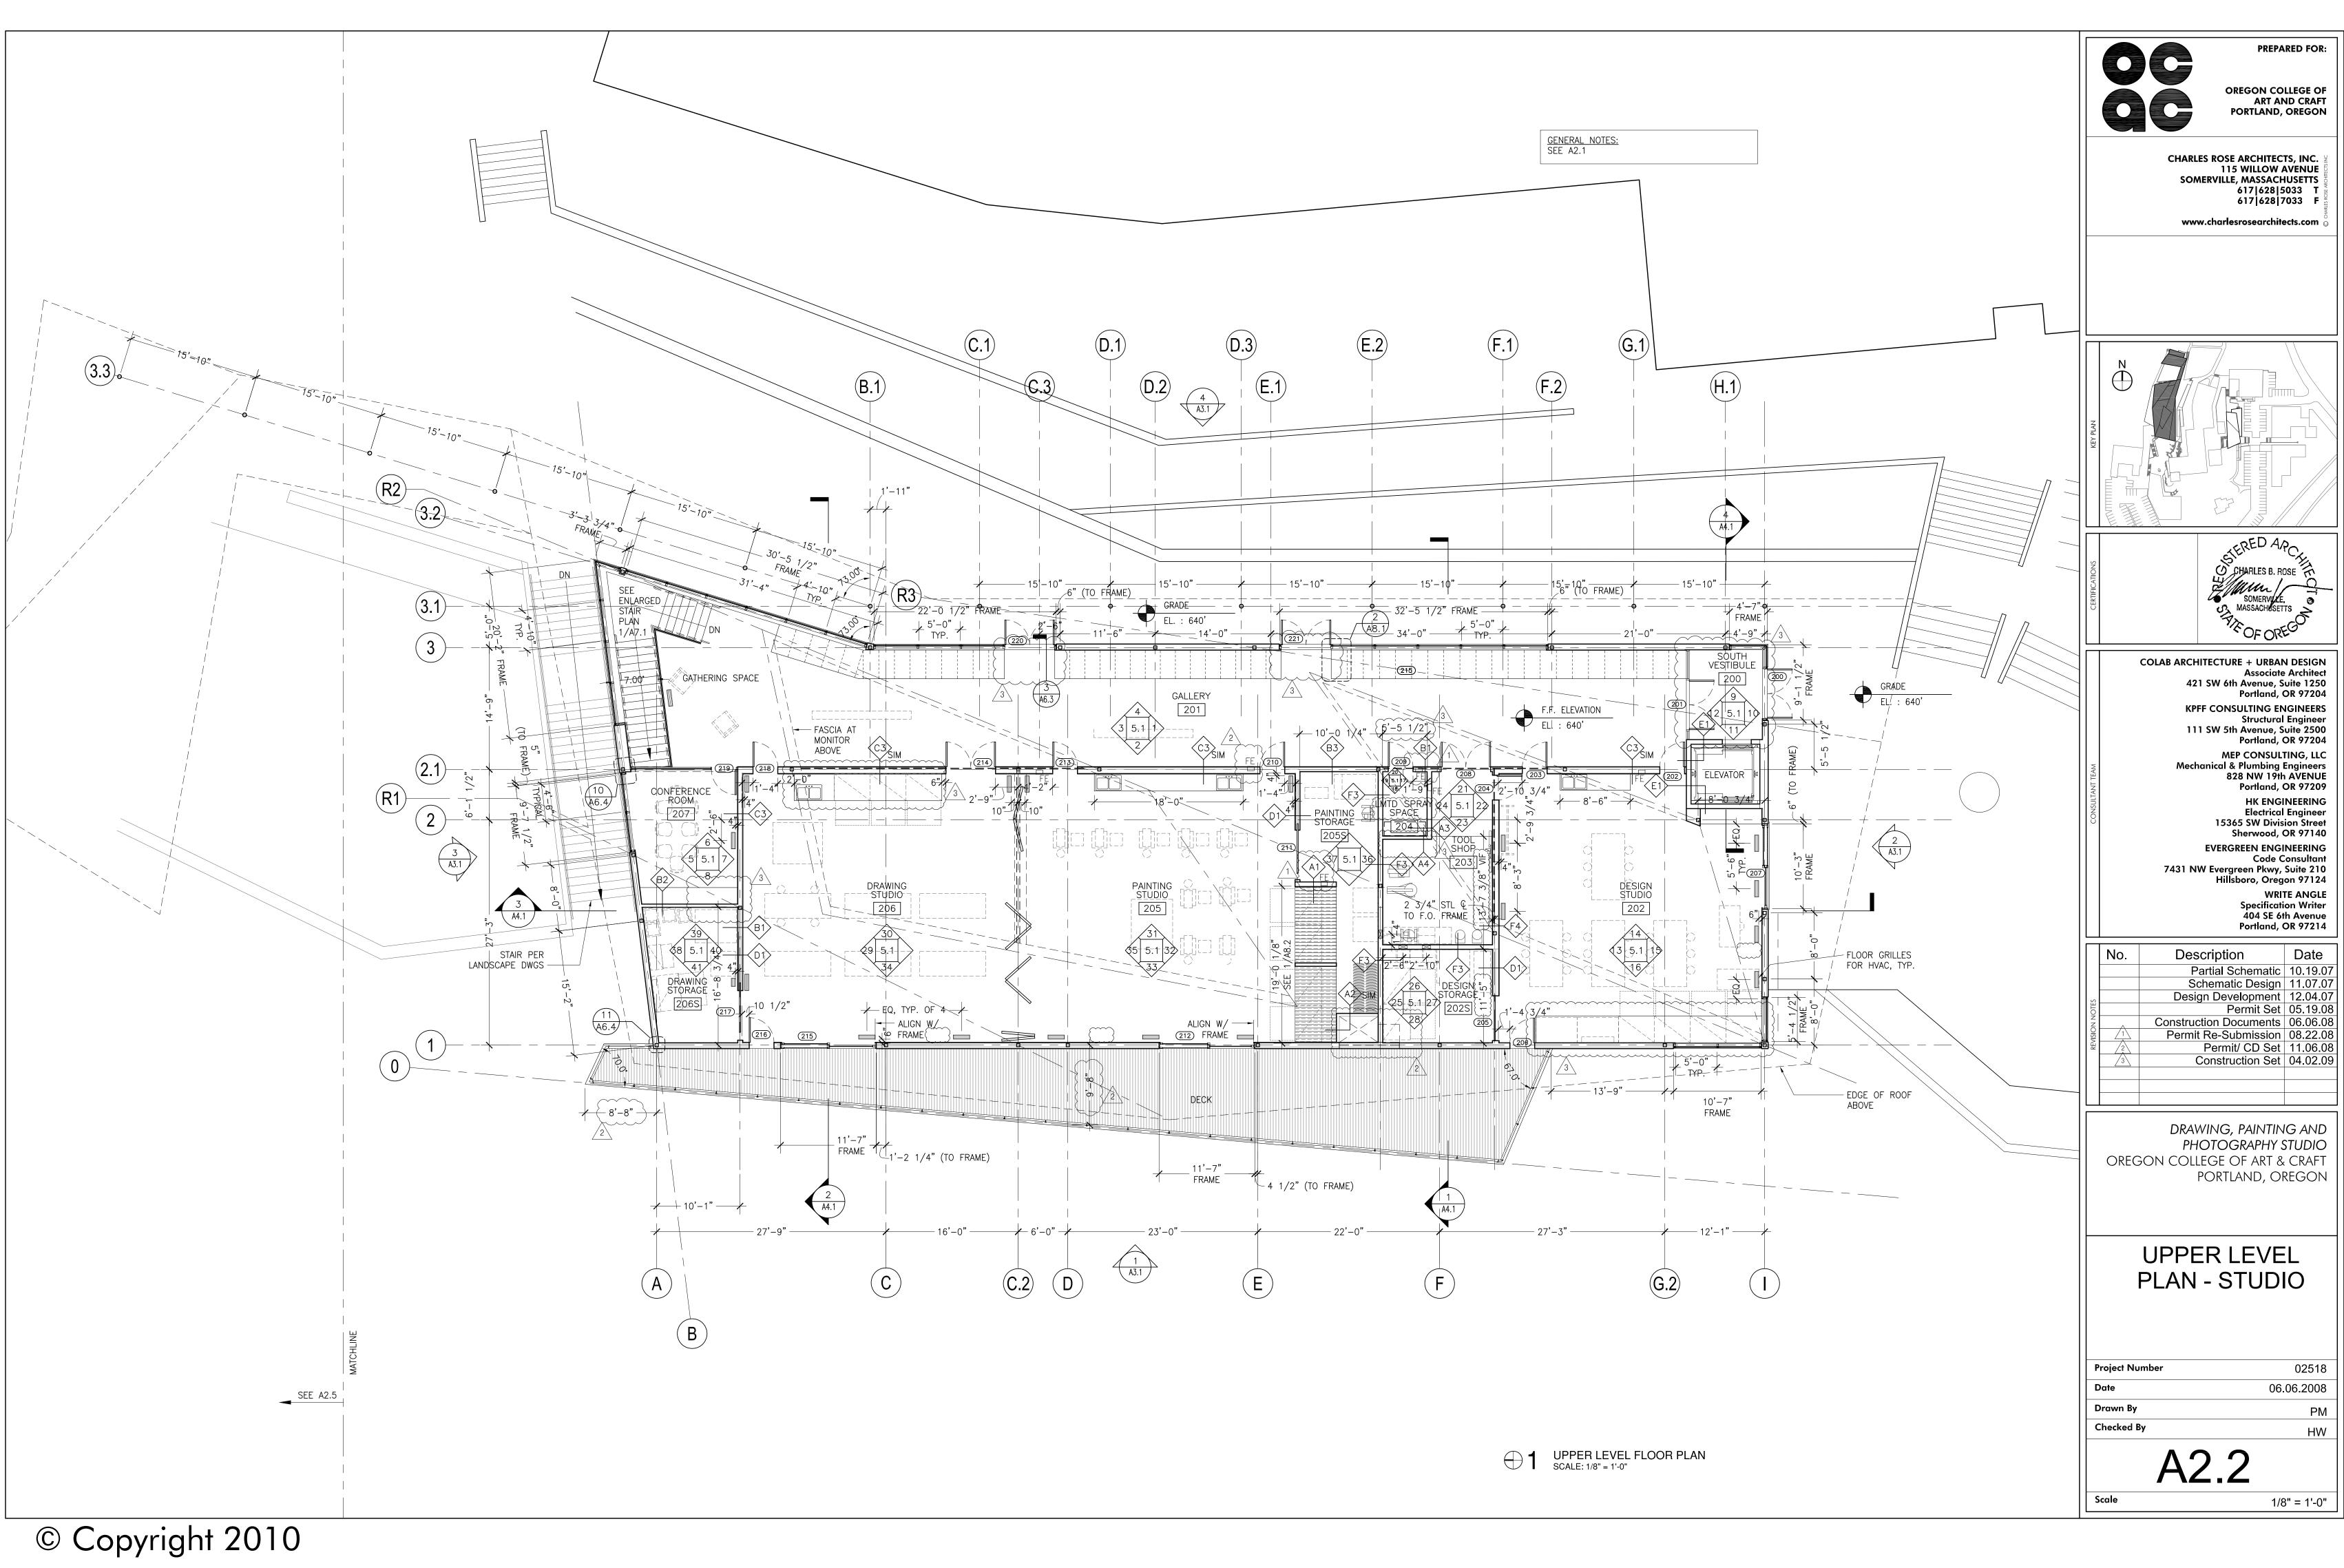

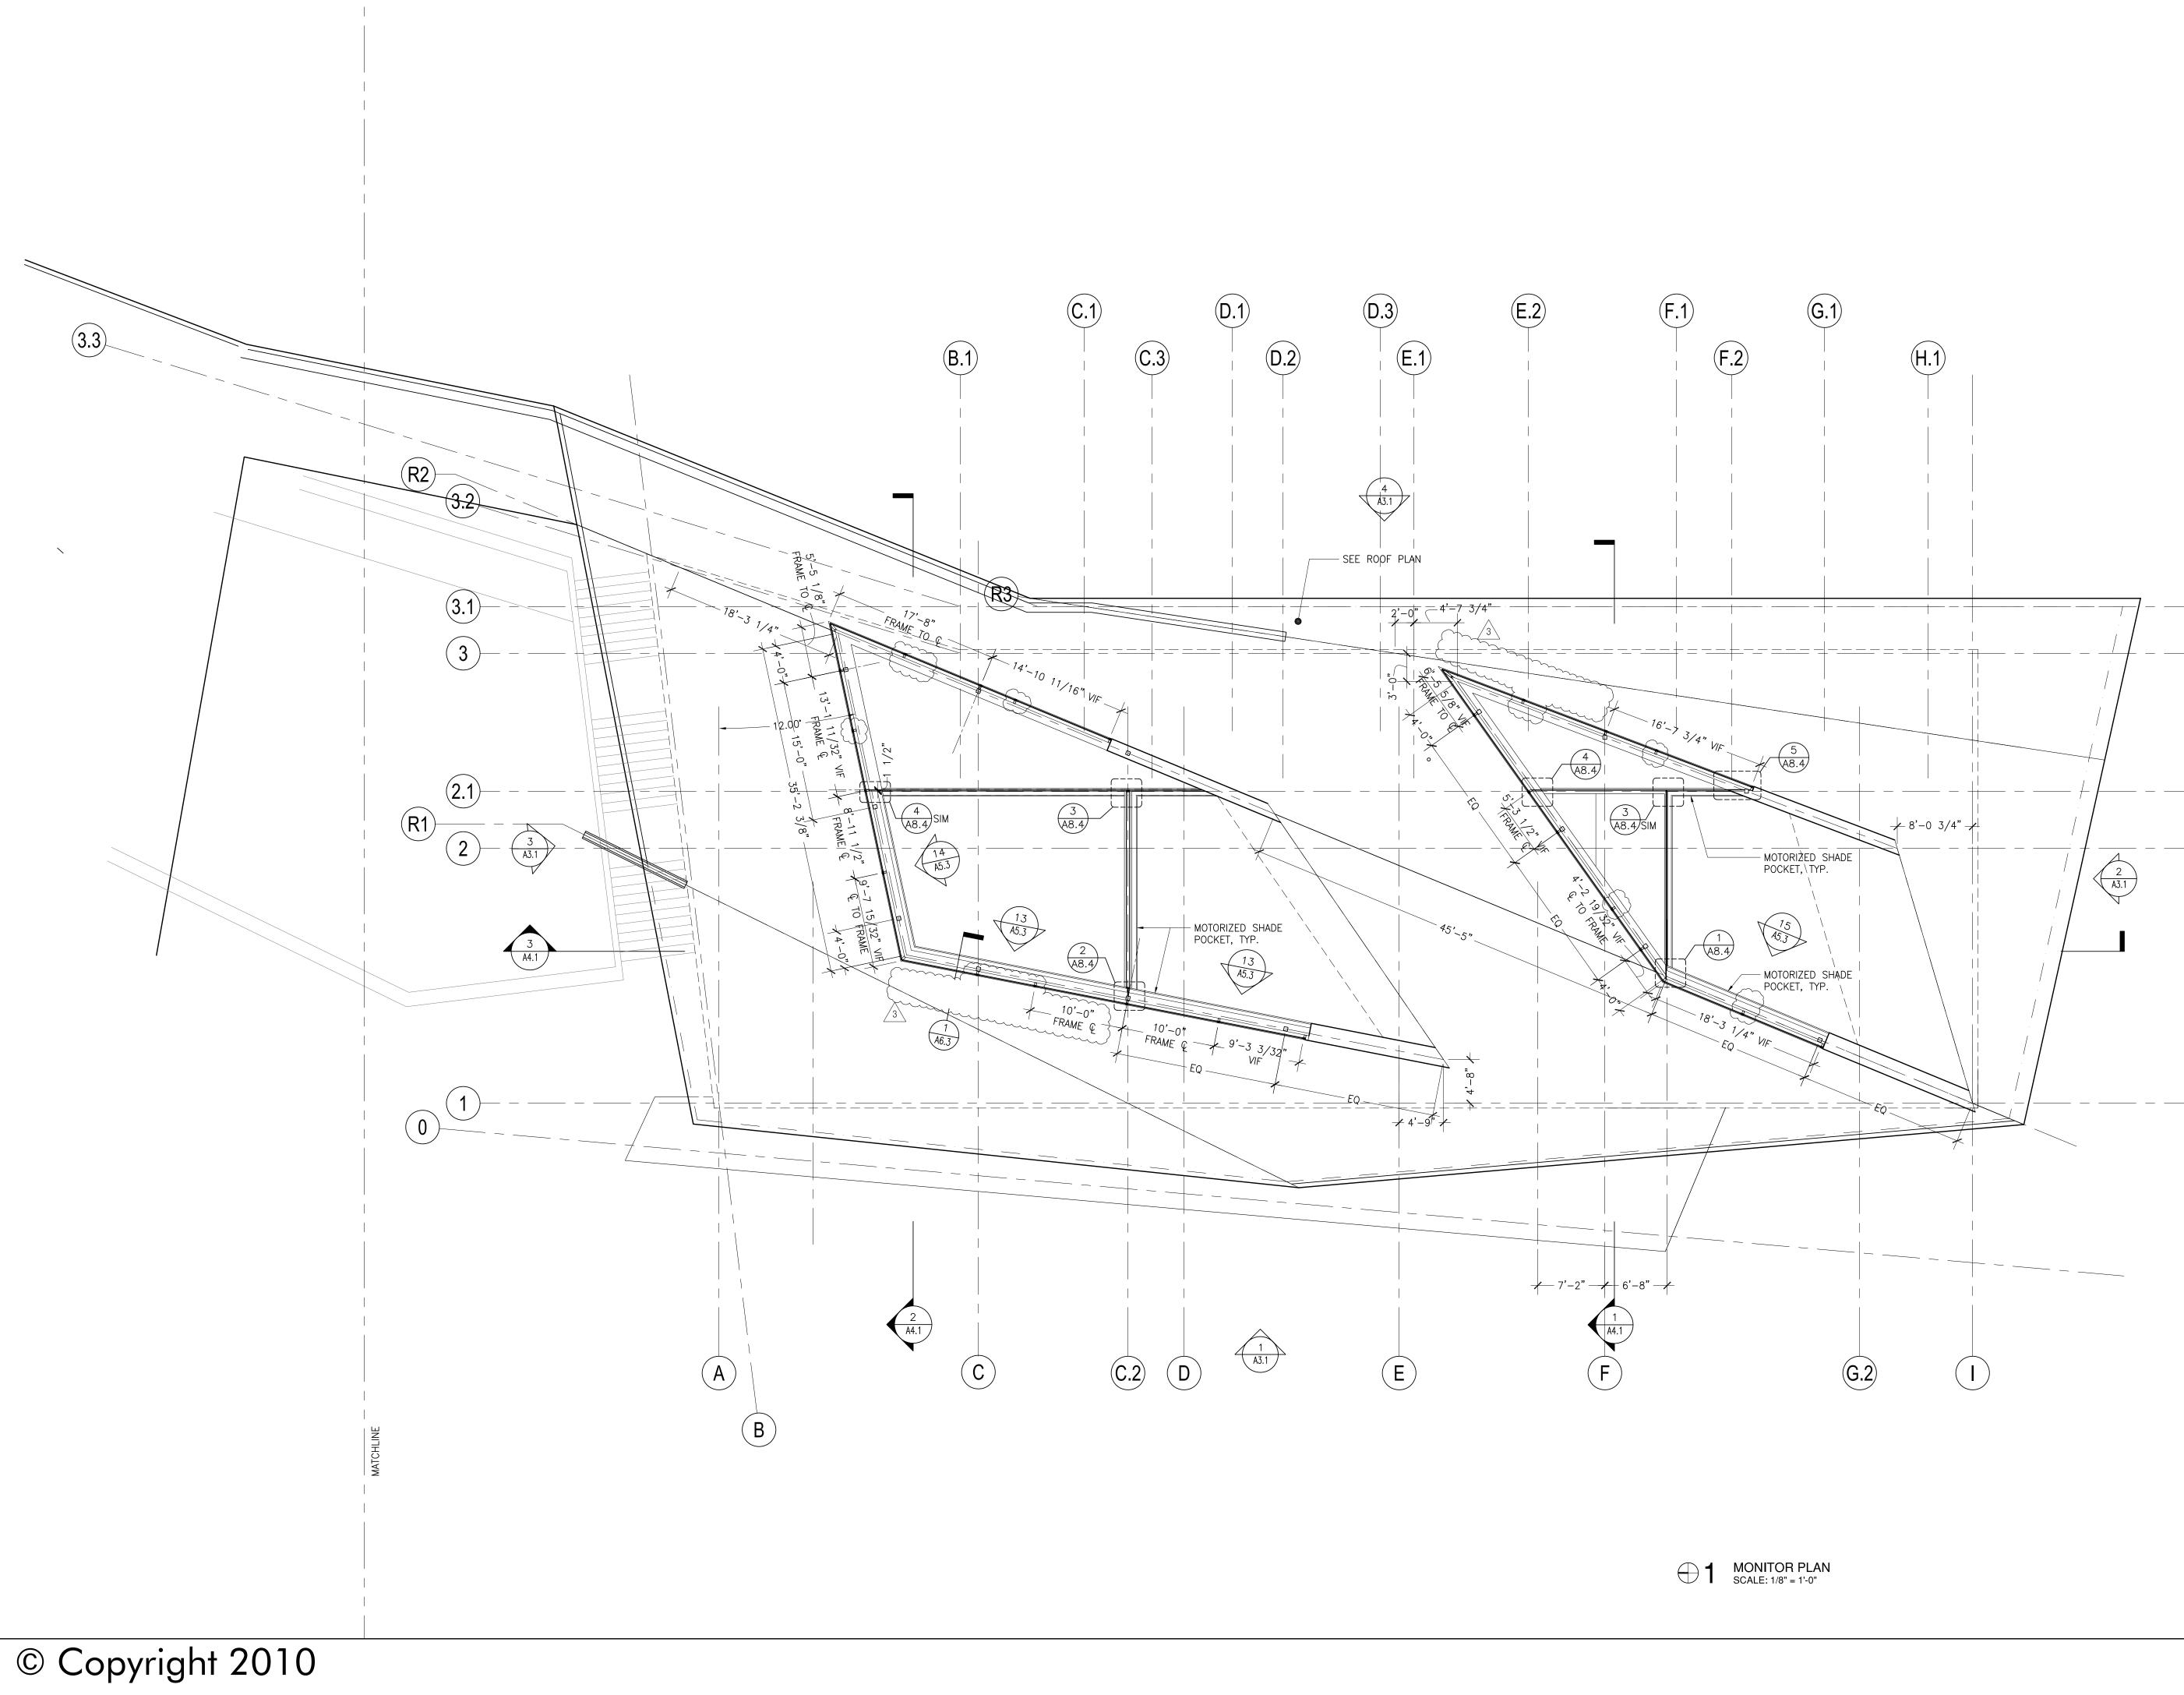


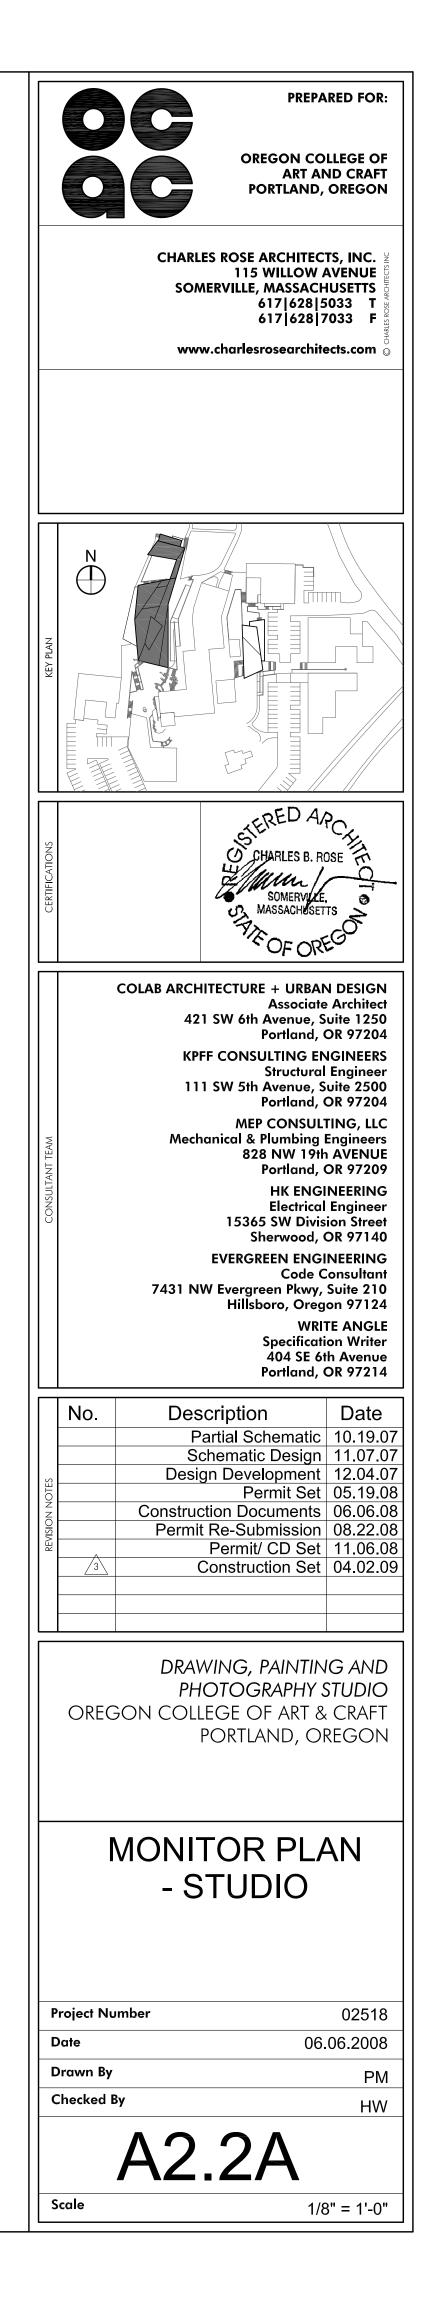

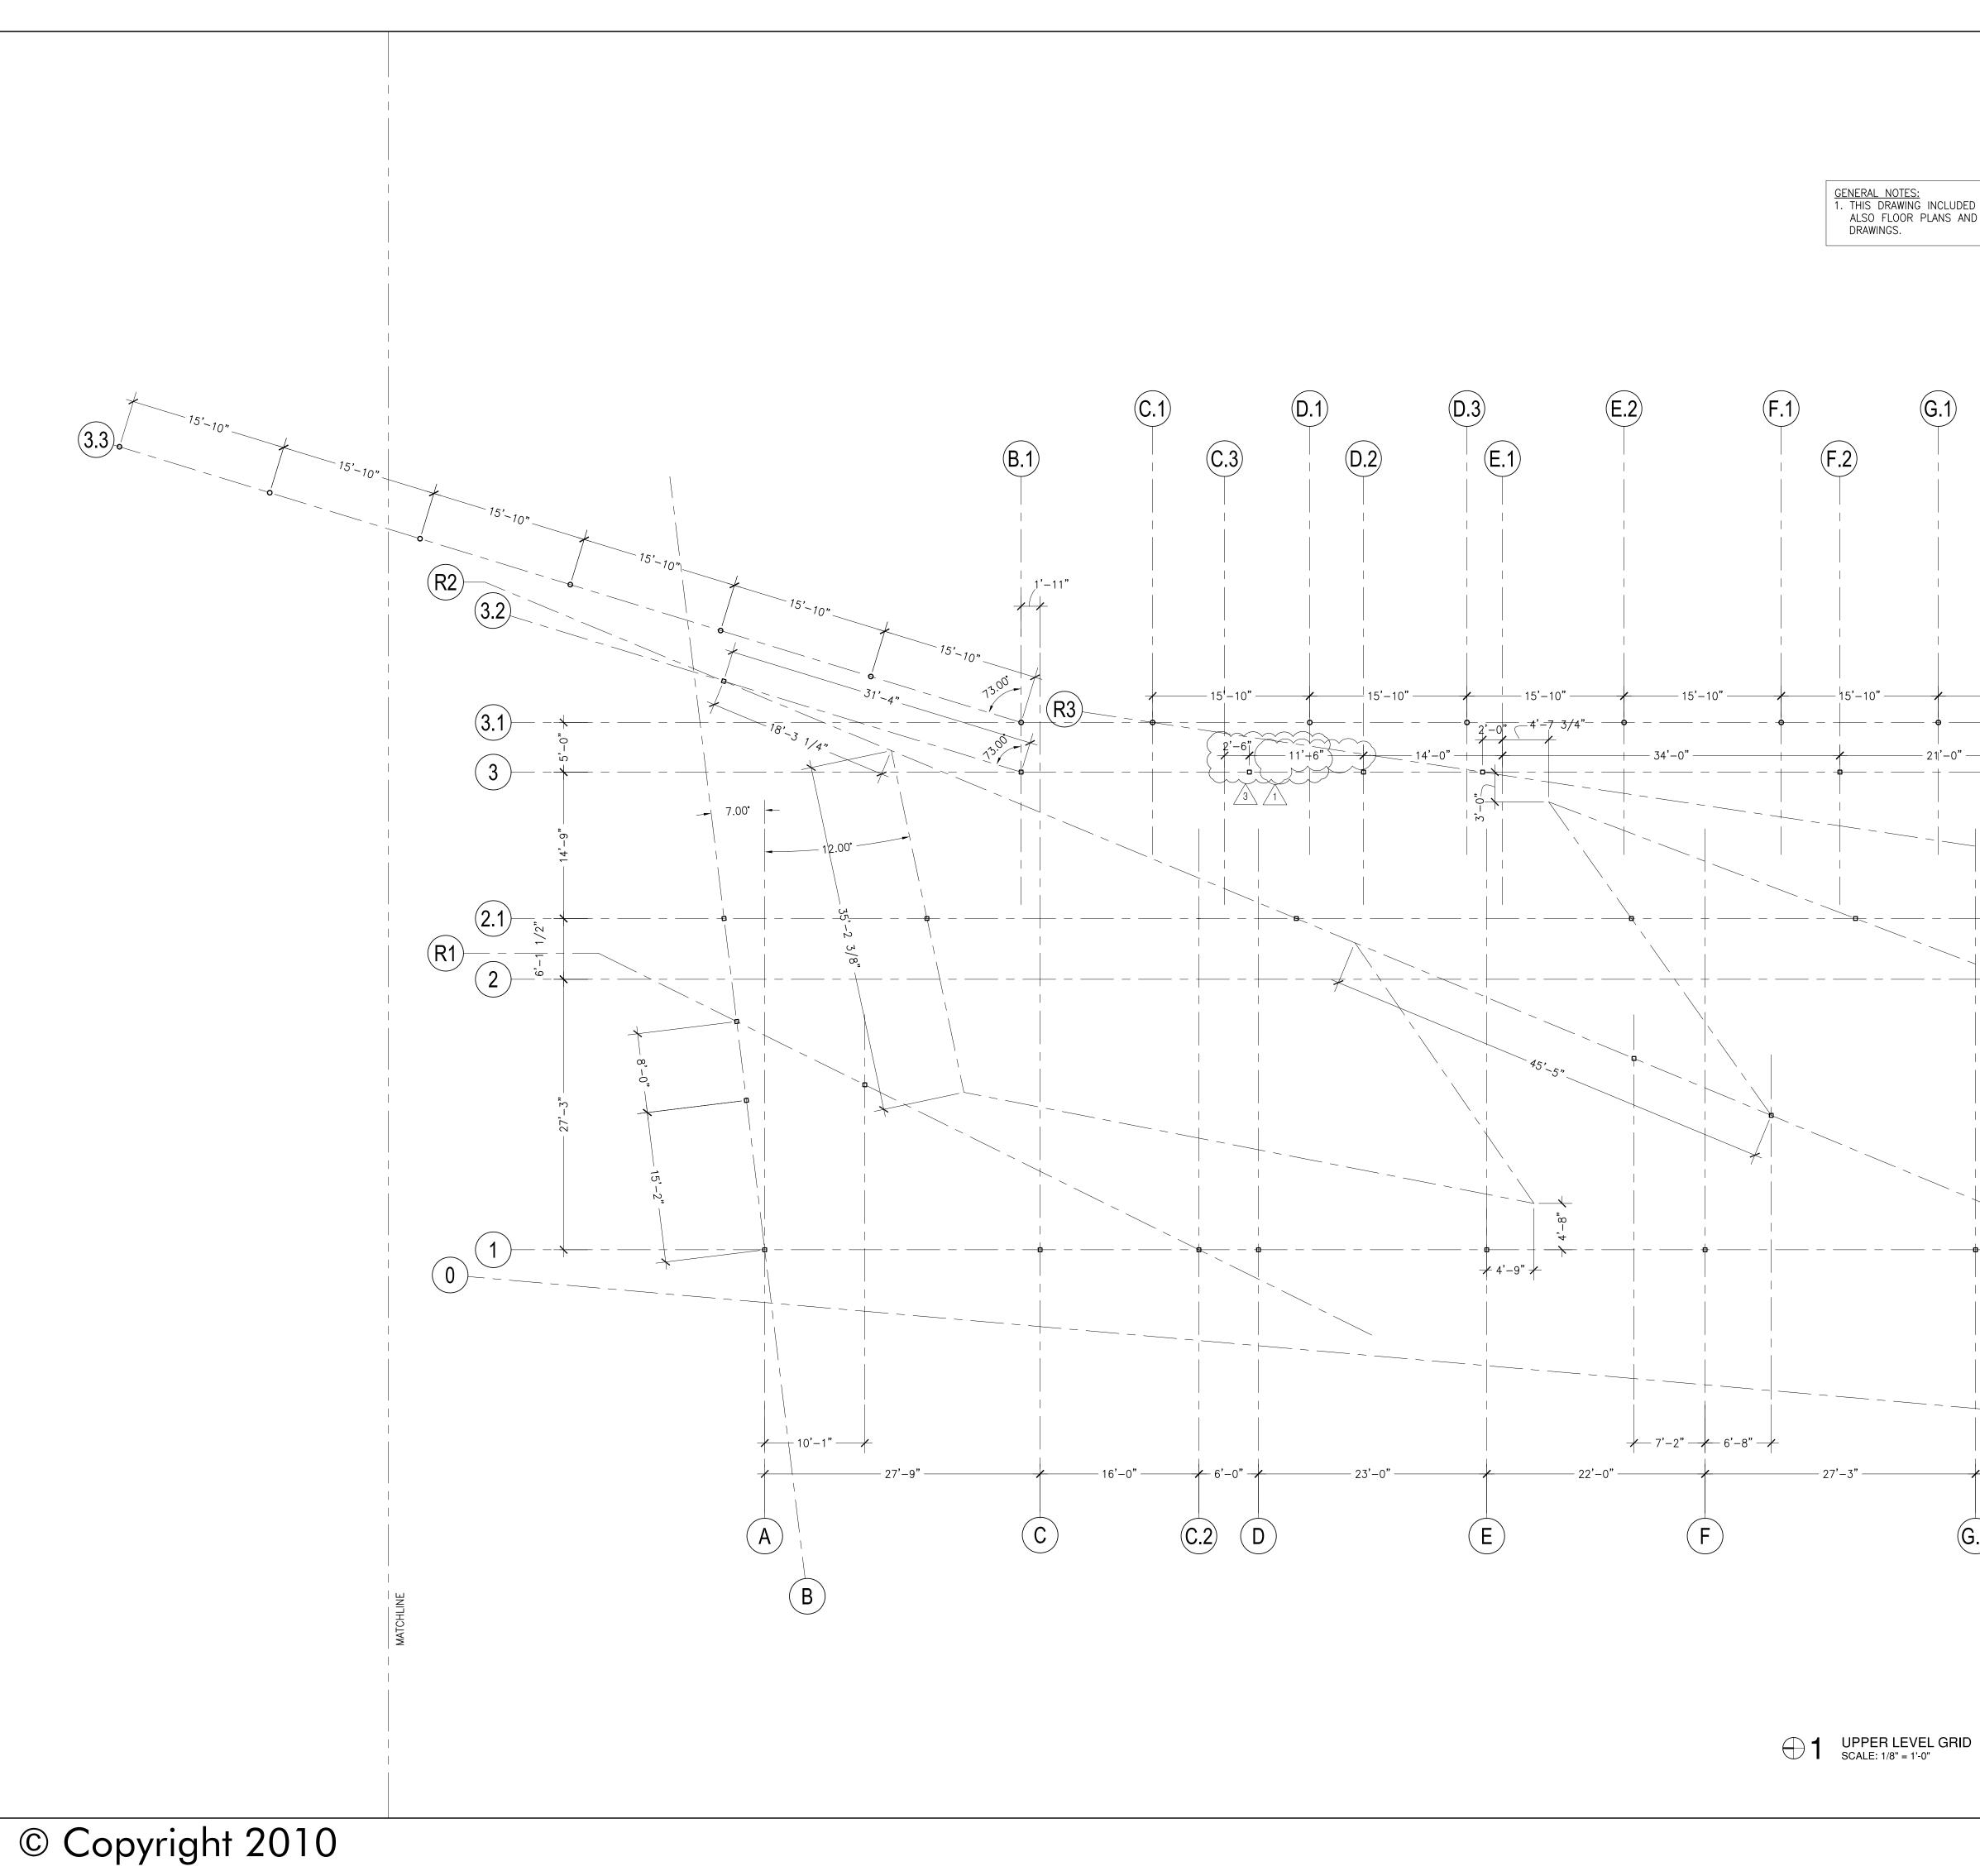

GENERAL NOTES: 1. THIS DRAWING INCLUDED FOR CLARITY. SEE ALSO FLOOR PLANS AND STRUCTURAL


_____ 15**'**—10" -

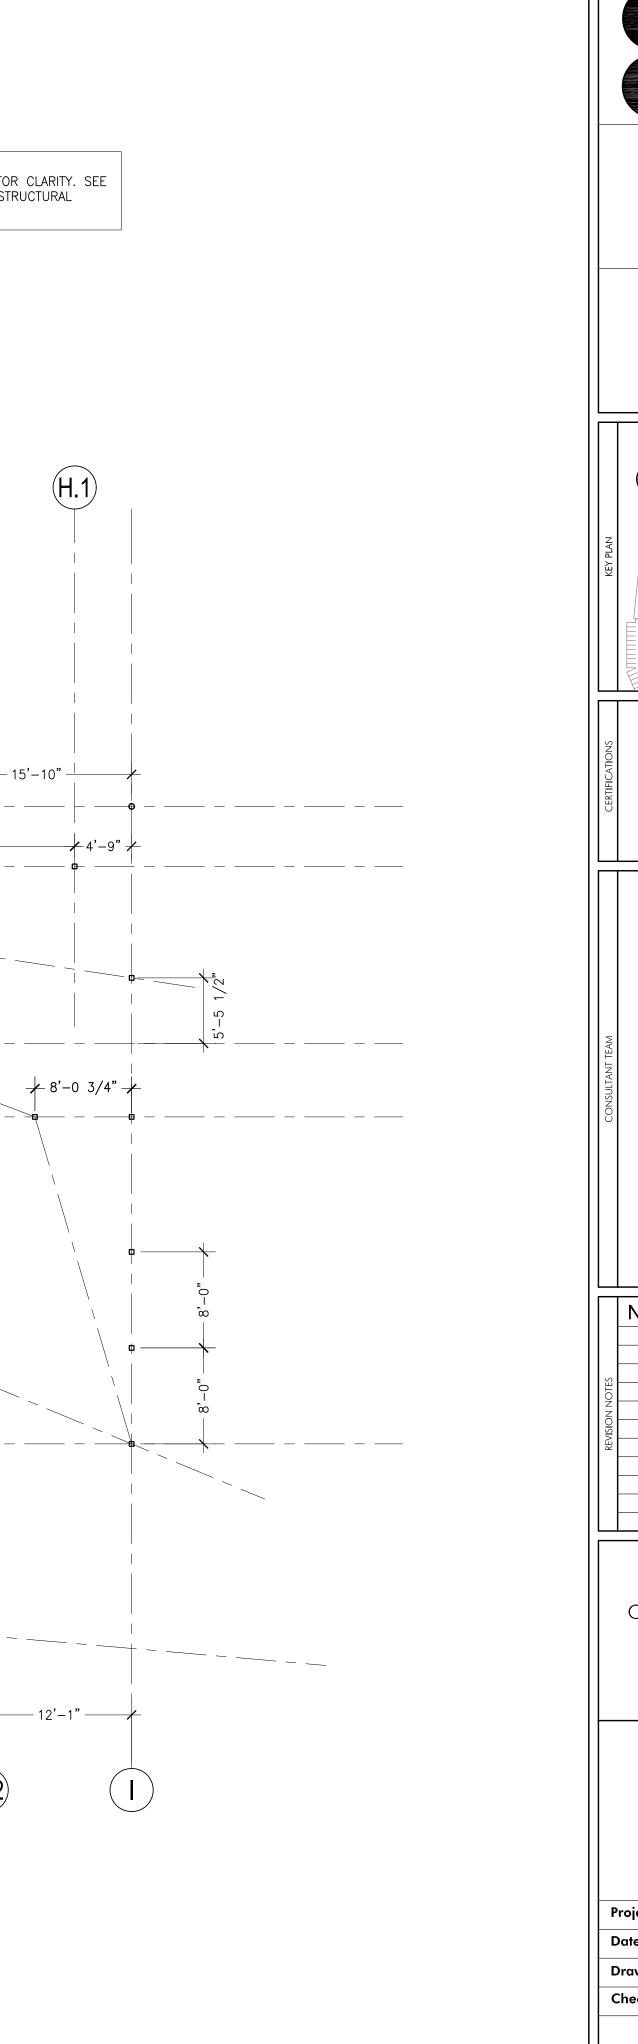






PREPARED FOR:


(G.2)

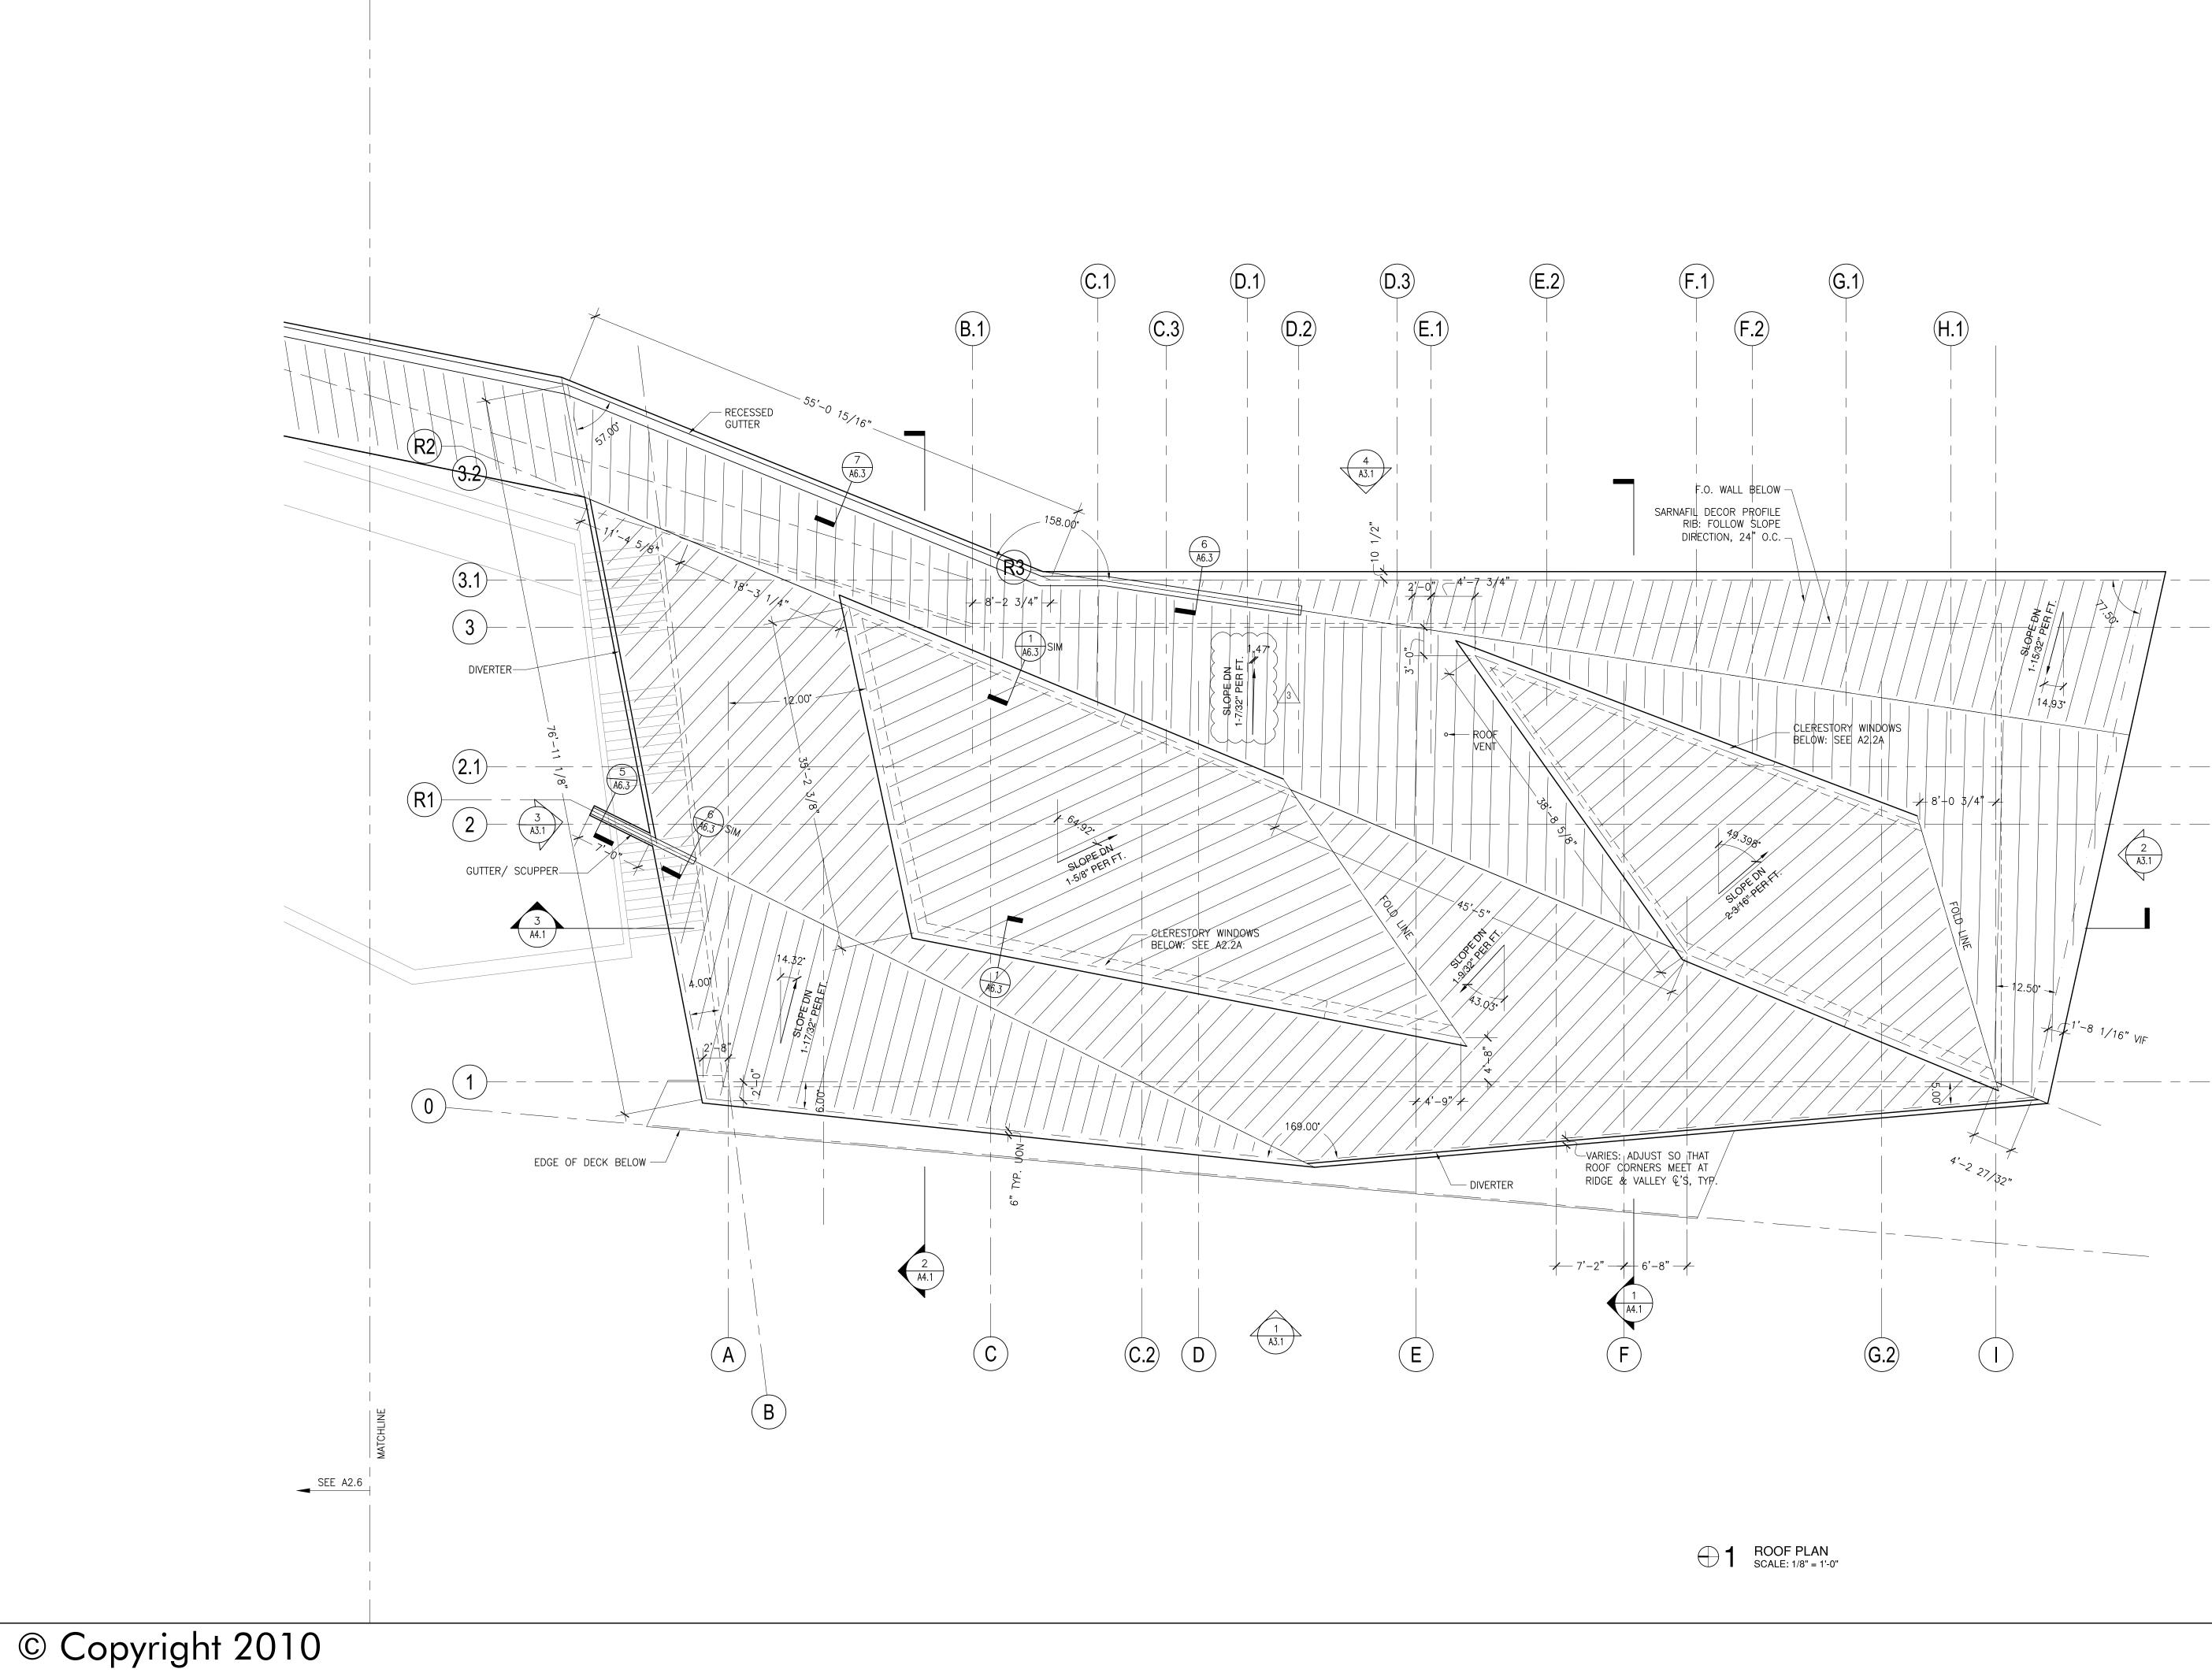


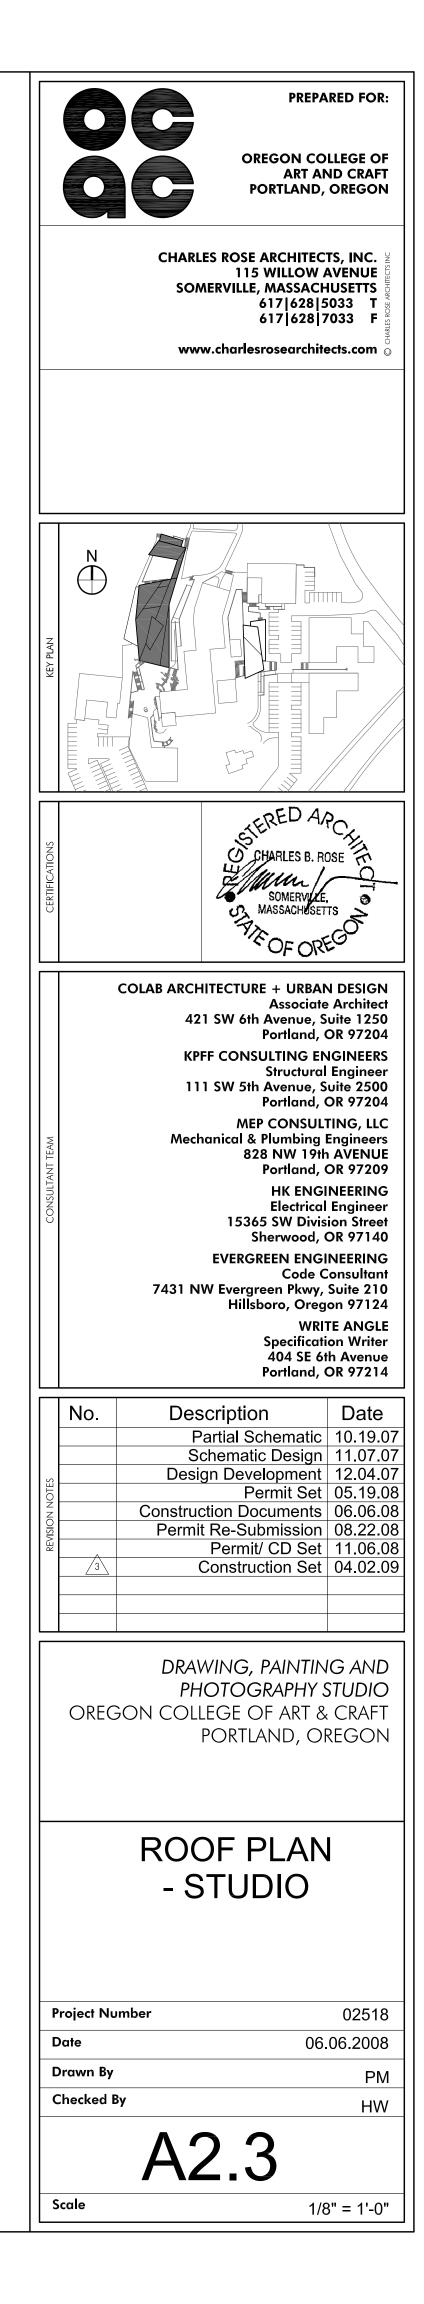


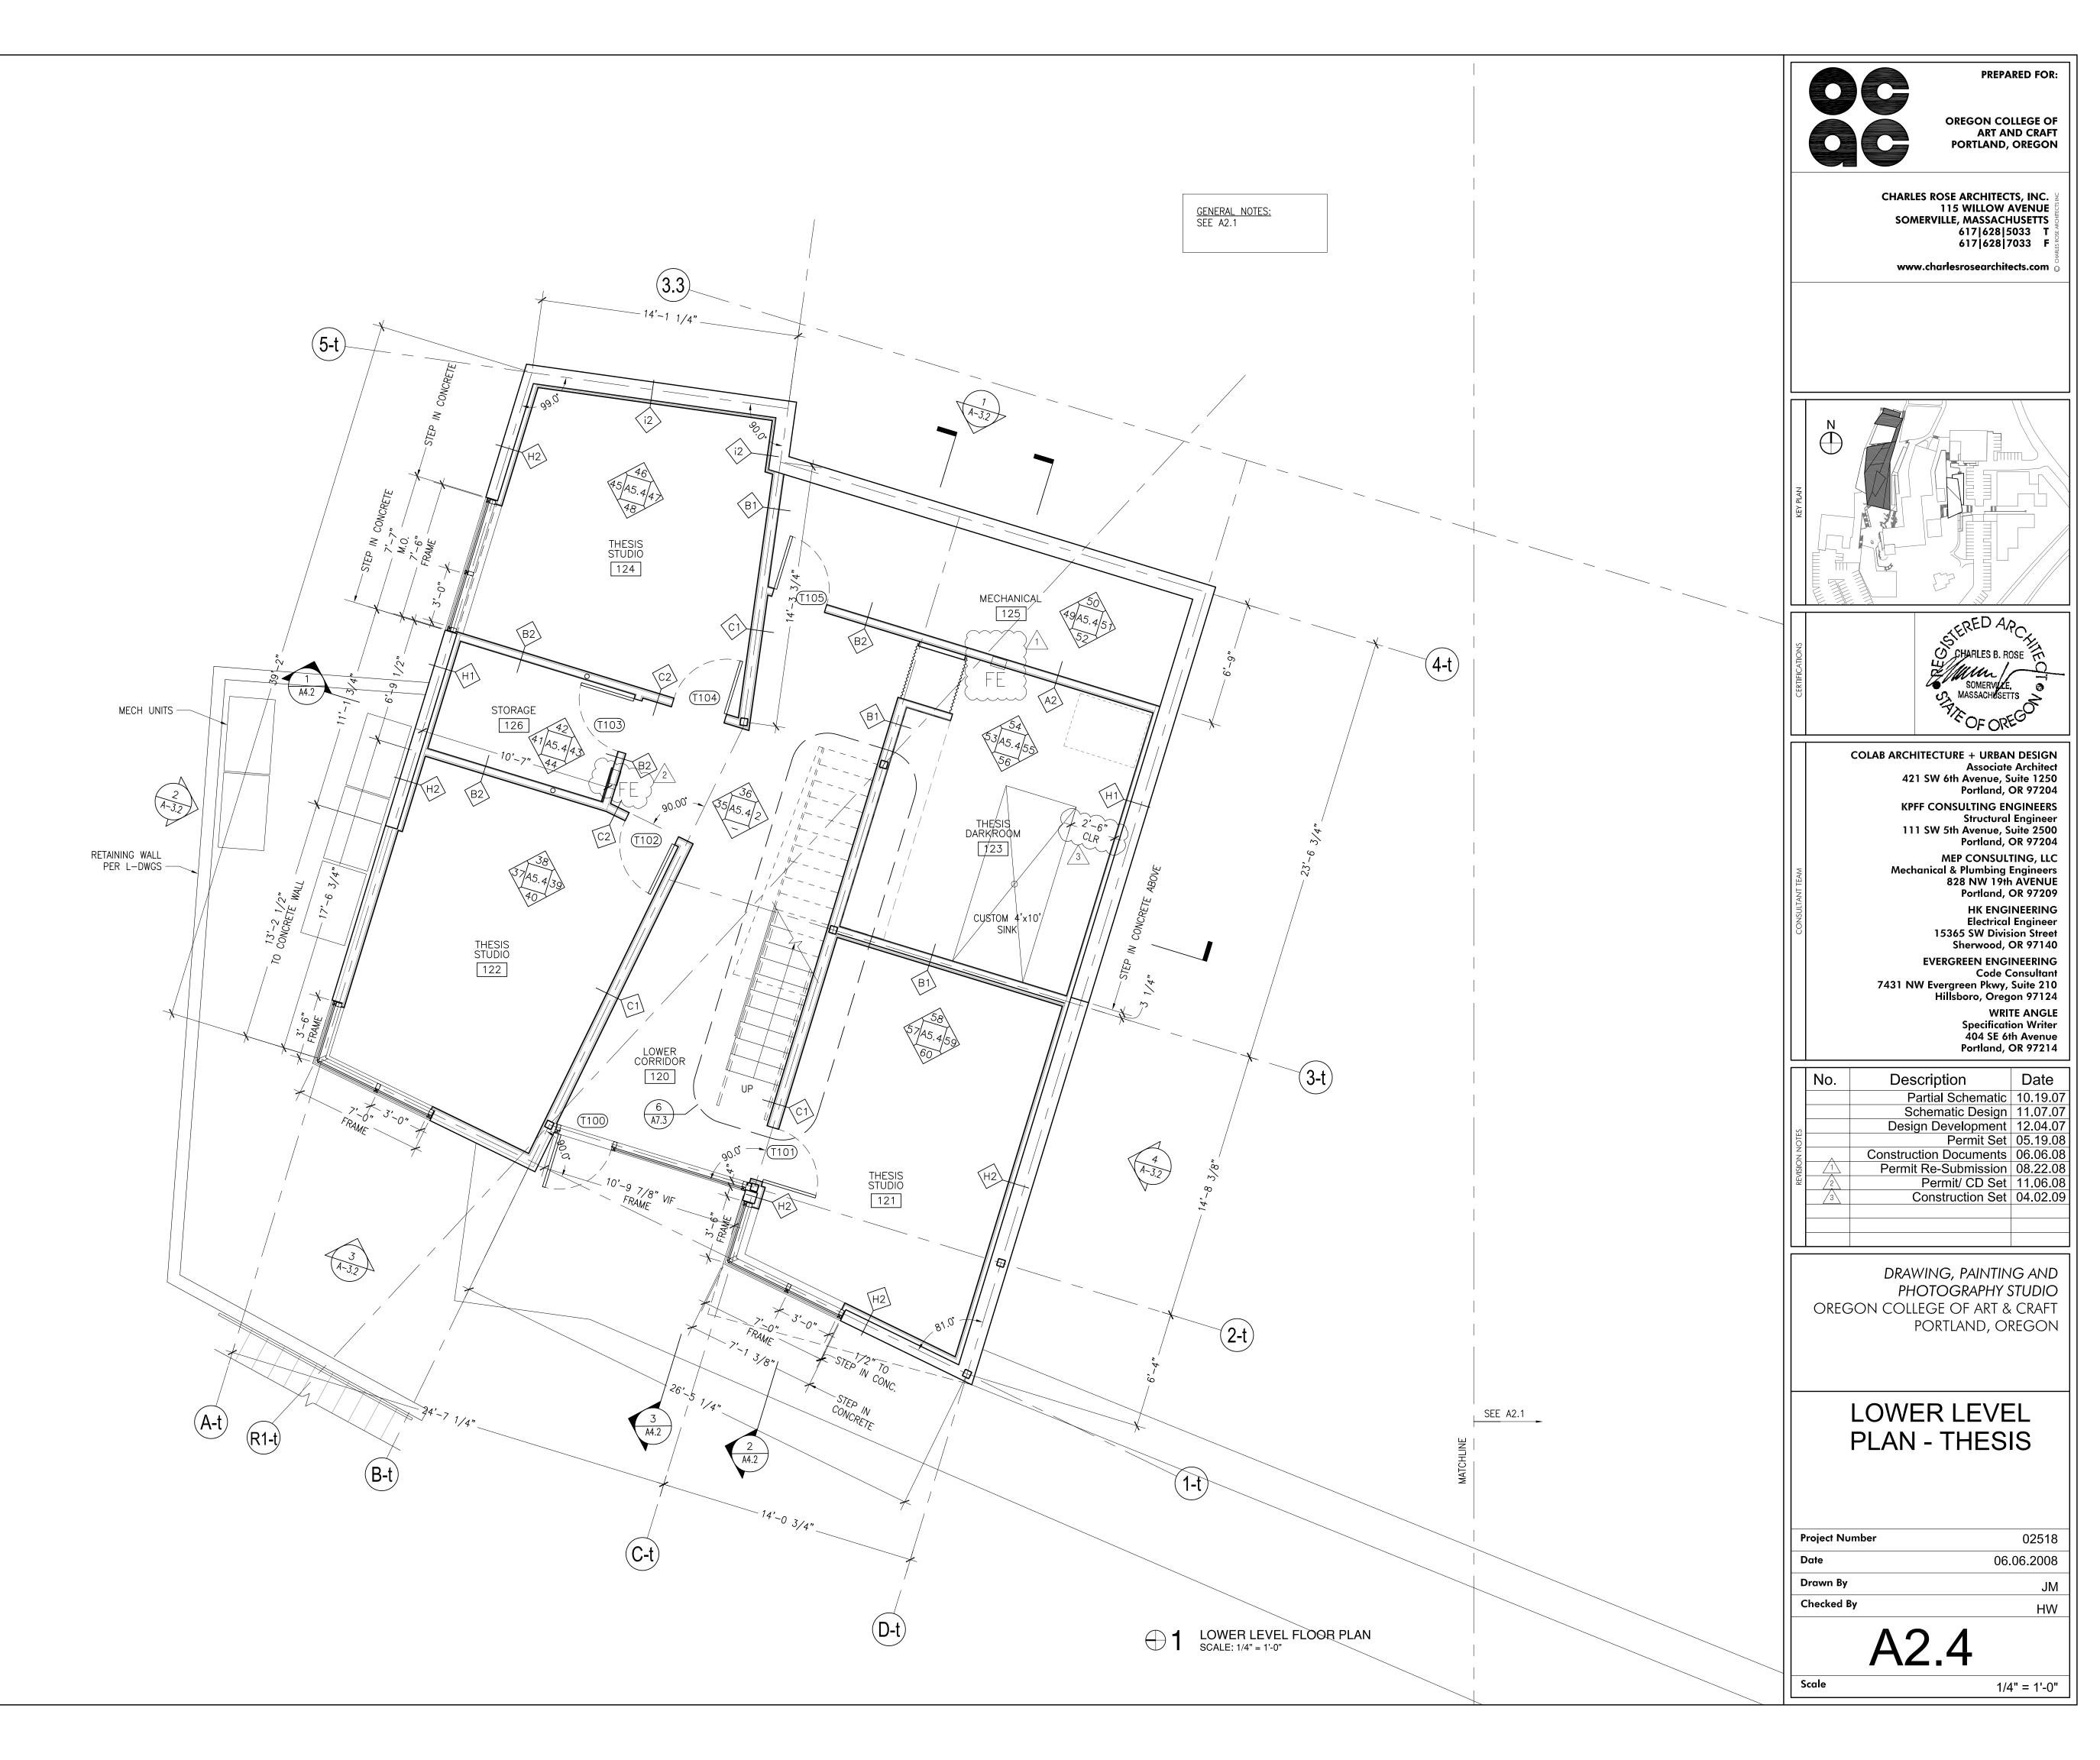


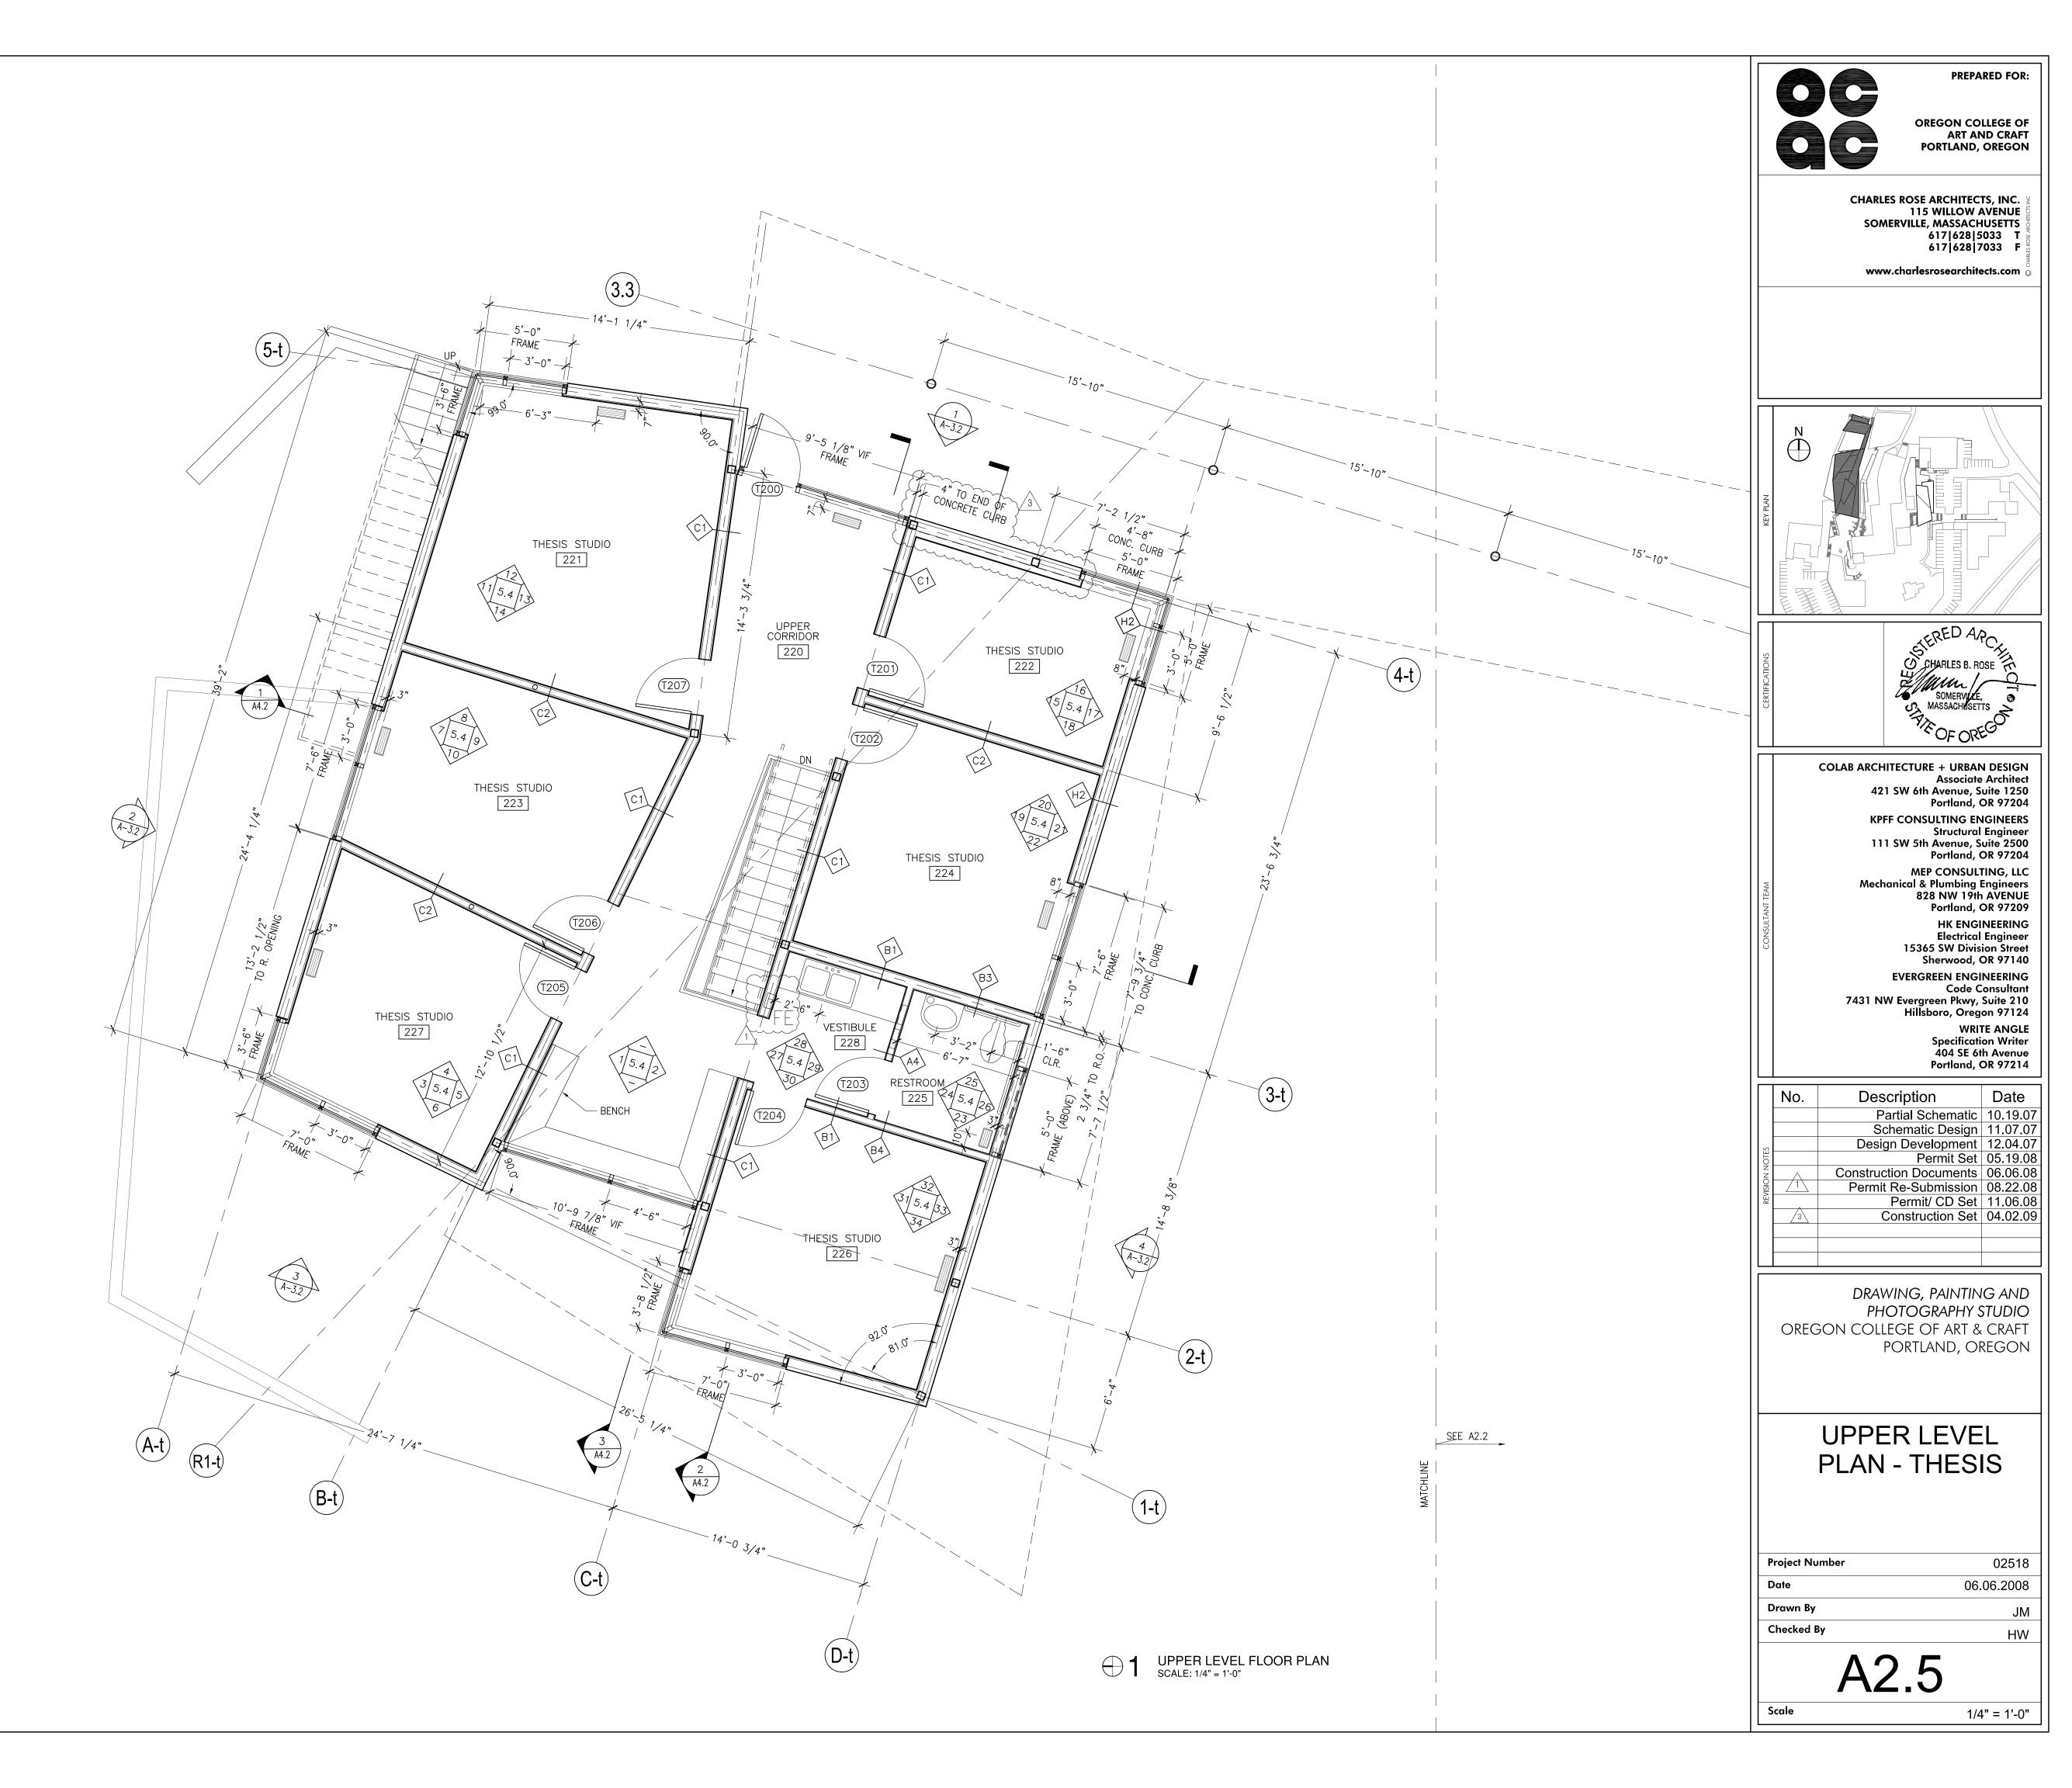

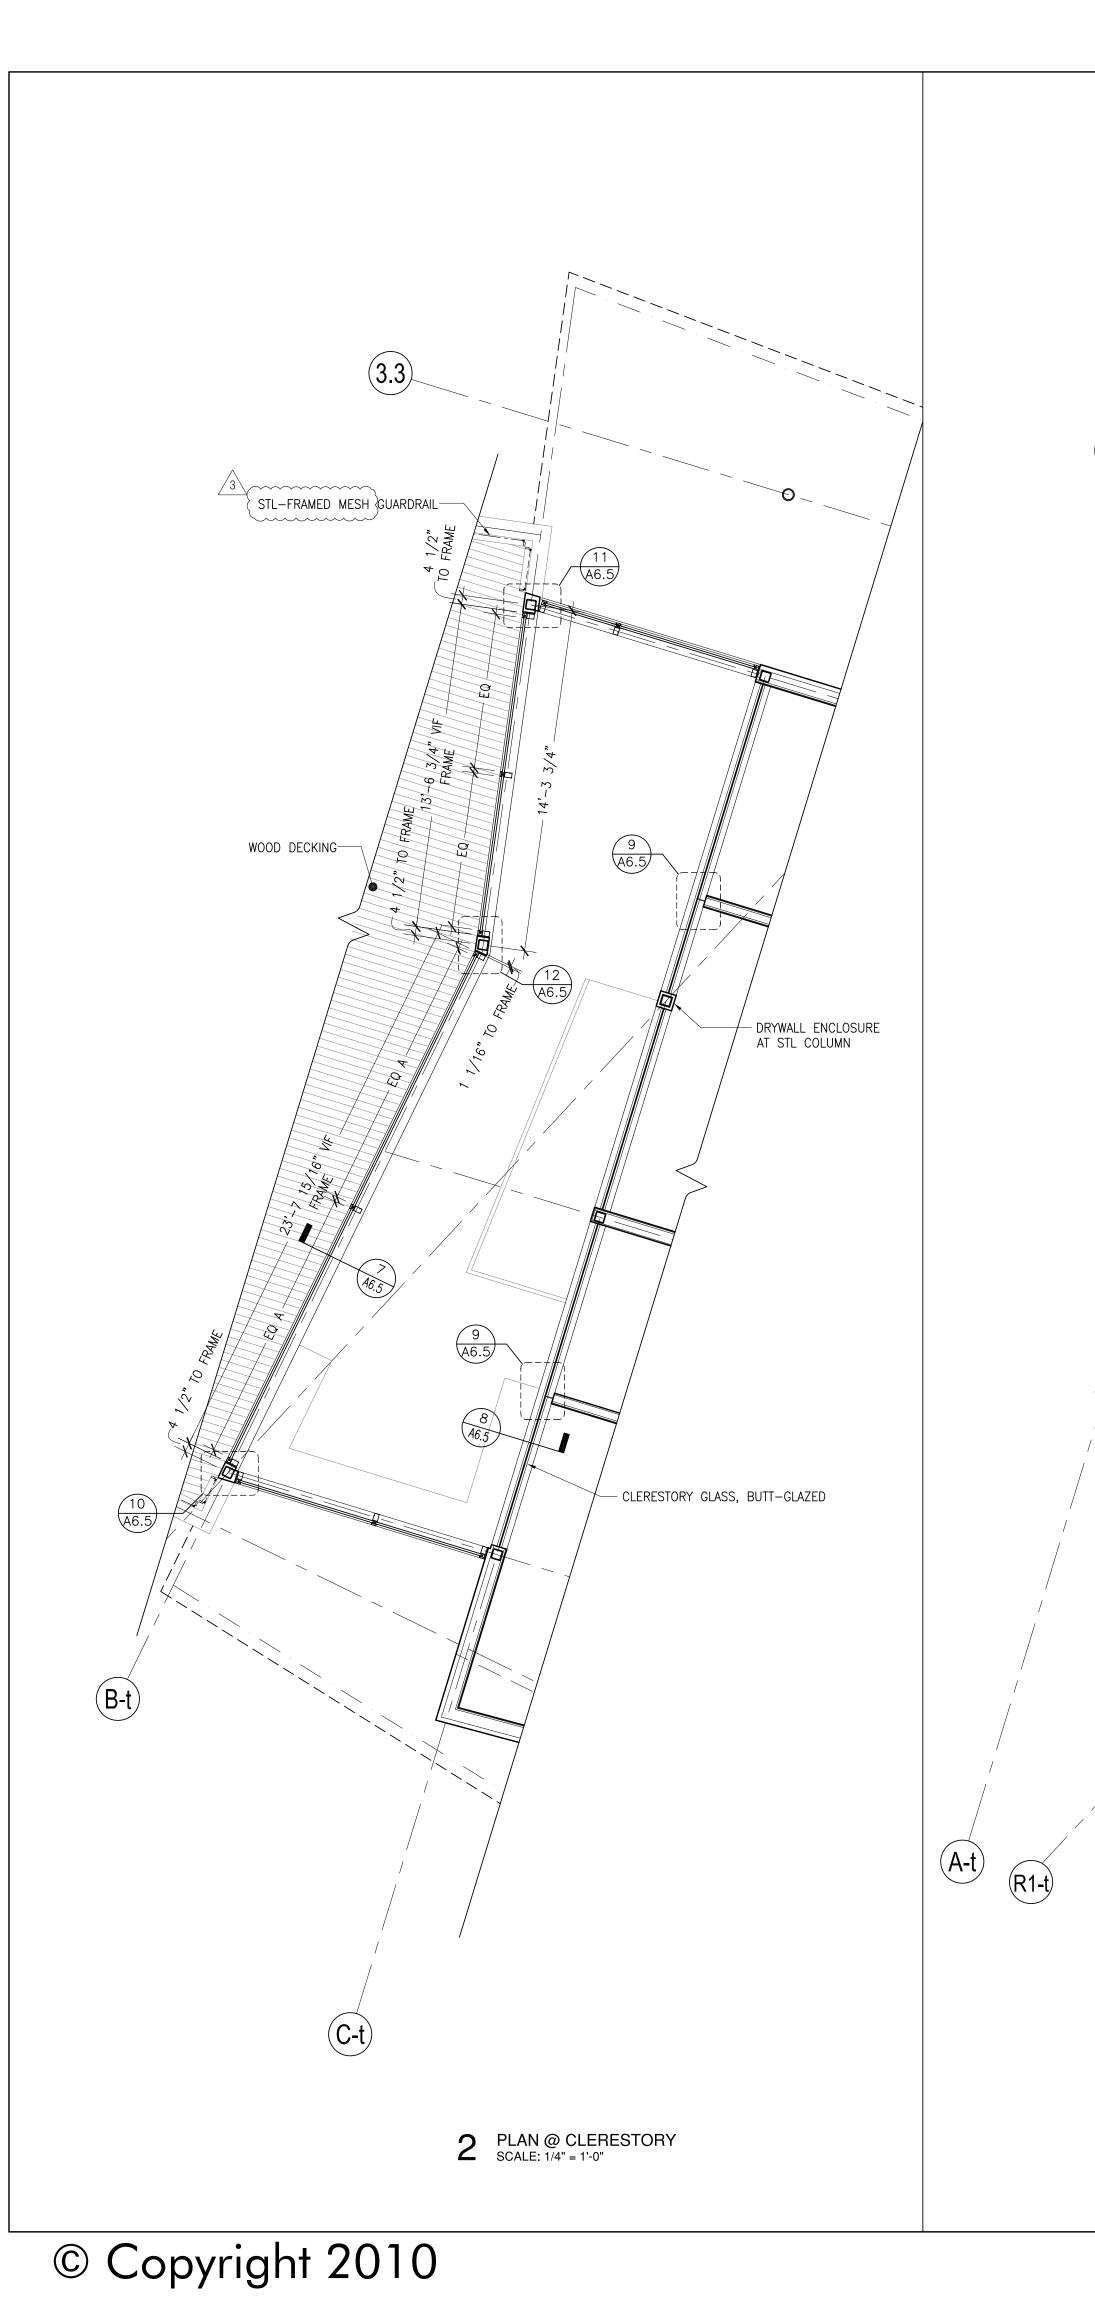

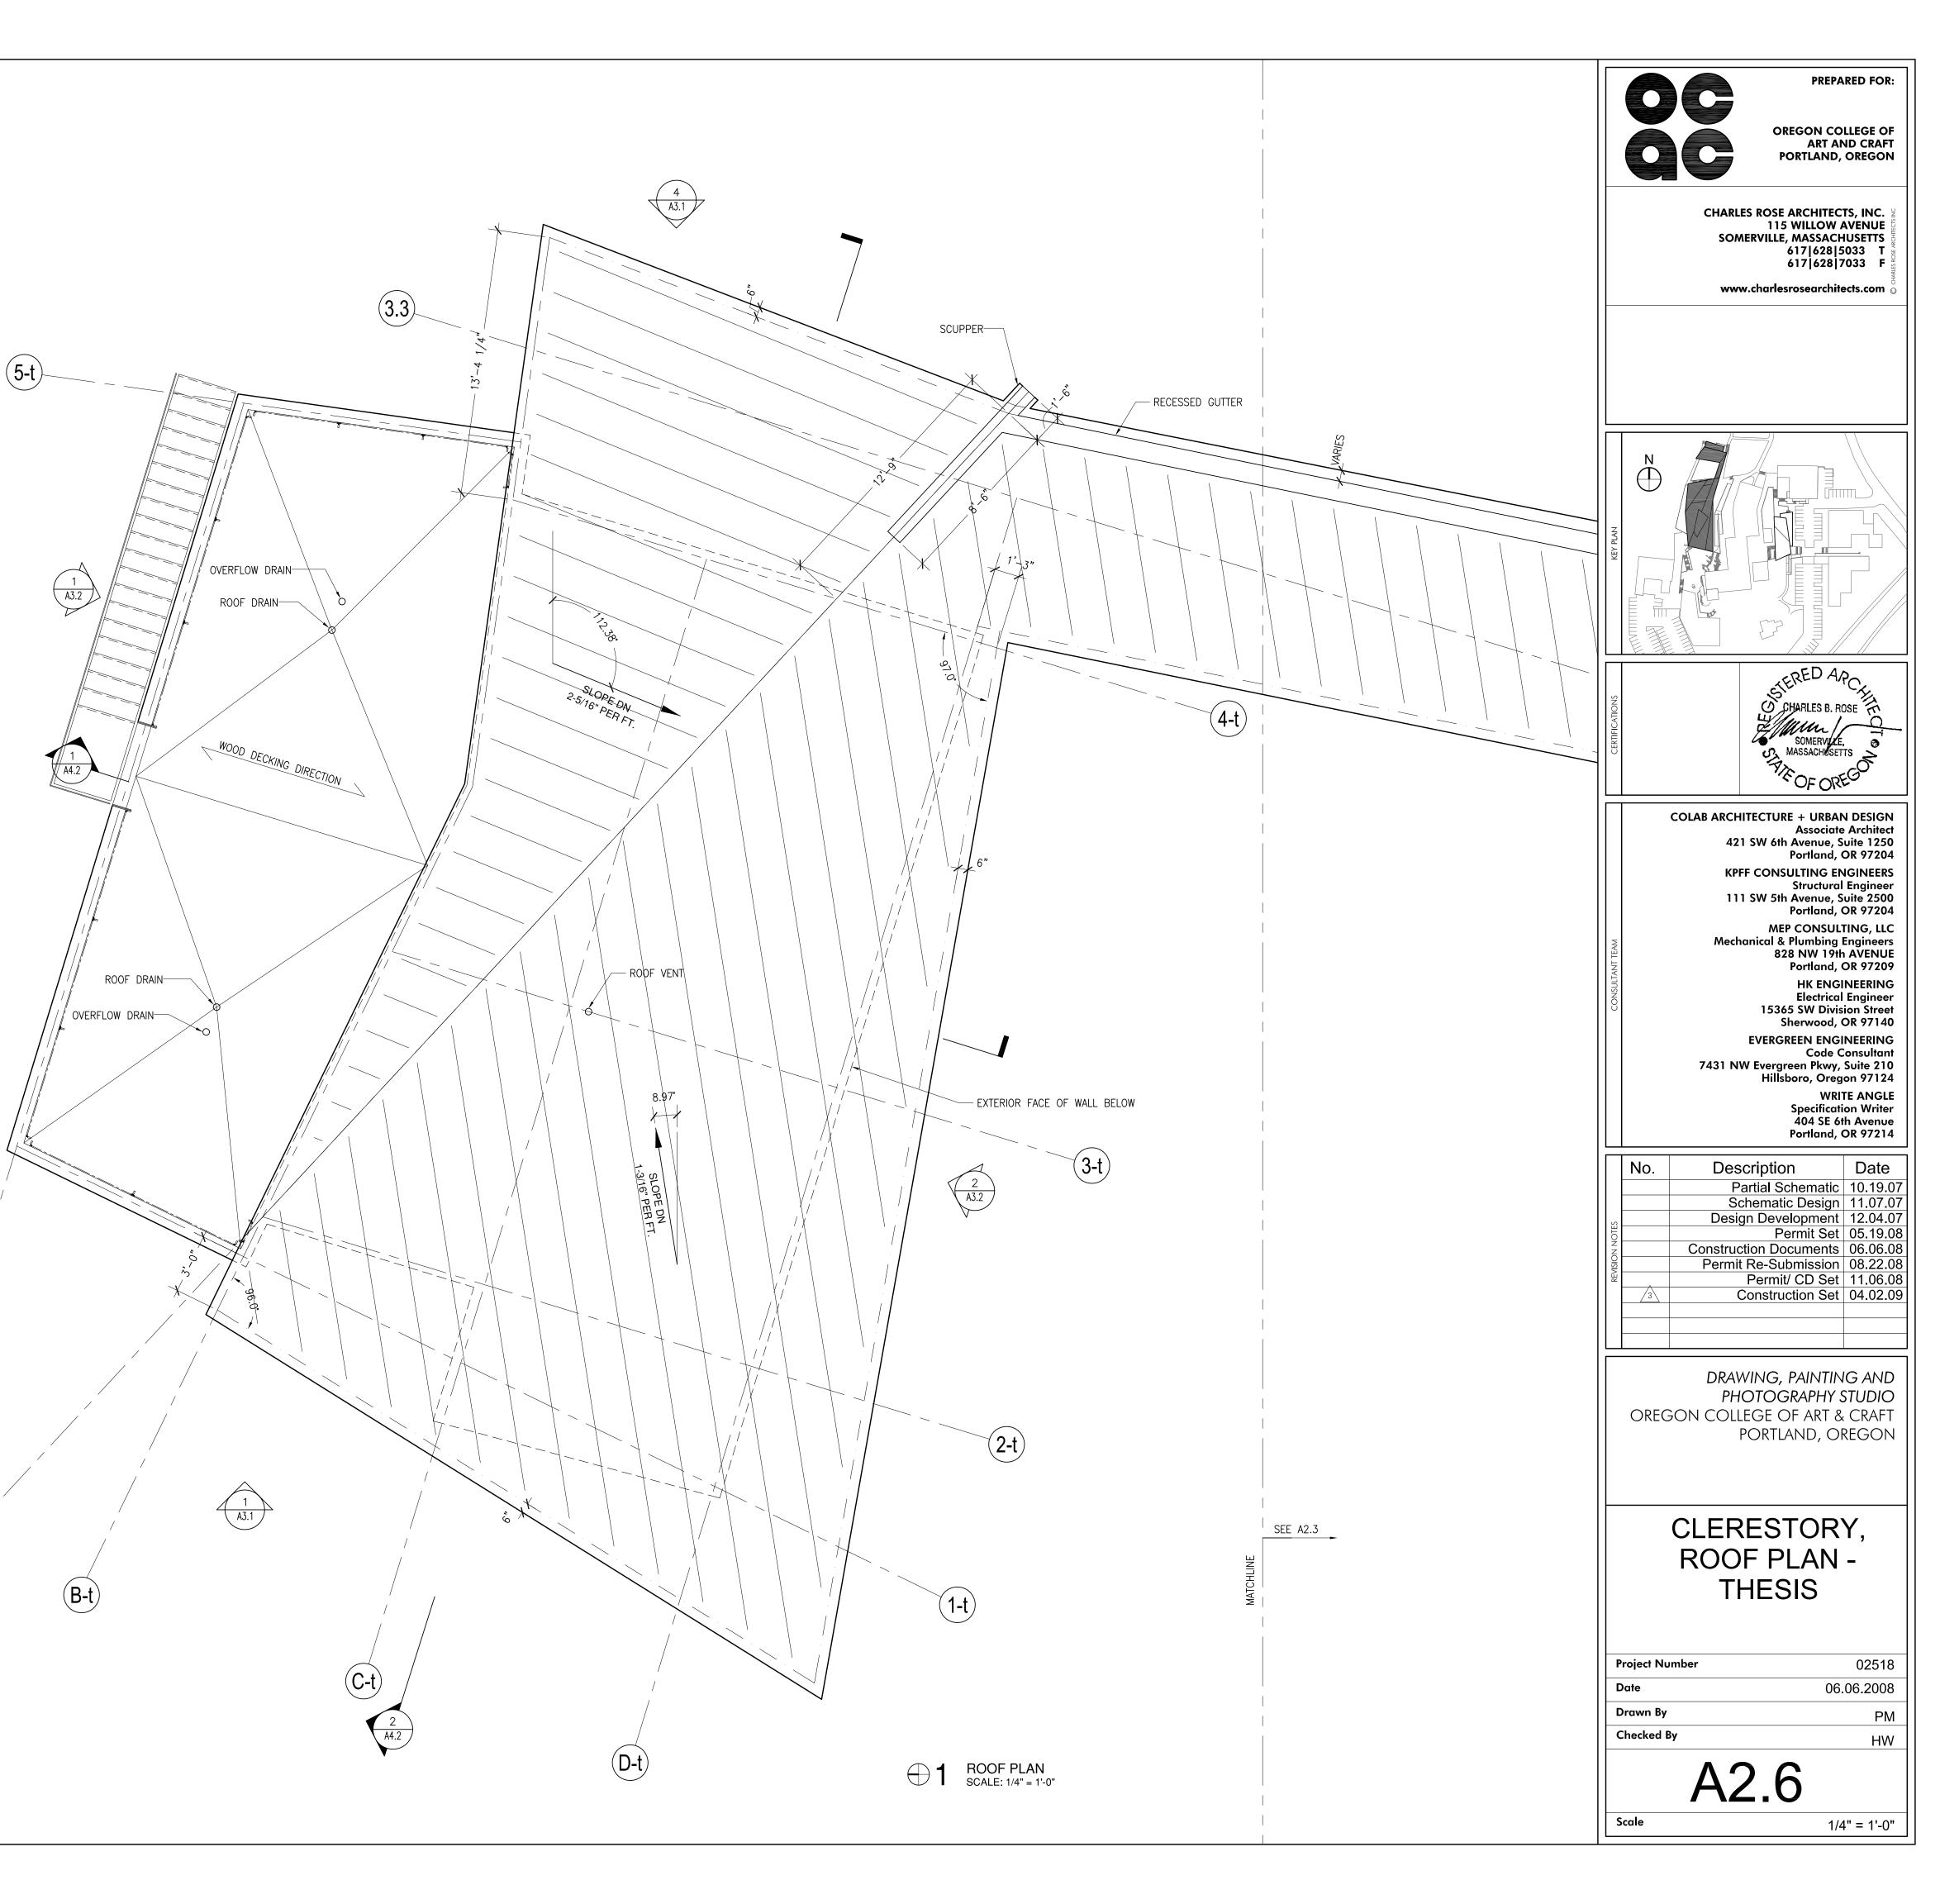

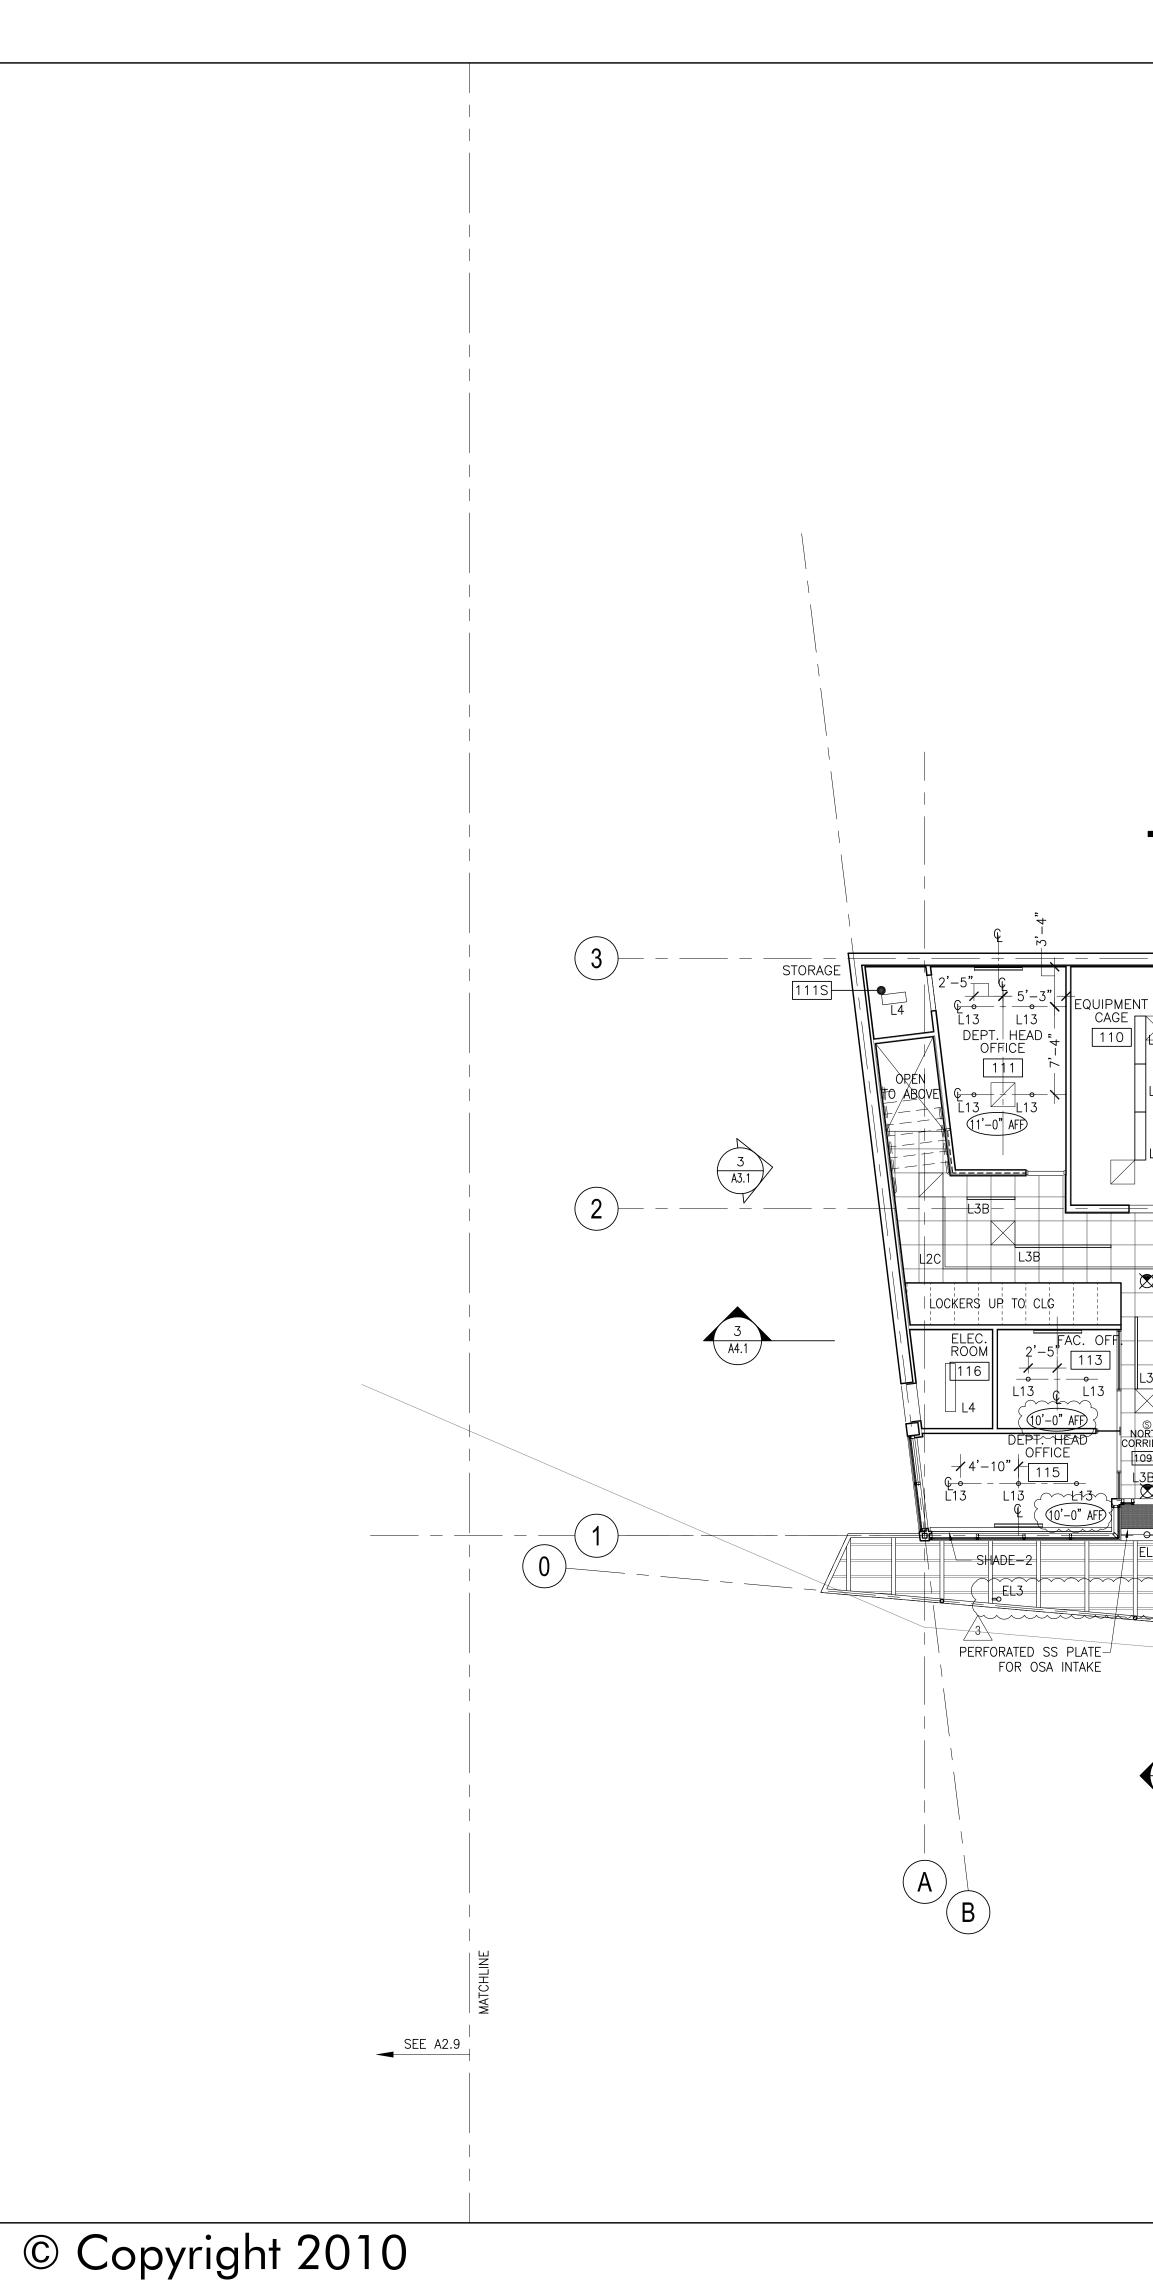


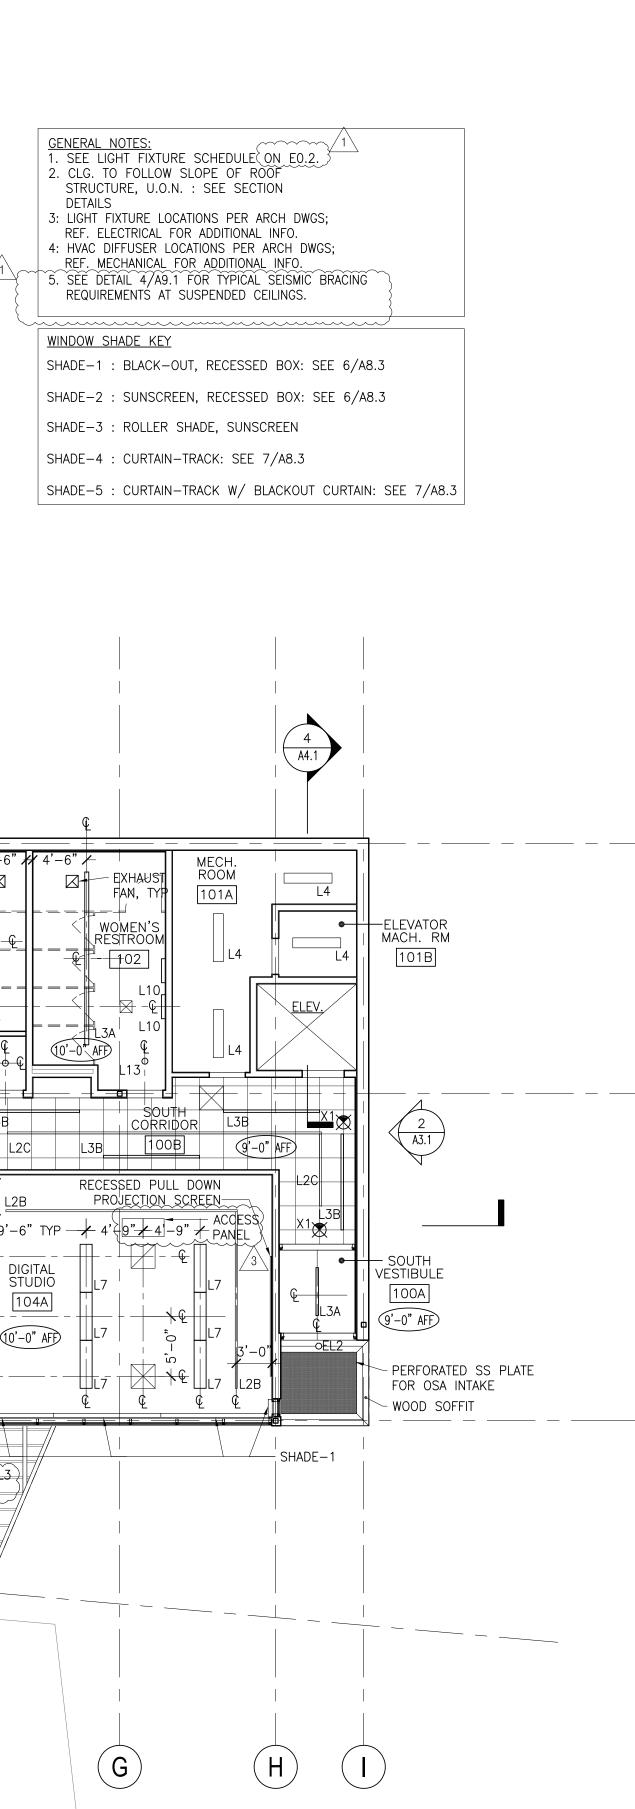



			4 A3.1		
NT		L12 ALTERNATIVE PROCESSING 108A L12 L12 L12 L12 L12 L12 L12 L12	L12 C L12 C AFF	$\begin{bmatrix} & & & & & \\ & & & & \\ & & & & \\ & & & & \\ & & & & \\ & & & & \\ & & & \\ & & & \\ & & & \\ & & & \\ & & & \\ & & & \\ & & & \\ & & & \\ & & & \\ & & & & \\ & & & \\ & $	$AFD \qquad \bigcirc \qquad $
XX1 L3B SORTH RRIDOR 1098	2'-5" FAC OFF. 2'-5" FAC OFF. 2'-5" FAC OFF. 2'-5" FAC OFF. 112 2'-5" FAC OFF. 114		L3B CLASSROOM CLASSR	L3B L2C L2C L2C L2C L2C L2C L2C L2C	$\begin{array}{c c} & & & \\ \hline \\ \hline$
B XX1 EL2	C (10'-0" AFD C (10'-0" AFD SHADE 2 EL3			2B L7 L2B L7 L2B L7 L2B	
A			E	F	G

OC OREGON COLLEGE OF ART AND CRAFT PORTLAND, OREGON CHARLES ROSE ARCHITECTS, INC. 115 WILLOW AVENUE SOMERVILLE, MASSACHUSETTS 617|628|5033 T 617|628|7033 F www.charlesrosearchitects.com \bigcirc TERED APC O CHARLES B. ROSE Mun 1 SOMERVILLE MASSACHUSETTS FR OF OREG COLAB ARCHITECTURE + URBAN DESIGN Associate Architect 421 SW 6th Avenue, Suite 1250 Portland, OR 97204 KPFF CONSULTING ENGINEERS Structural Engineer 111 SW 5th Avenue, Suite 2500 Portland, OR 97204 MEP CONSULTING, LLC Mechanical & Plumbing Engineers 828 NW 19th AVENUE Portland, OR 97209 HK ENGINEERING Electrical Engineer 15365 SW Division Street Sherwood, OR 97140 EVERGREEN ENGINEERING Code Consultant 7431 NW Evergreen Pkwy, Suite 210 Hillsboro, Oregon 97124 WRITE ANGLE Specification Writer 404 SE 6th Avenue Portland, OR 97214 No. Description Date DescriptionDatePartial Schematic10.19.07Schematic Design11.07.07Design Development12.04.07Permit Set05.19.08Construction Documents06.06.08Permit Re-Submission08.22.08Permit/ CD Set11.06.08Construction Set04.02.09(Lighting/low-volt. changes)02.26.09 DRAWING, PAINTING AND PHOTOGRAPHY STUDIO OREGON COLLEGE OF ART & CRAFT PORTLAND, OREGON LOWER LEVEL REFLECTED **CEILING PLAN** - STUDIO Project Number 02518 Date 06.06.2008 Drawn By JM, PM Checked By ΗW A2.7 Scale 1/8" = 1'-0"


PREPARED FOR:

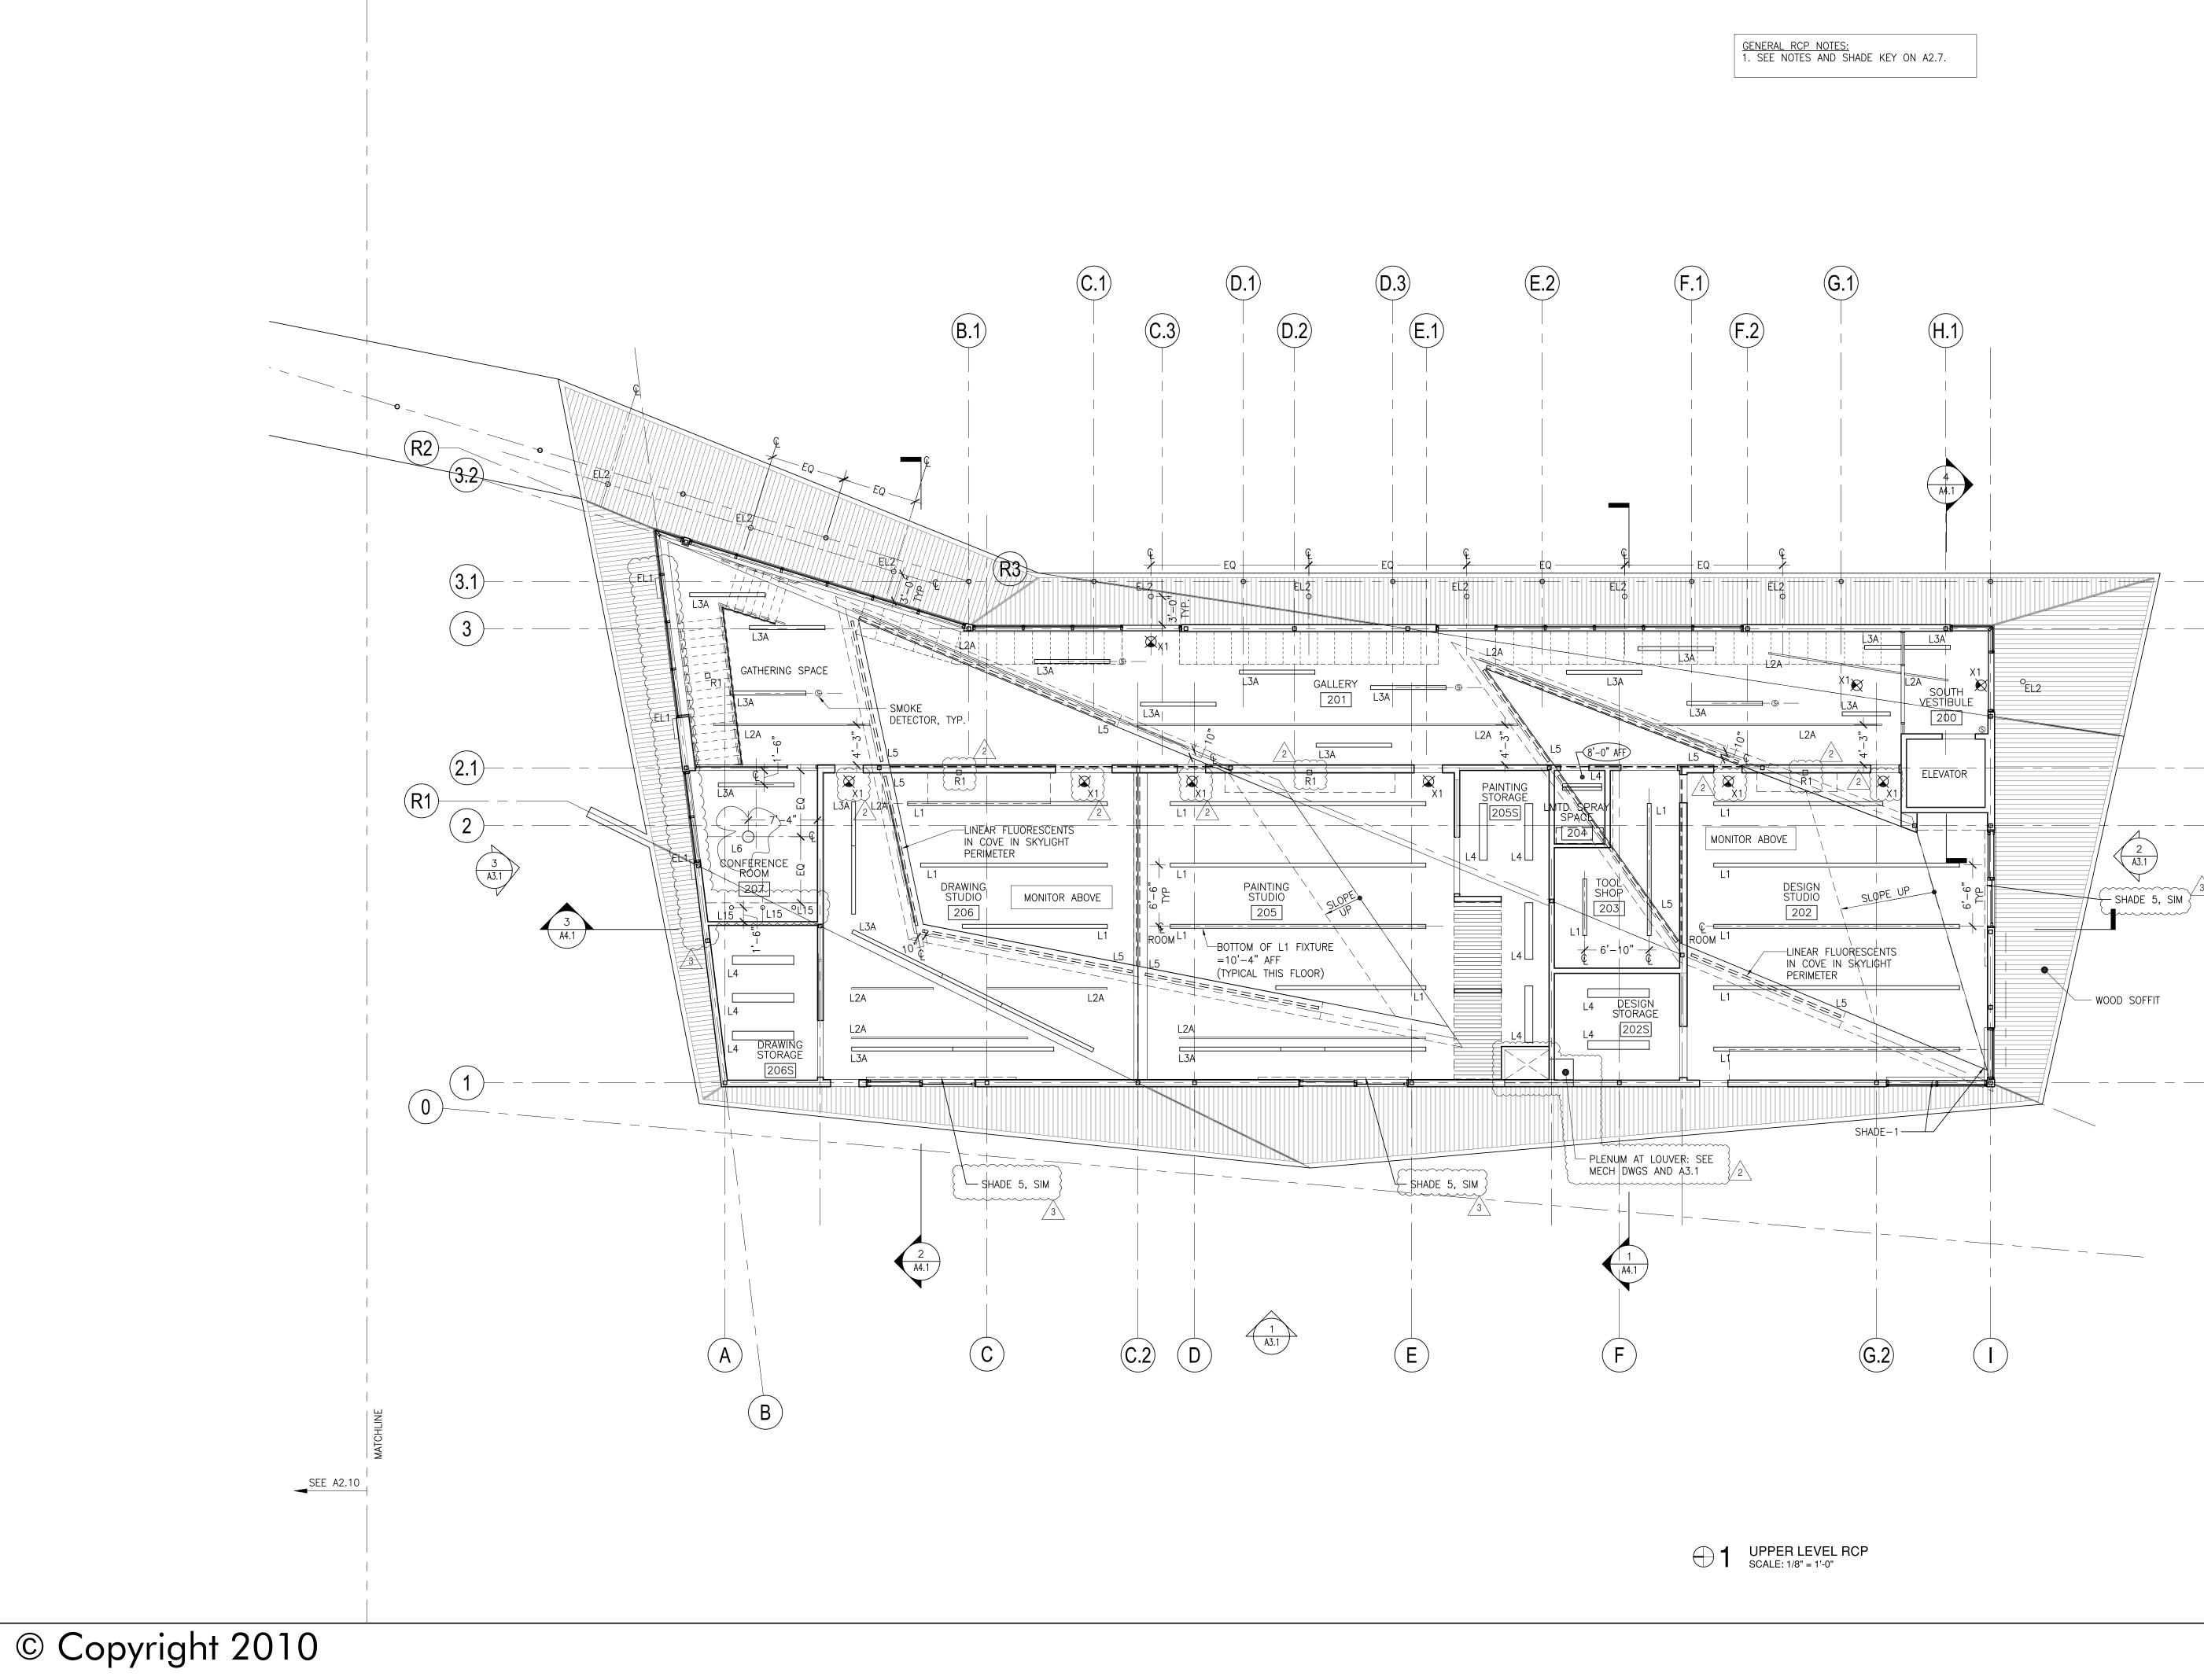


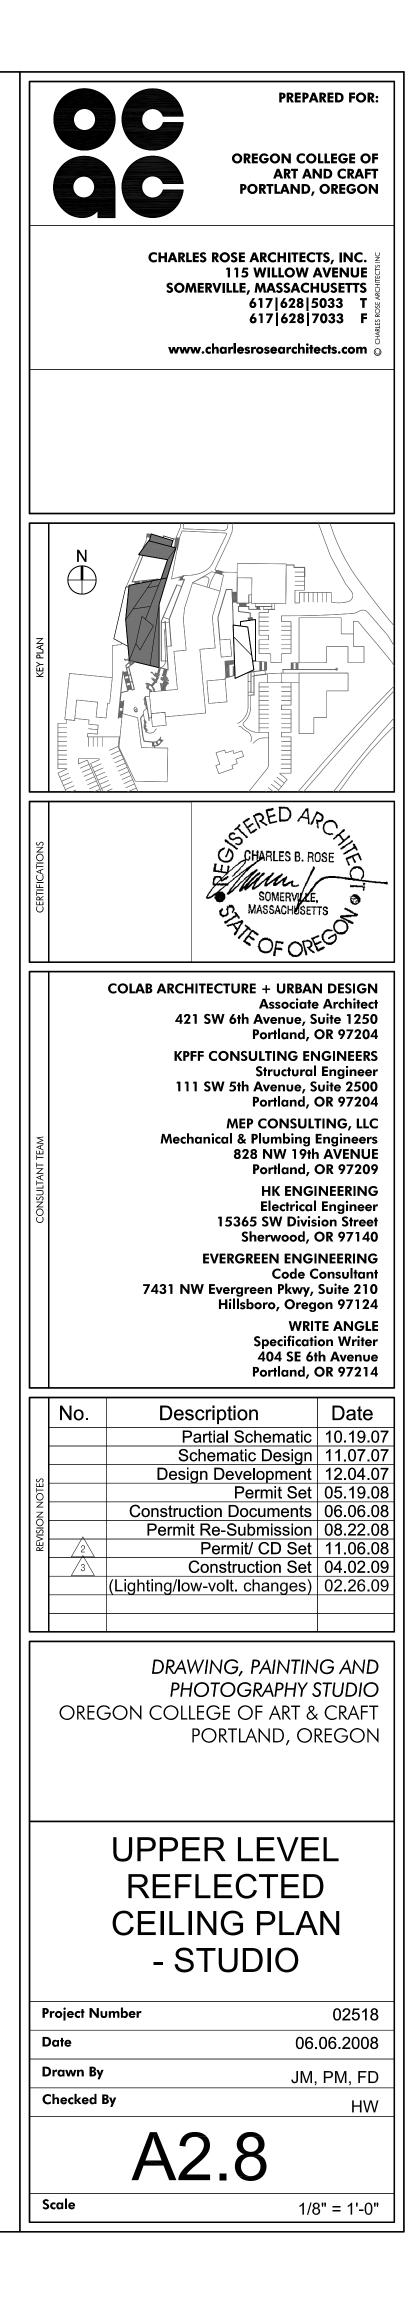

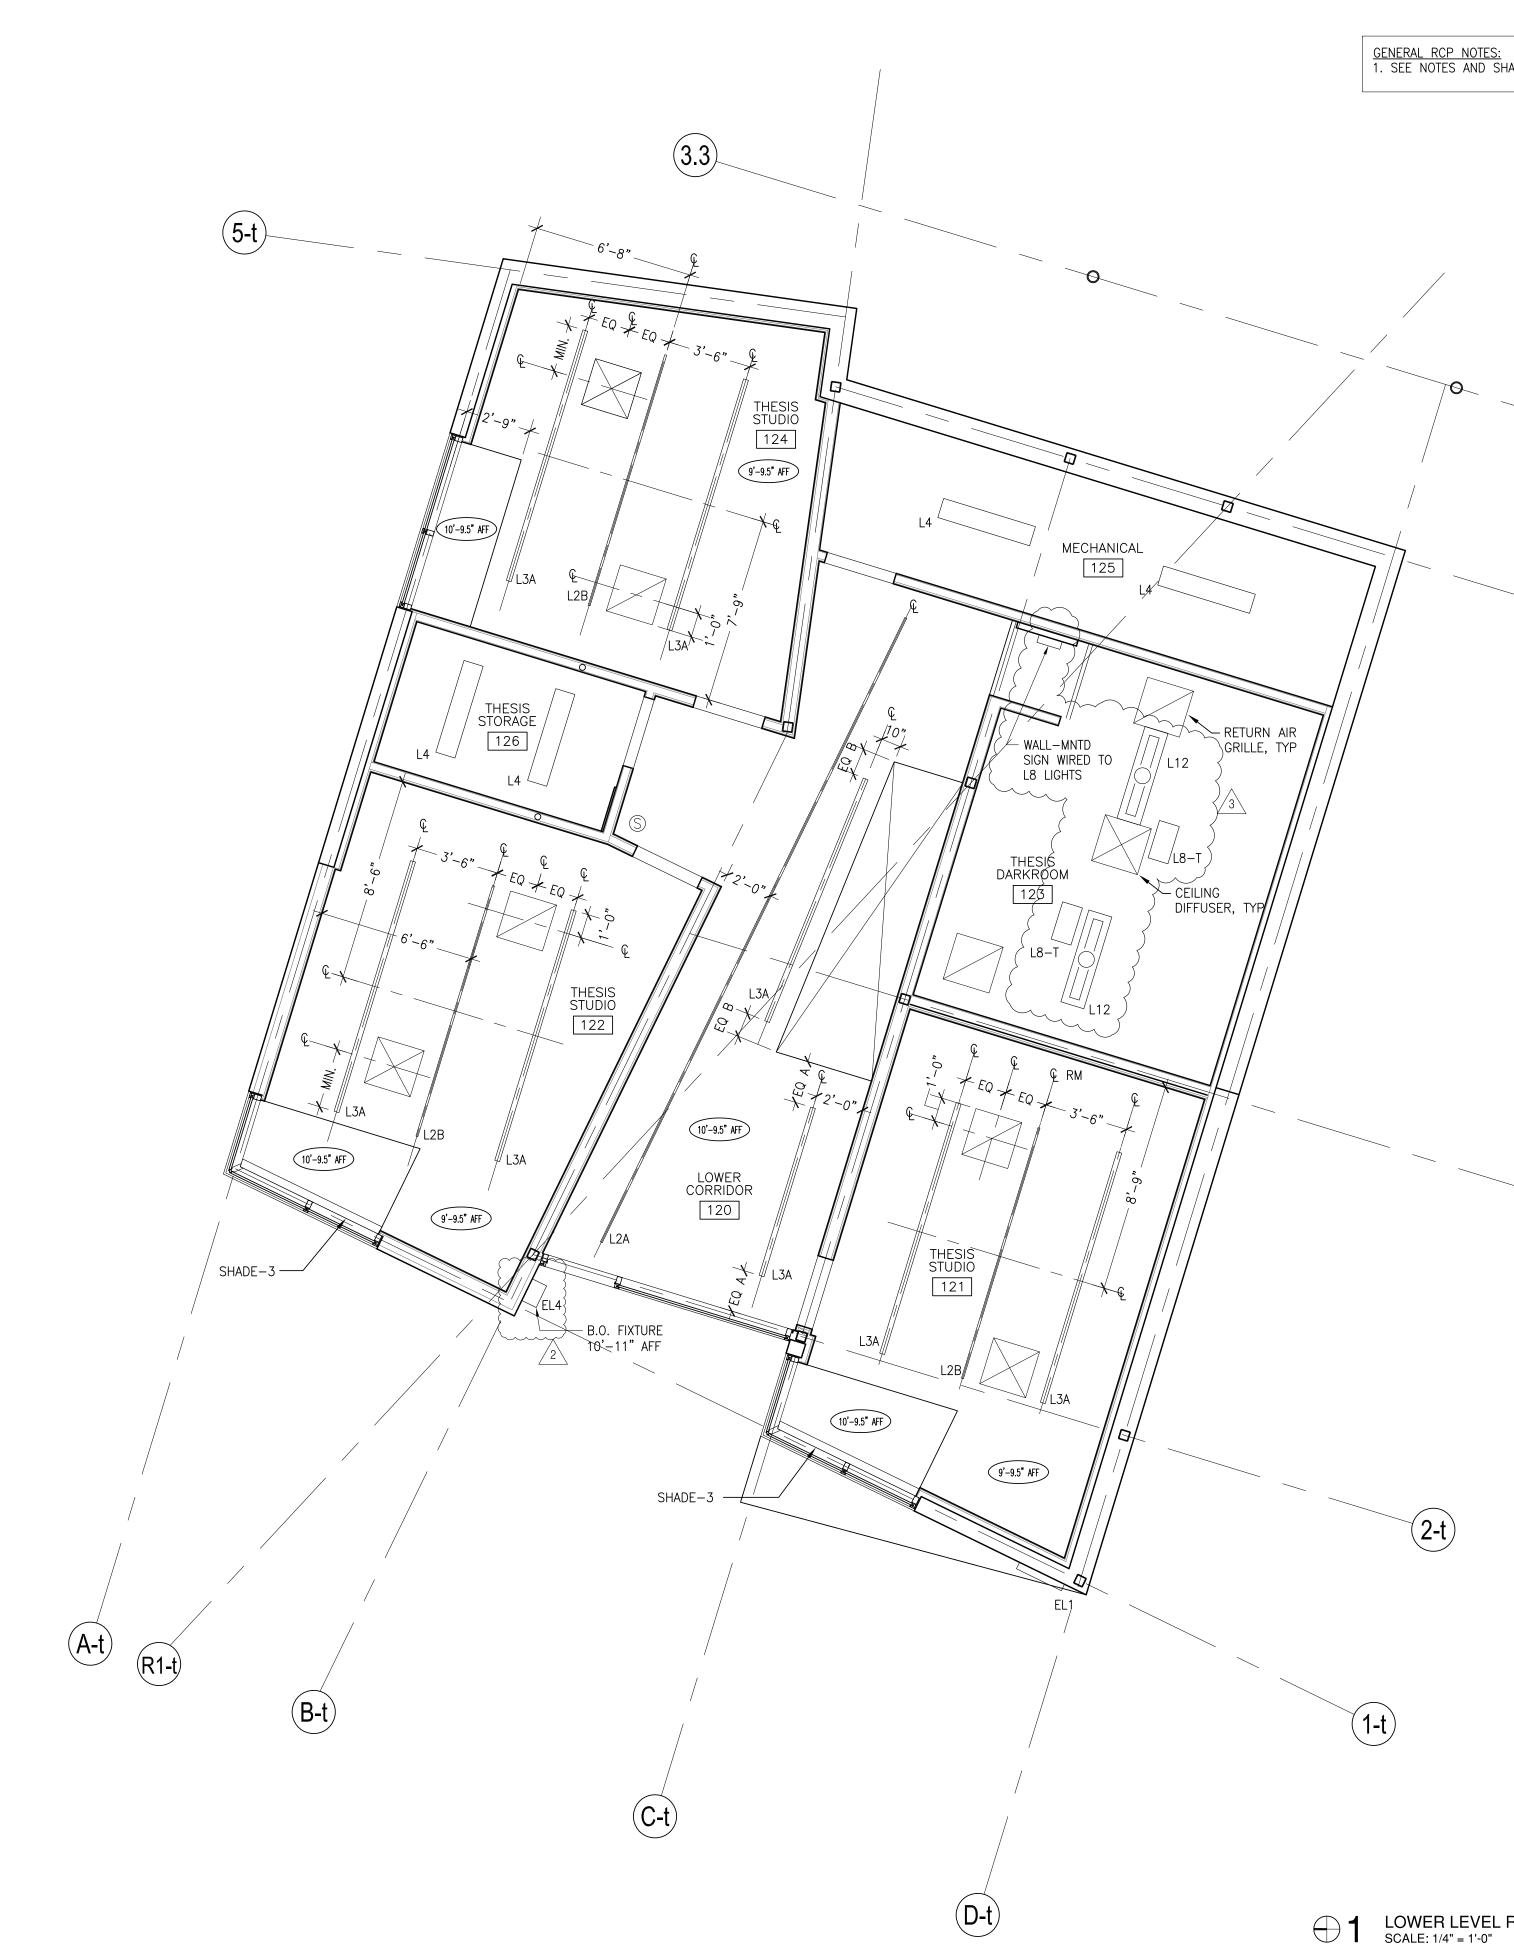


		PREPARED FOR:
		OREGON COLLEGE OF ART AND CRAFT PORTLAND, OREGON
ADE KEY ON A2.7.		CHARLES ROSE ARCHITECTS, INC. 9 115 WILLOW AVENUE SOMERVILLE, MASSACHUSETTS 617 628 5033 T 617 628 7033 F www.charlesrosearchitects.com •
	0	KEY PAN
(4-t)		CHARLES B. ROSE TO CHARLES B. ROSE TO SOMERVILLE, MASSACHUSETTS OF OF OREC
		WEILING COLAB ARCHITECTURE + URBAN DESIGN Associate Architect 421 SW 6th Avenue, Suite 1250 Portland, OR 97204 KPFF CONSULTING ENGINEERS Structural Engineer 111 SW 5th Avenue, Suite 2500 Portland, OR 97204 MEP CONSULTING, LLC Mechanical & Plumbing Engineers 828 NW 19th AVENUE Portland, OR 97209 HK ENGINEERING Electrical Engineer 15365 SW Division Street Sherwood, OR 97140 EVERGREEN ENGINEERING Code Consultant 7431 NW Evergreen Pkwy, Suite 210 Hillsboro, Oregon 97124 WRITE ANGLE Specification Writer 404 SE 6th Avenue Portland, OR 97214
(3-t)		No. Description Date Partial Schematic 10.19.07 Schematic Design 11.07.07 Design Development 12.04.07 Permit Set 05.19.08 Construction Documents 06.06.08 Permit Re-Submission 08.22.08 2 Permit/CD Set 11.06.08 3 Construction Set 04.02.09 (Lighting/low-volt. changes) 02.26.09
		DRAWING, PAINTING AND PHOTOGRAPHY STUDIO OREGON COLLEGE OF ART & CRAFT PORTLAND, OREGON
MATCHLINE	SEE A2.7	LOWER LEVEL REFLECTED CEILING PLAN - THESIS Project Number 02518 Date 06.06.2008
RCP		Drawn By JM,FD Checked By HW A29 Scale 1/4" = 1'-0"

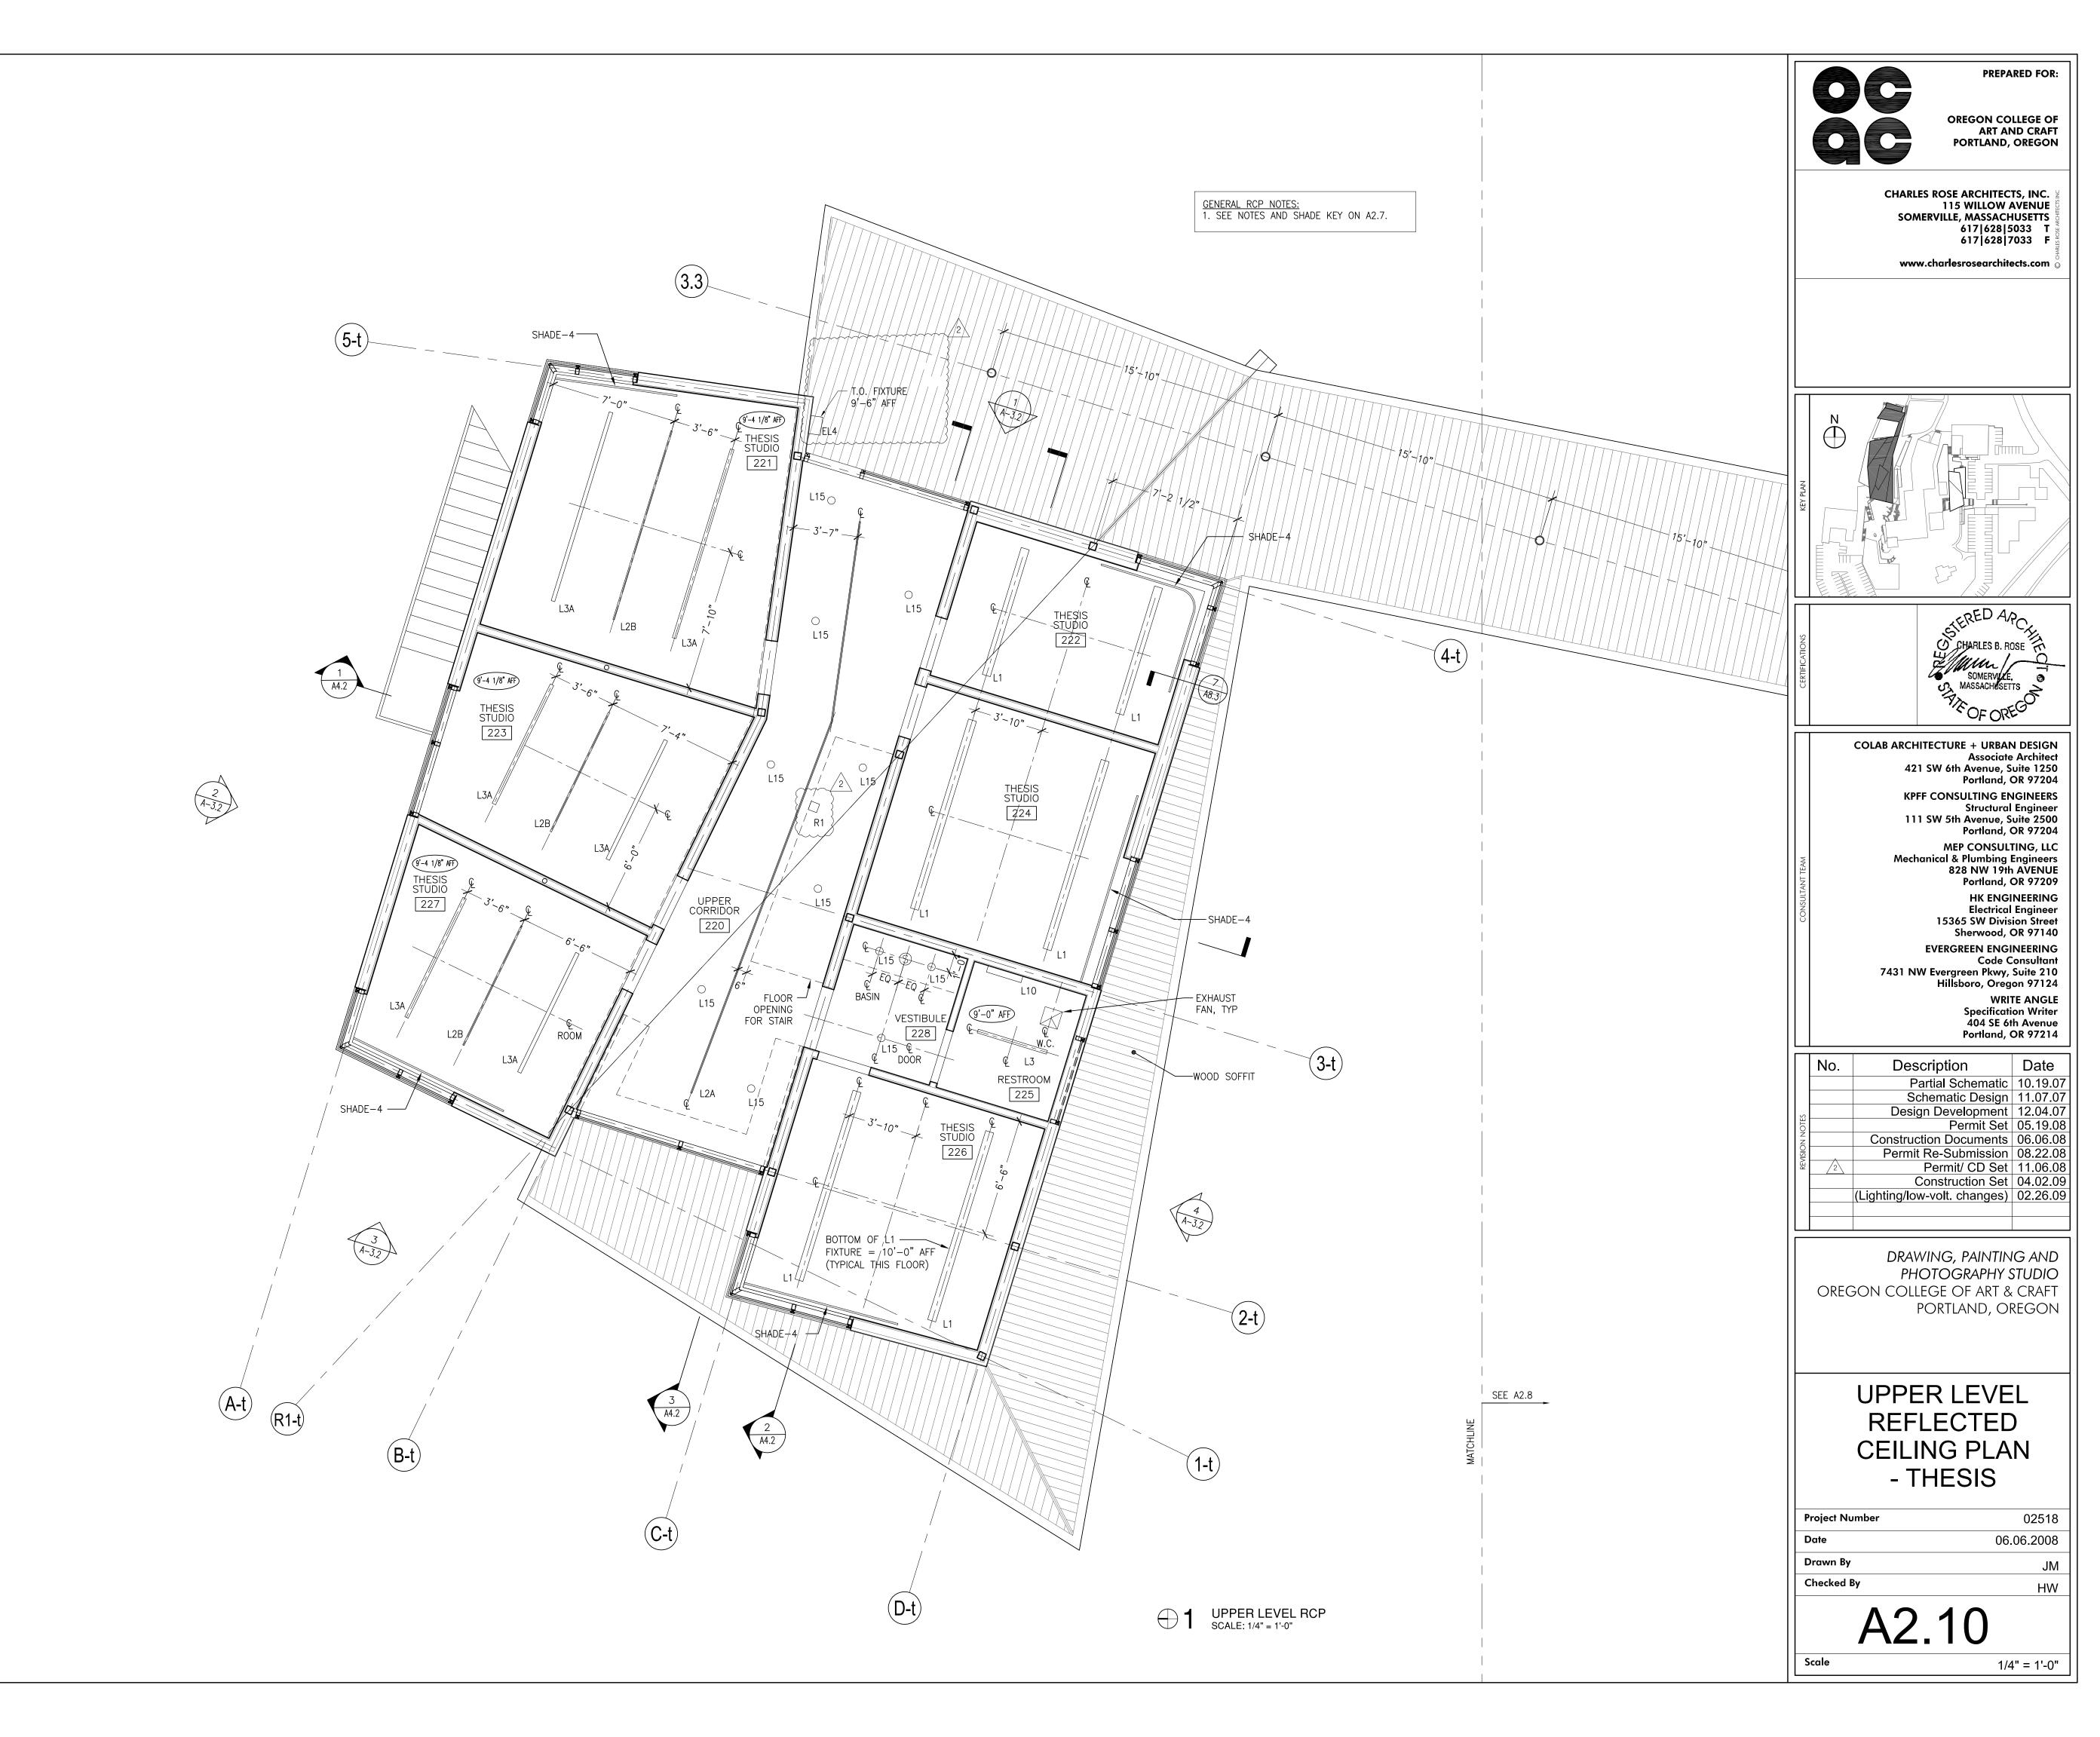

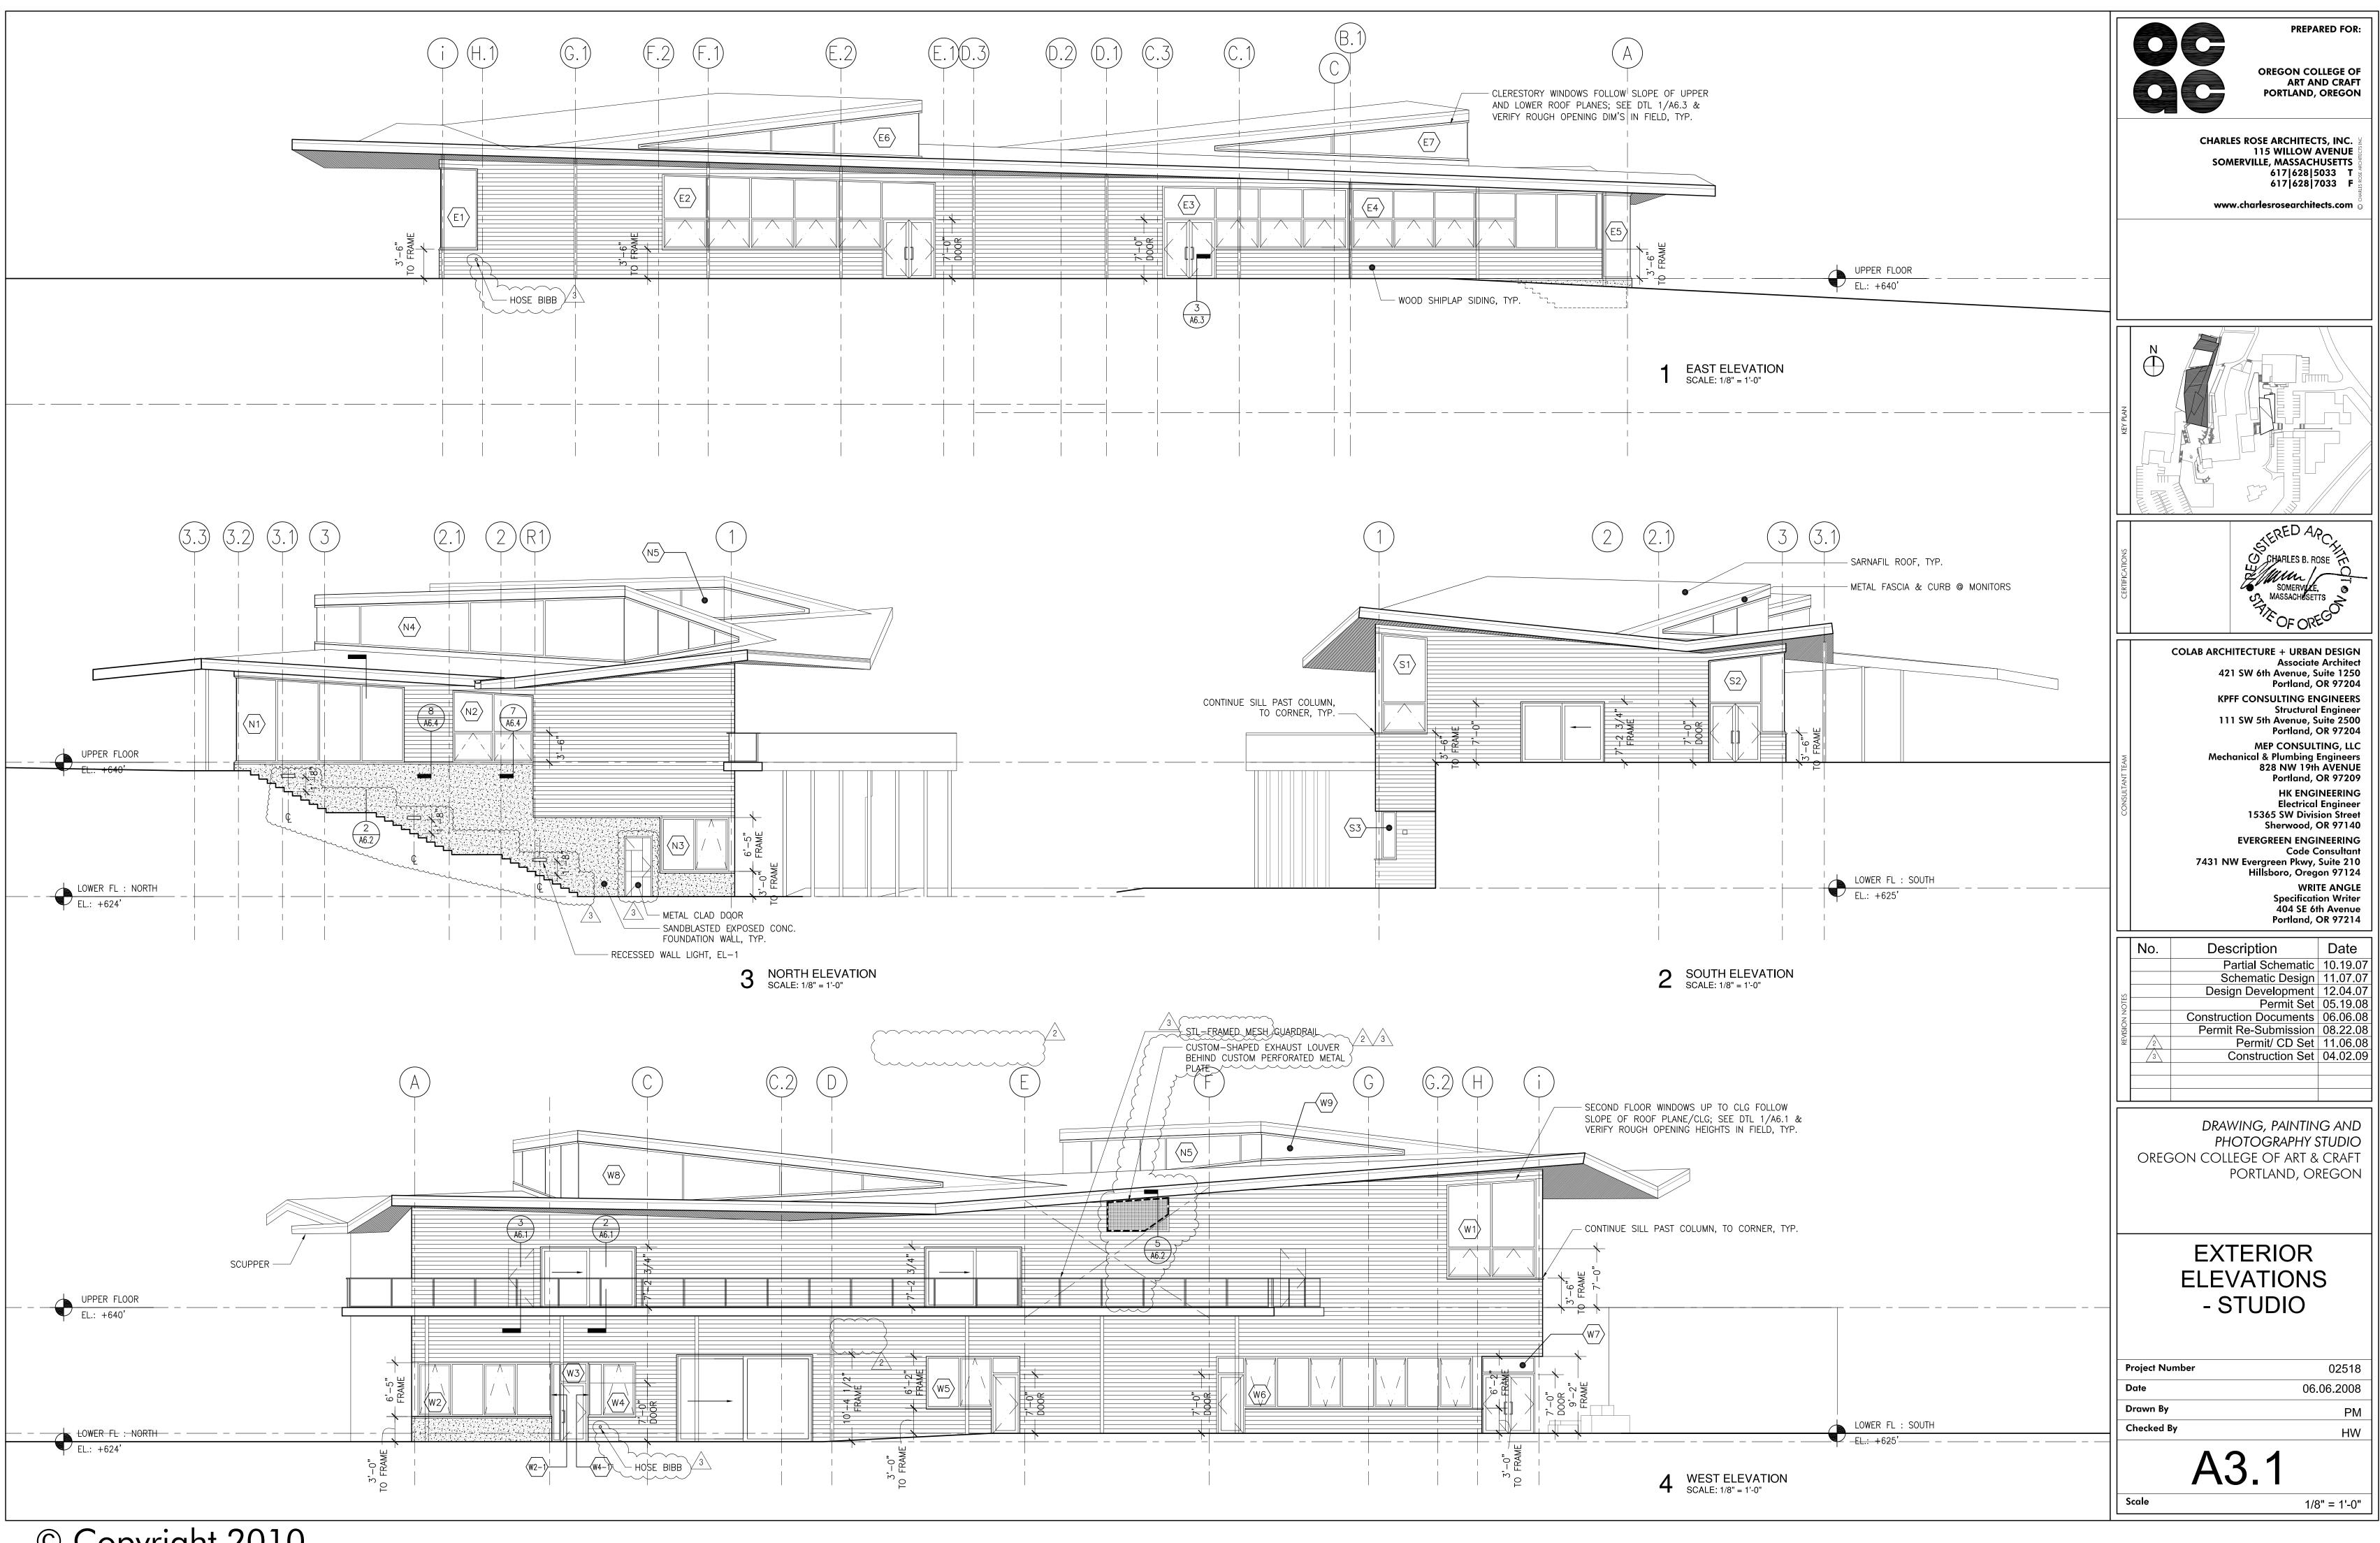

© Copyright 2010

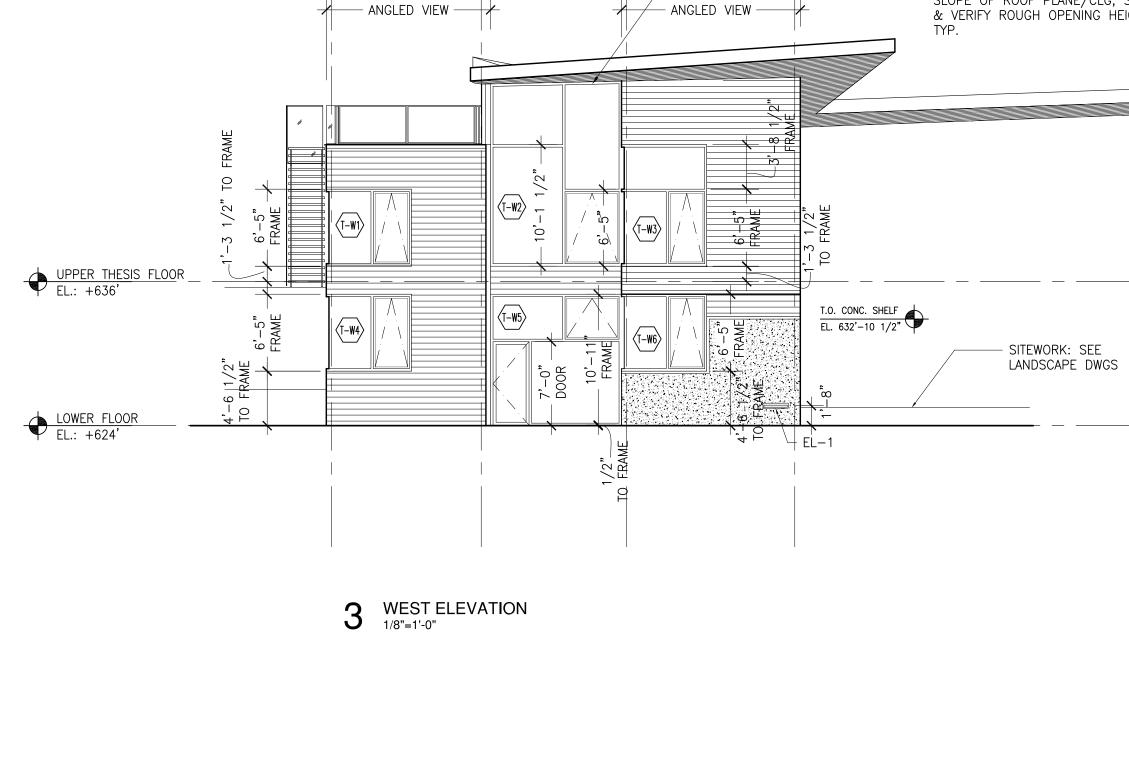


EAST ELEVATION 1/8"=1'-0"


(B-t)


C-t)


(D-t)


(A-t)

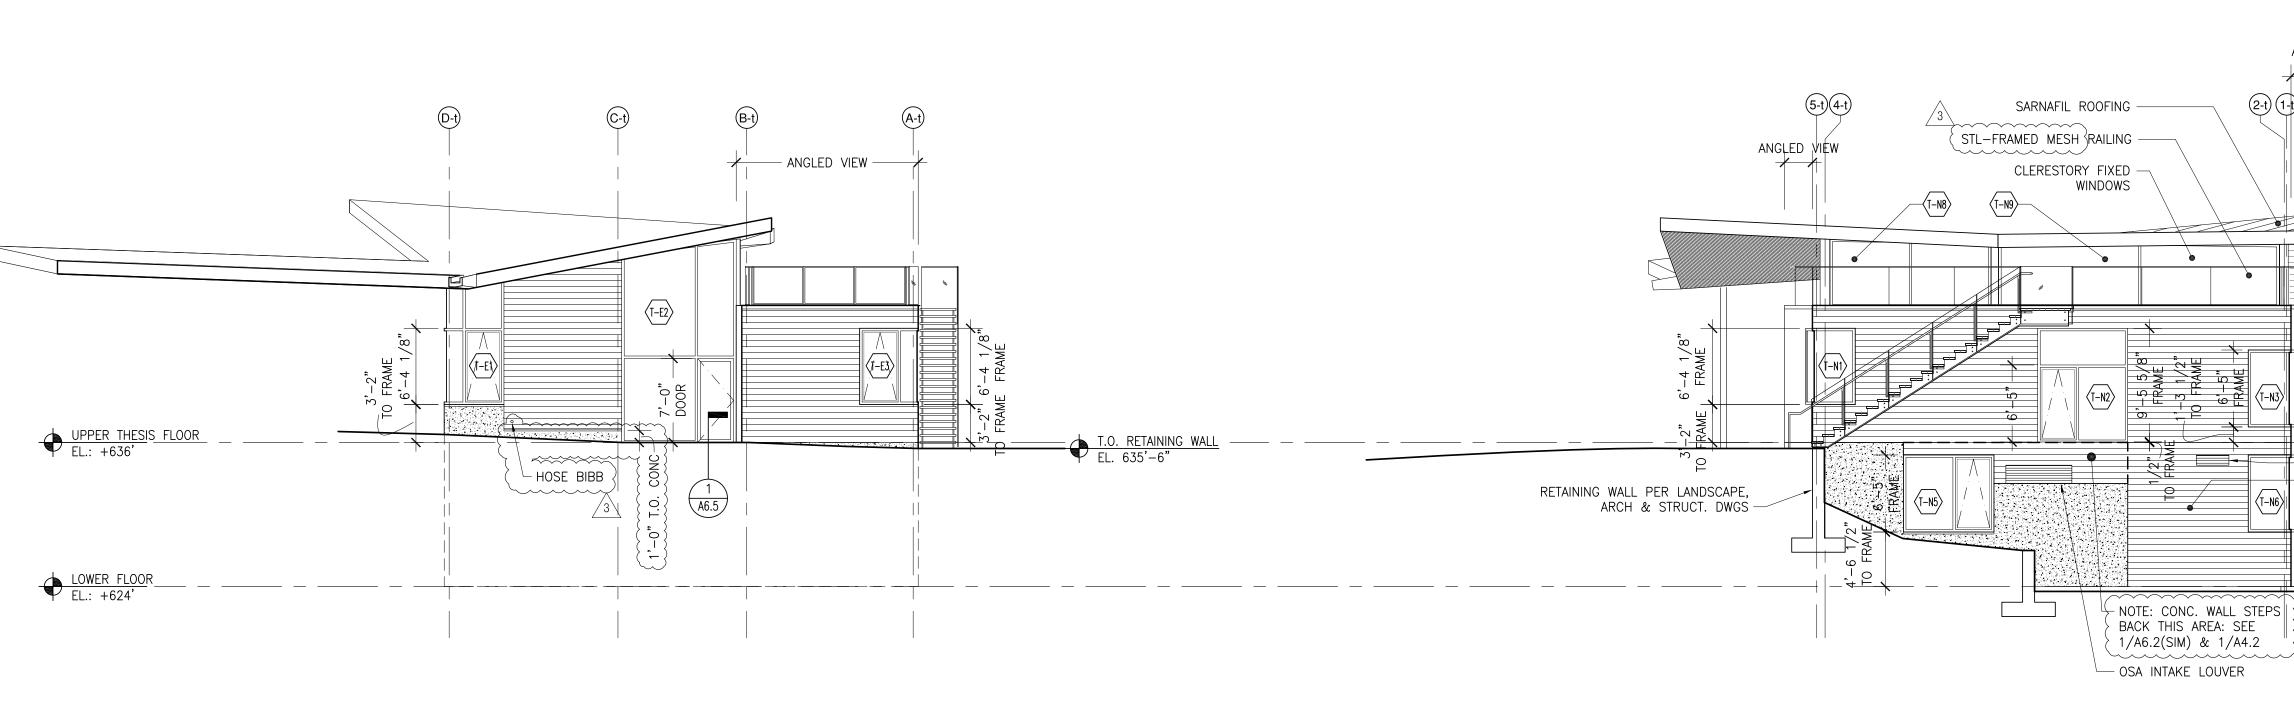

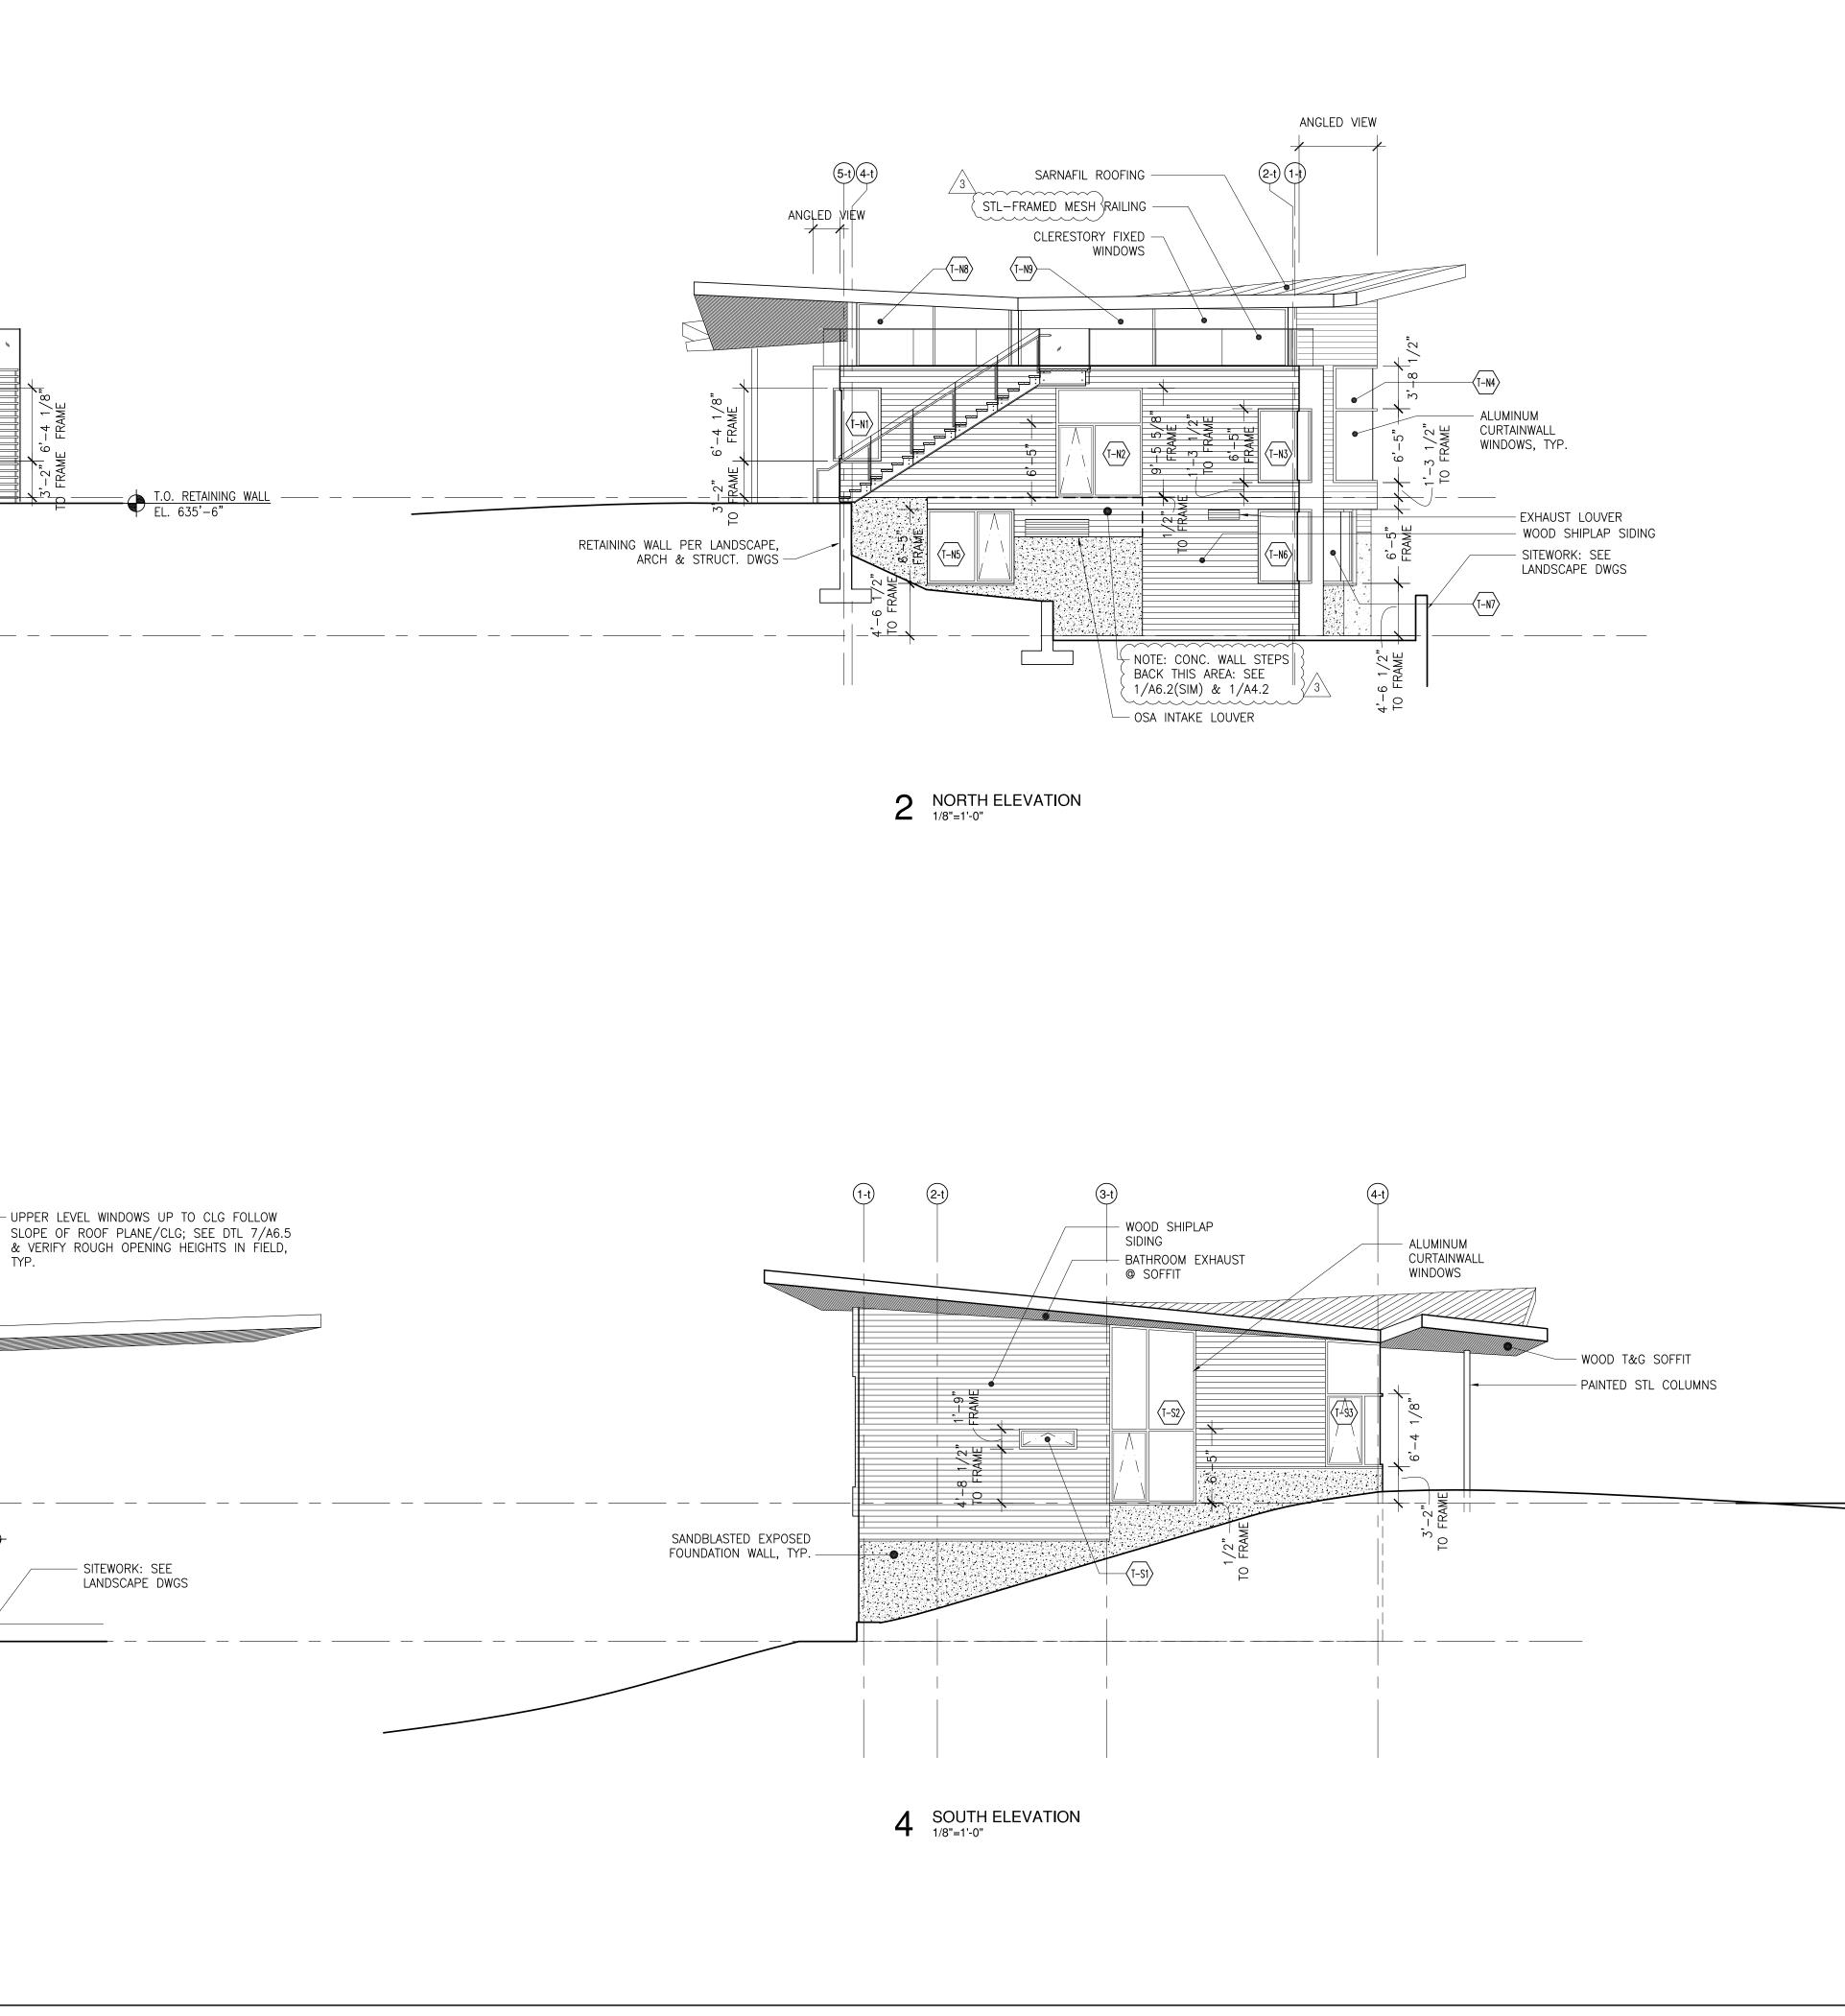


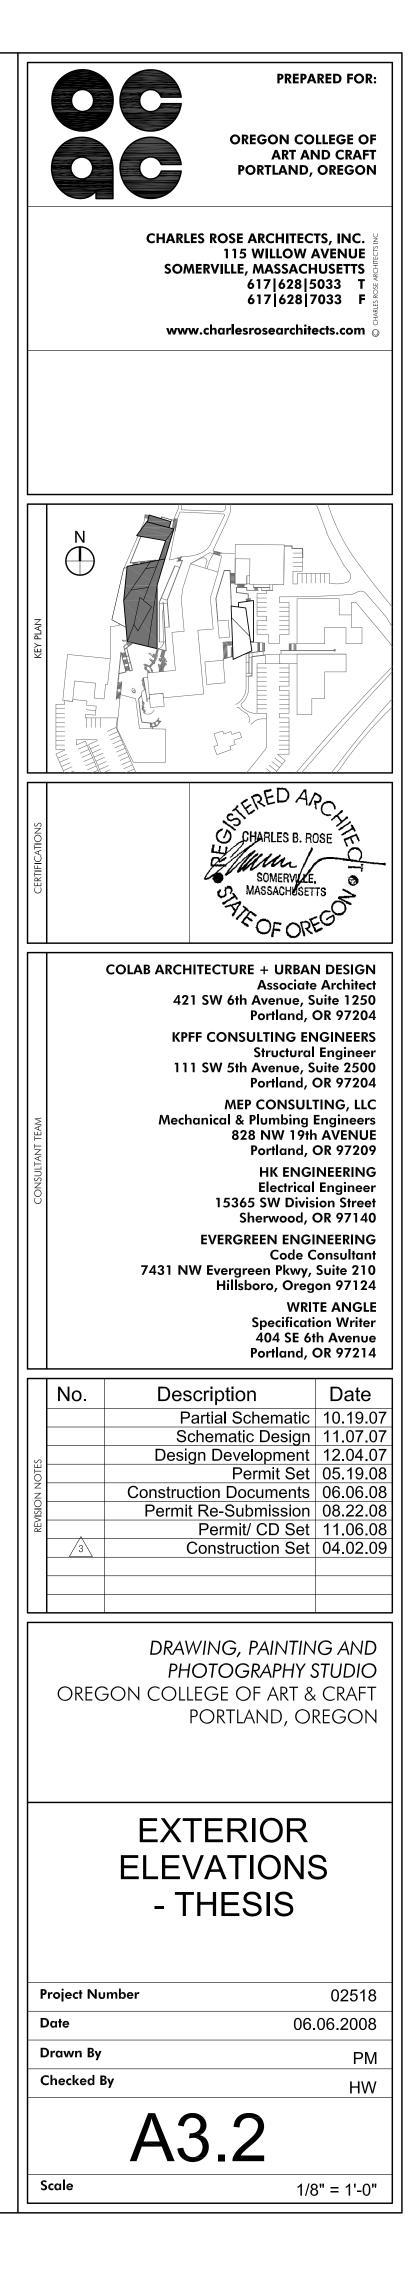

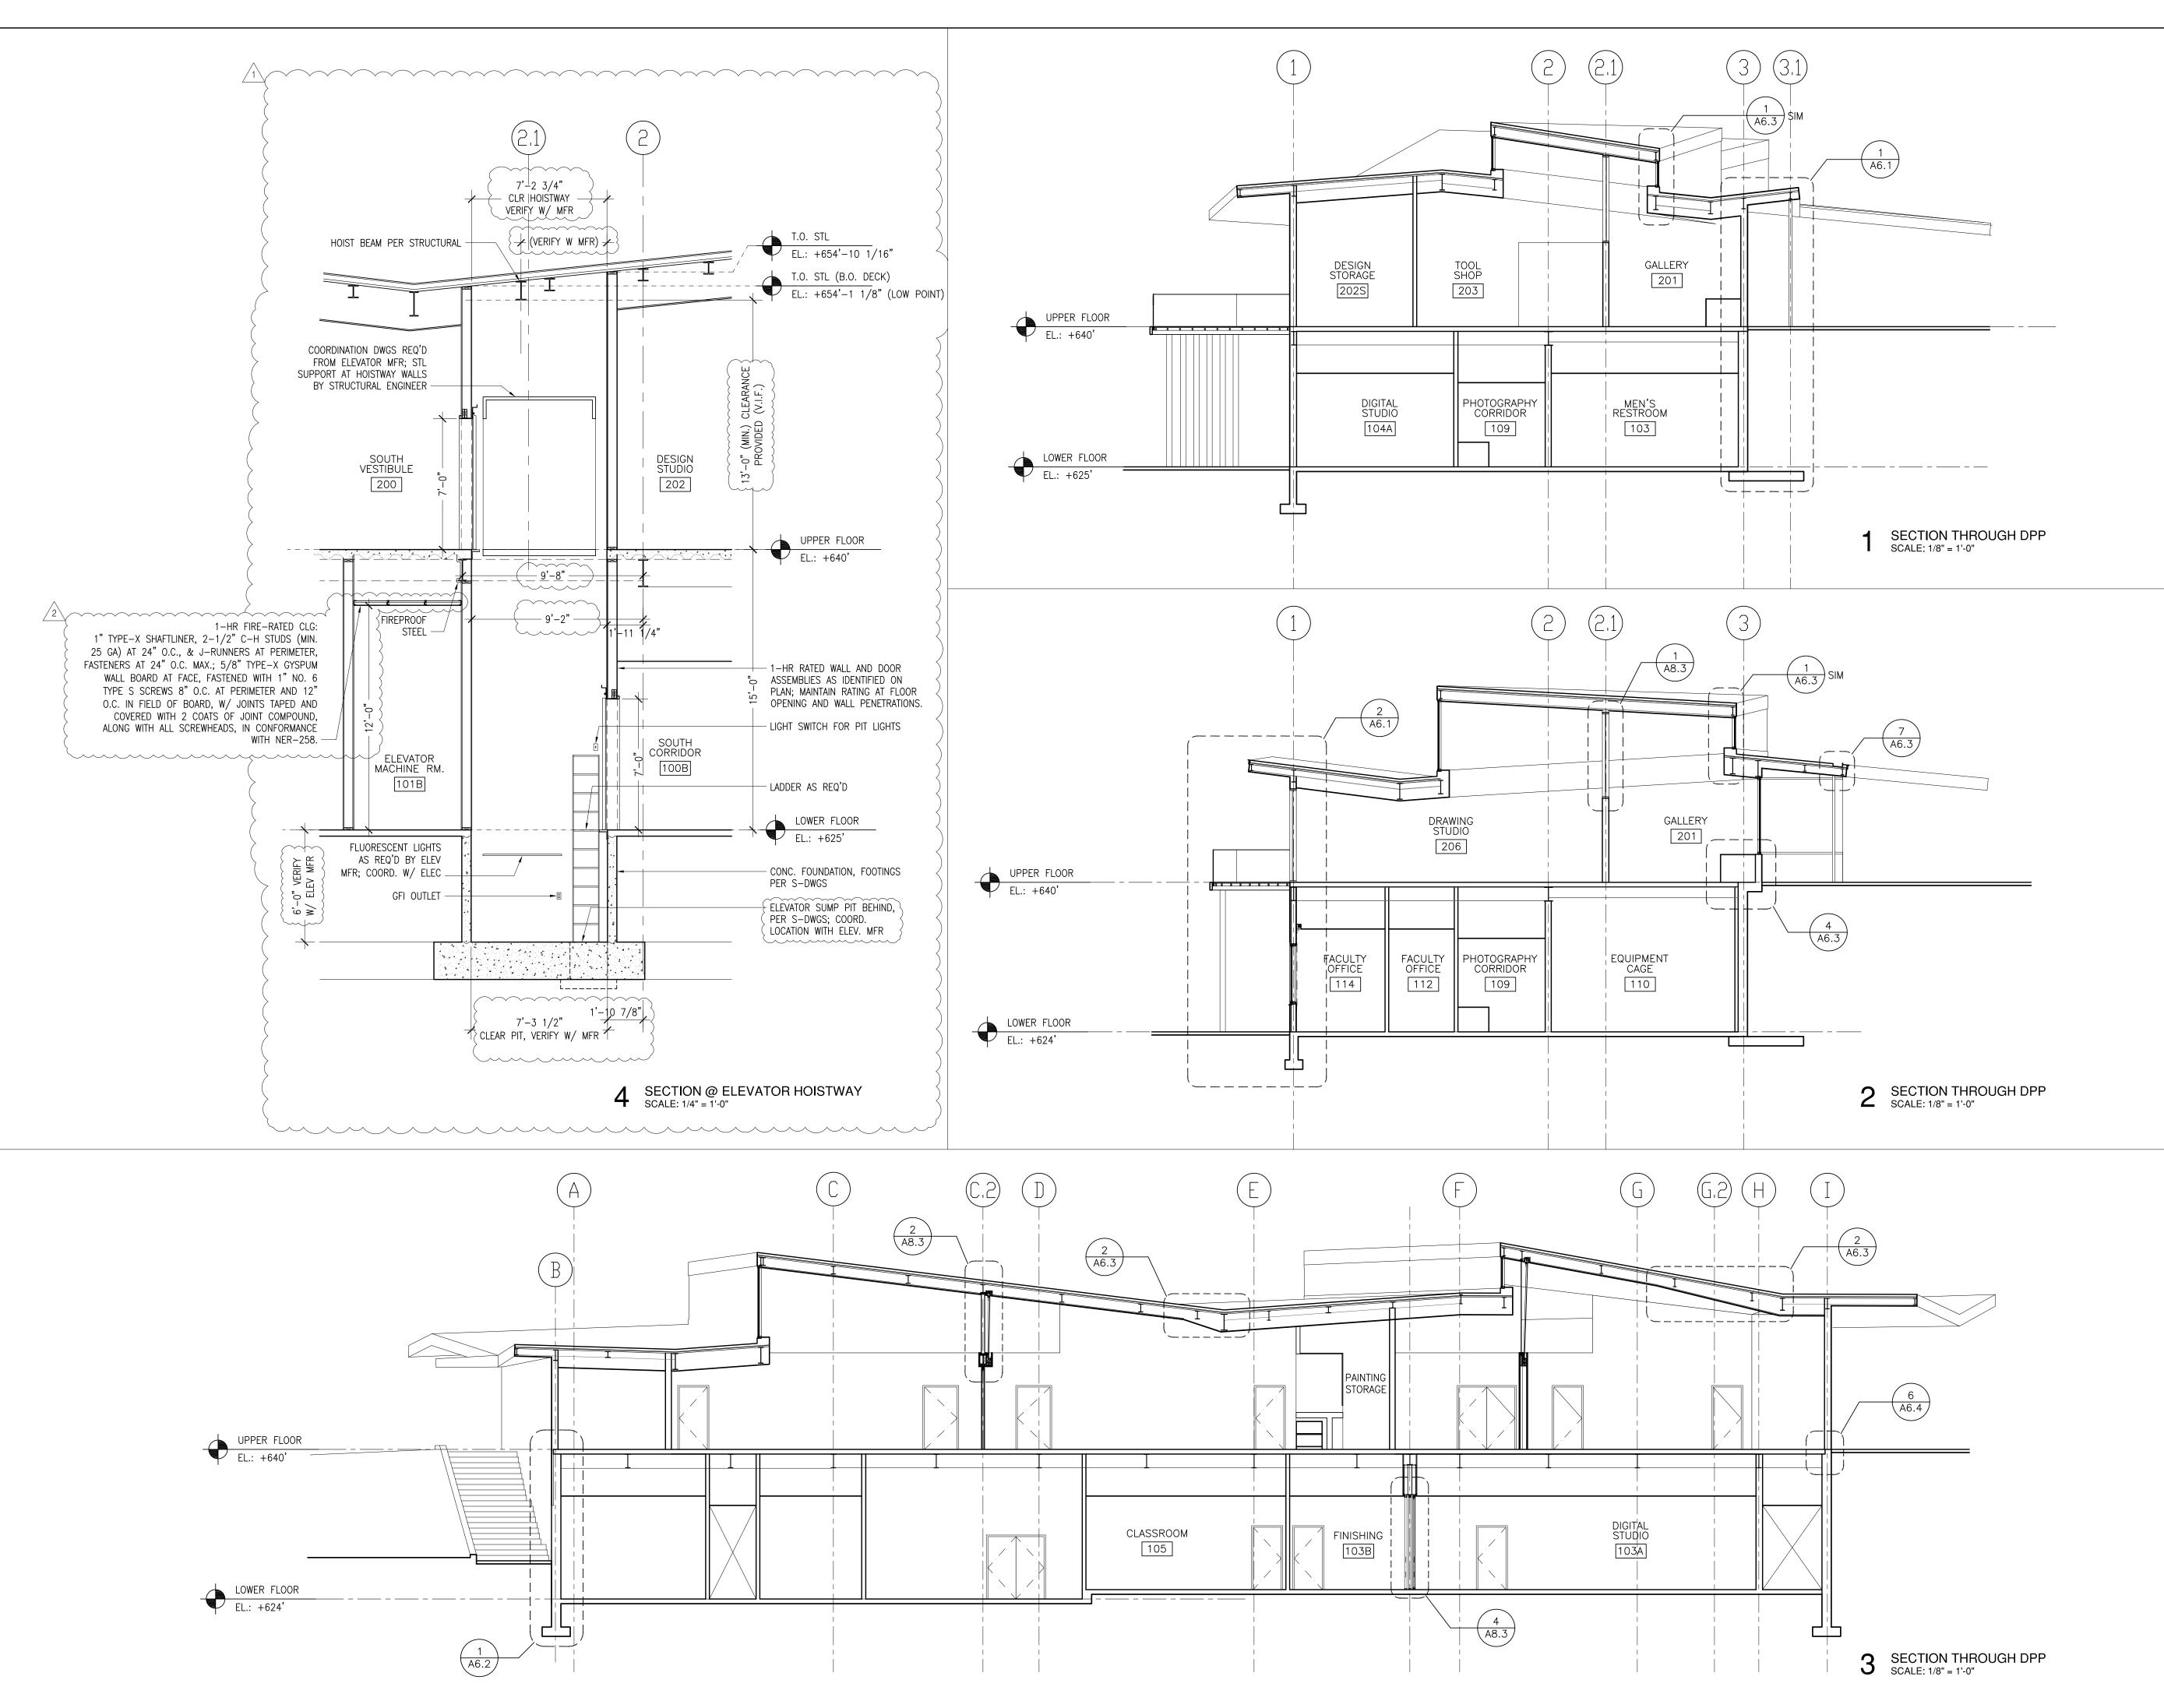


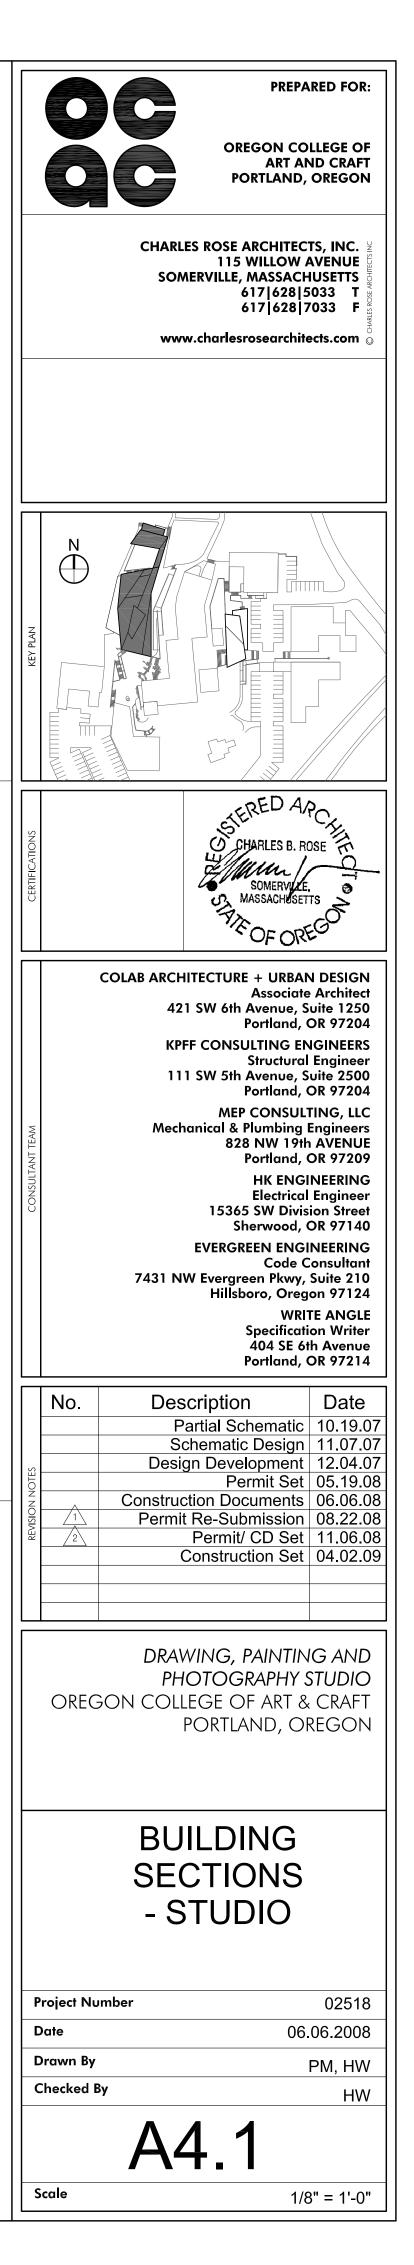


3 SECTION THROUGH THESIS BLDG LOOKING NORTH

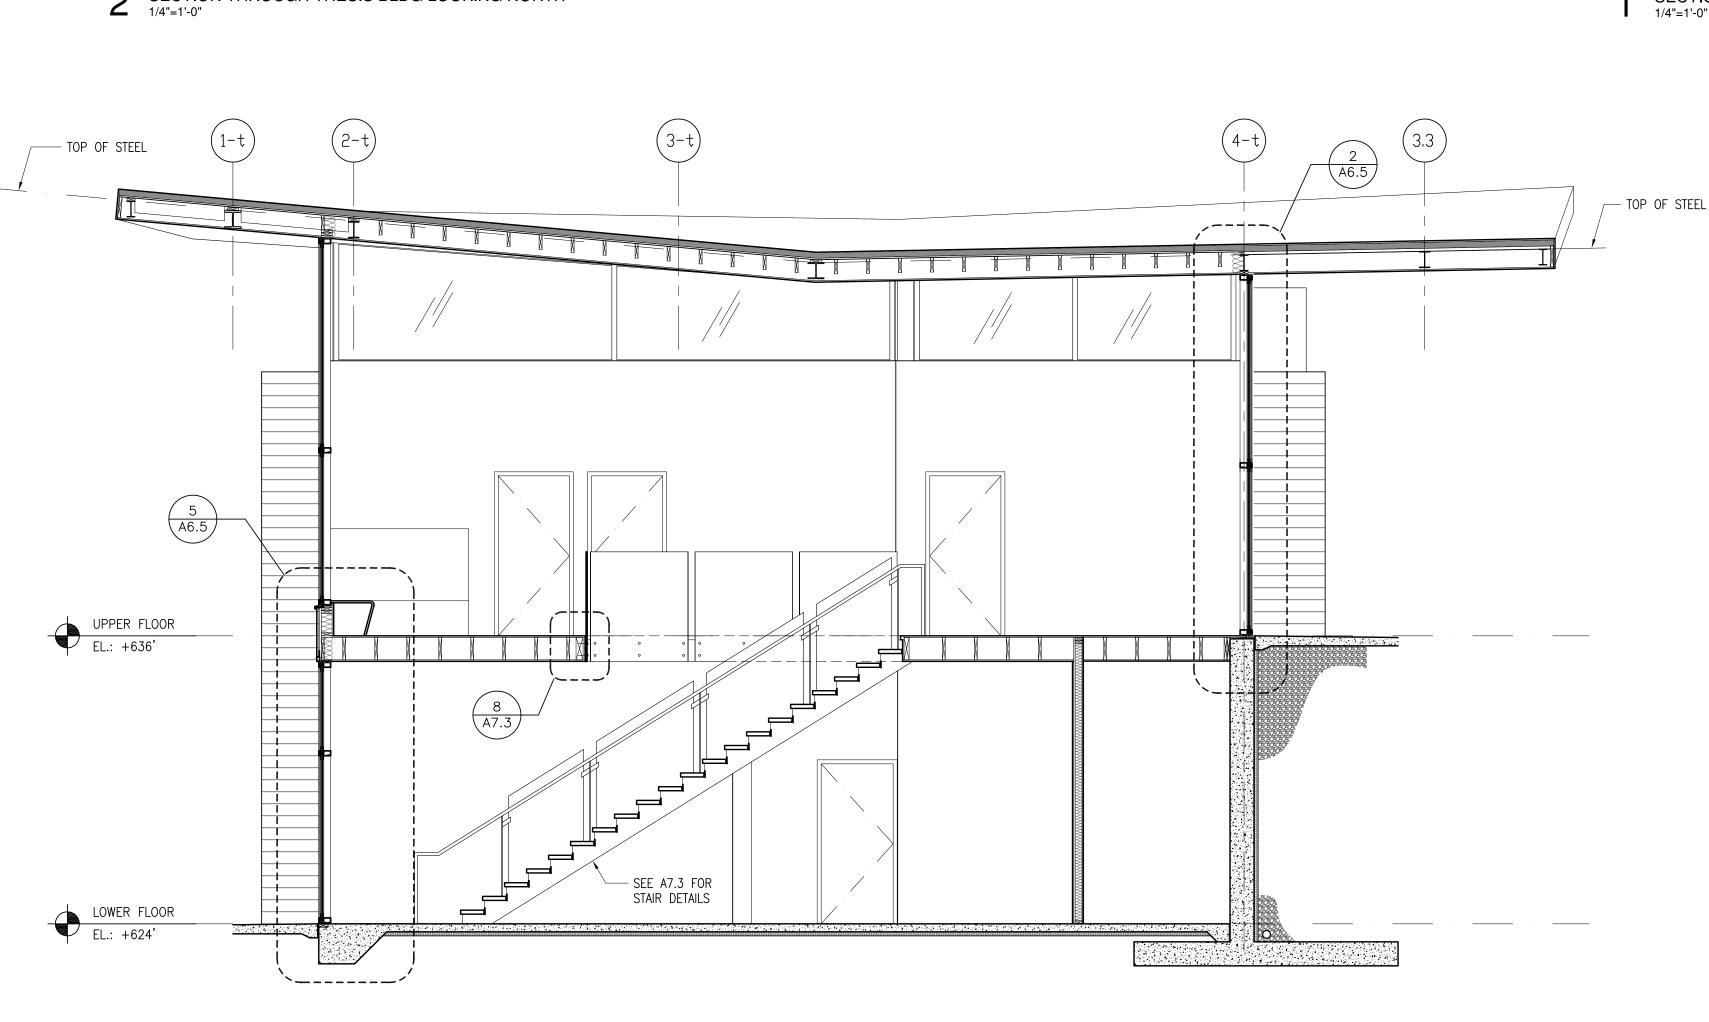


2 SECTION THROUGH THESIS BLDG LOOKING NORTH 1/4"=1'-0"

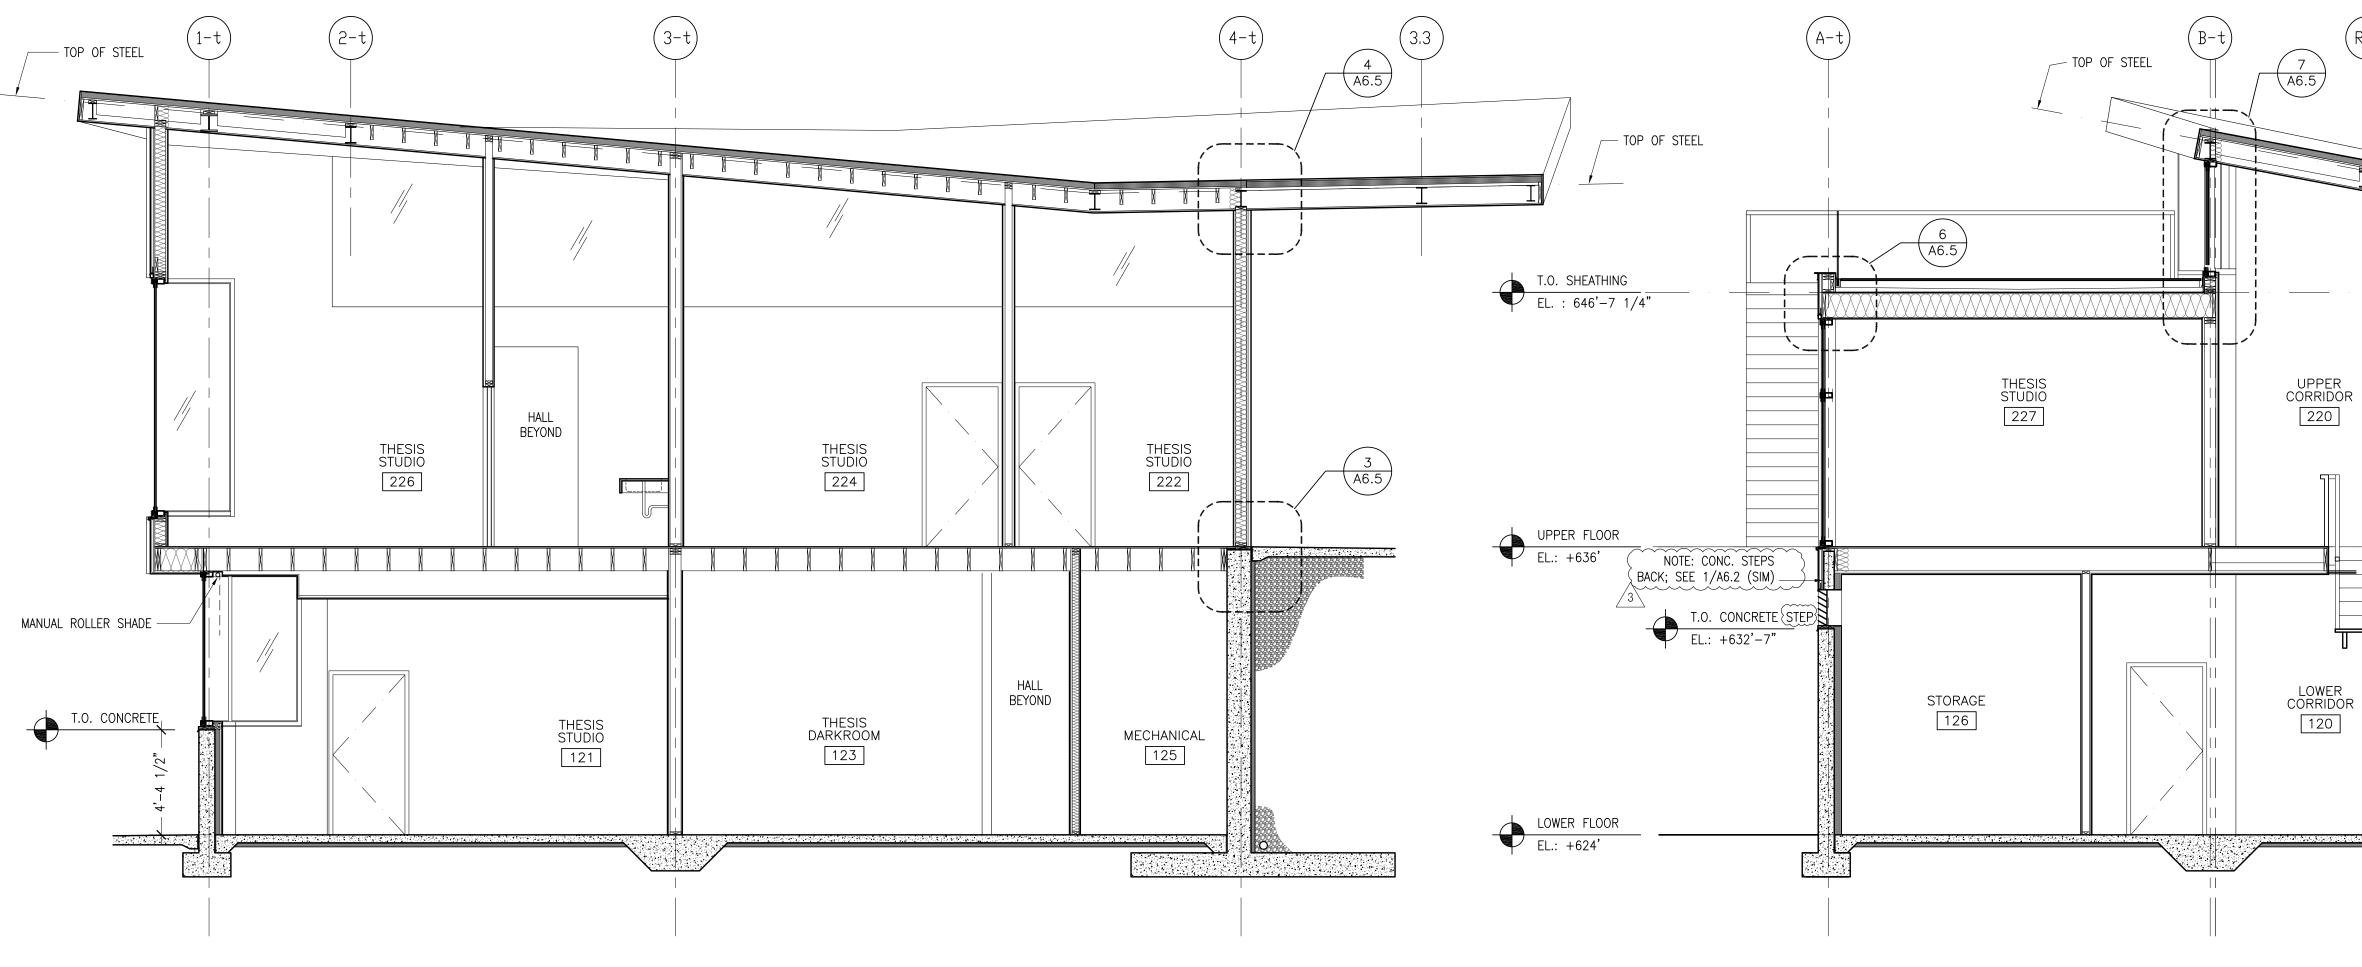



SECTION THROUGH THESIS BLDG LOOKING EAST 1/4"=1'-0"

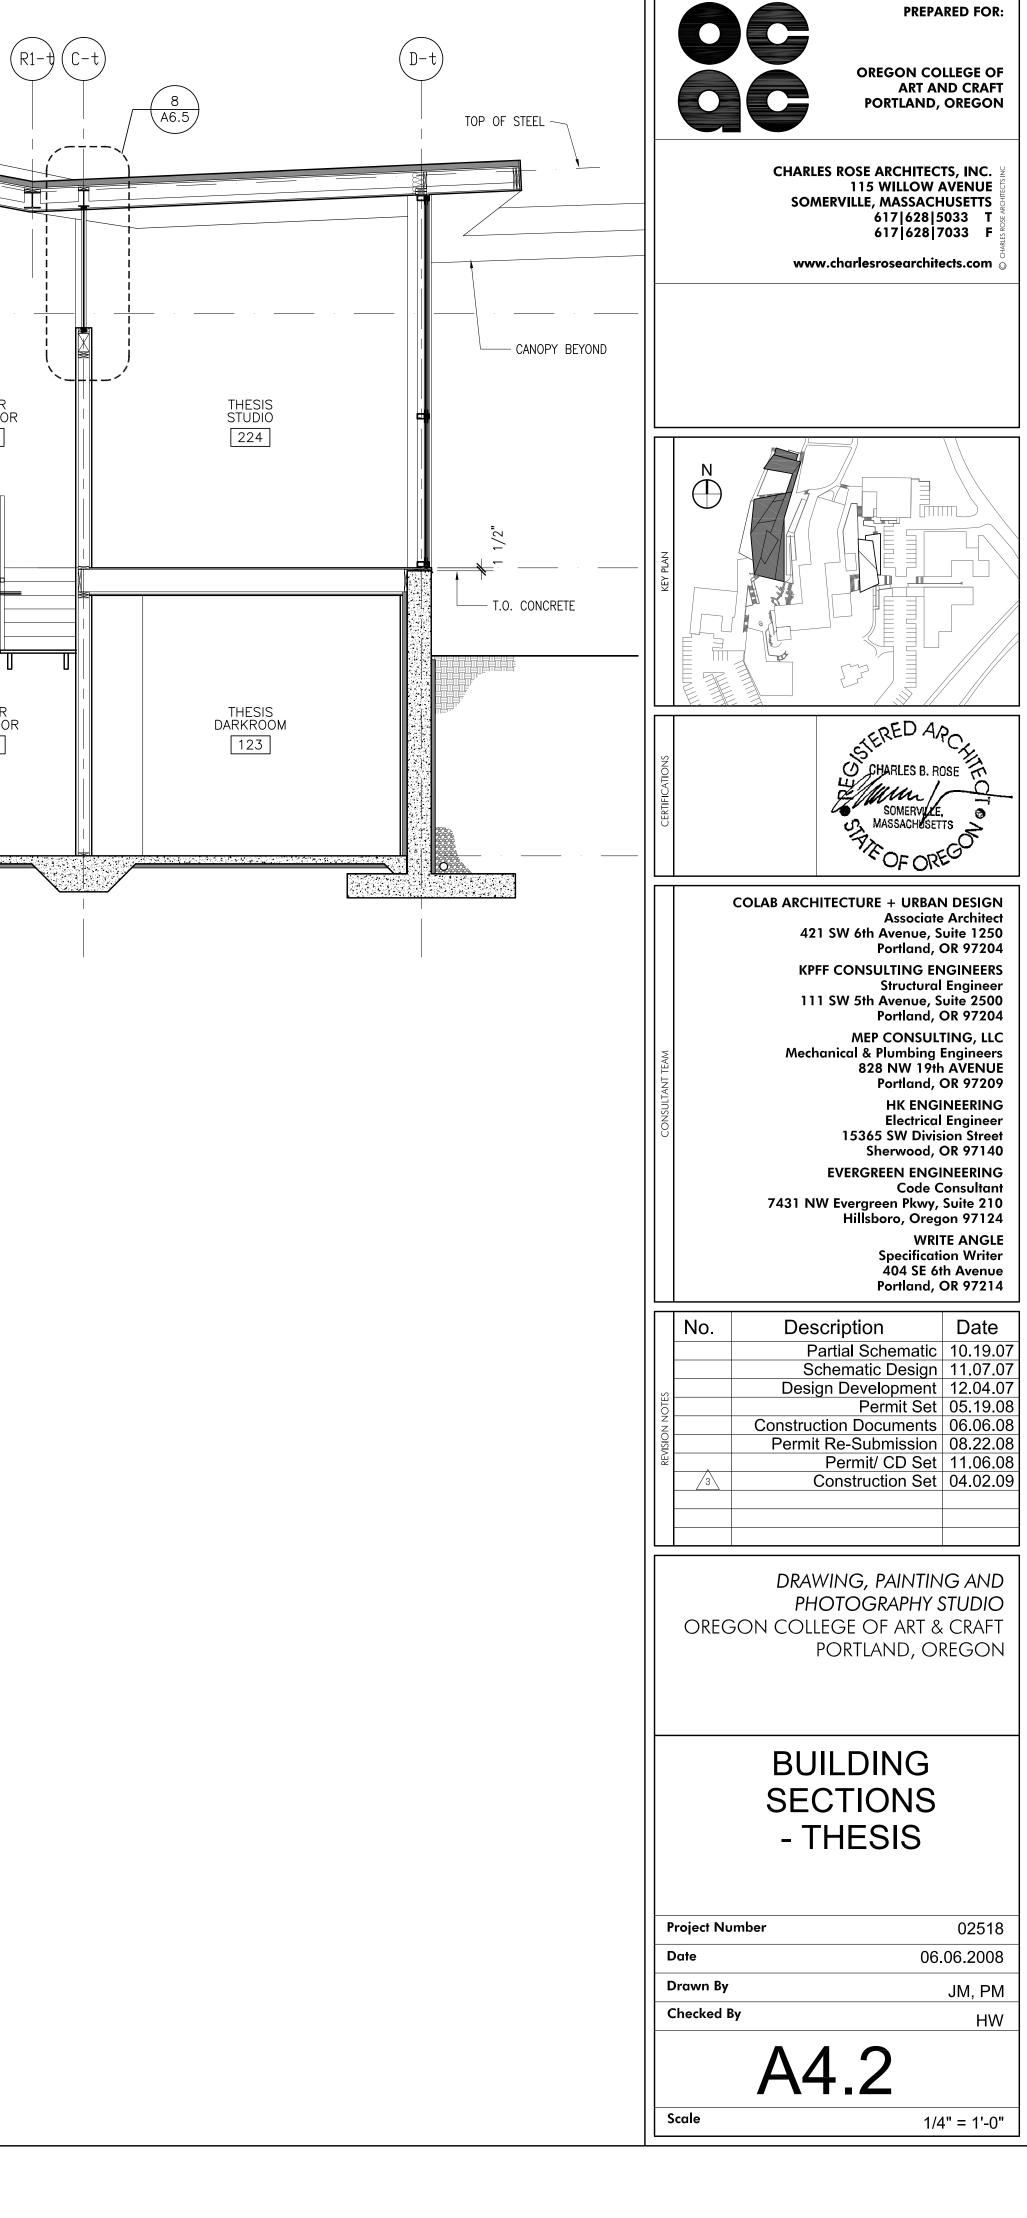


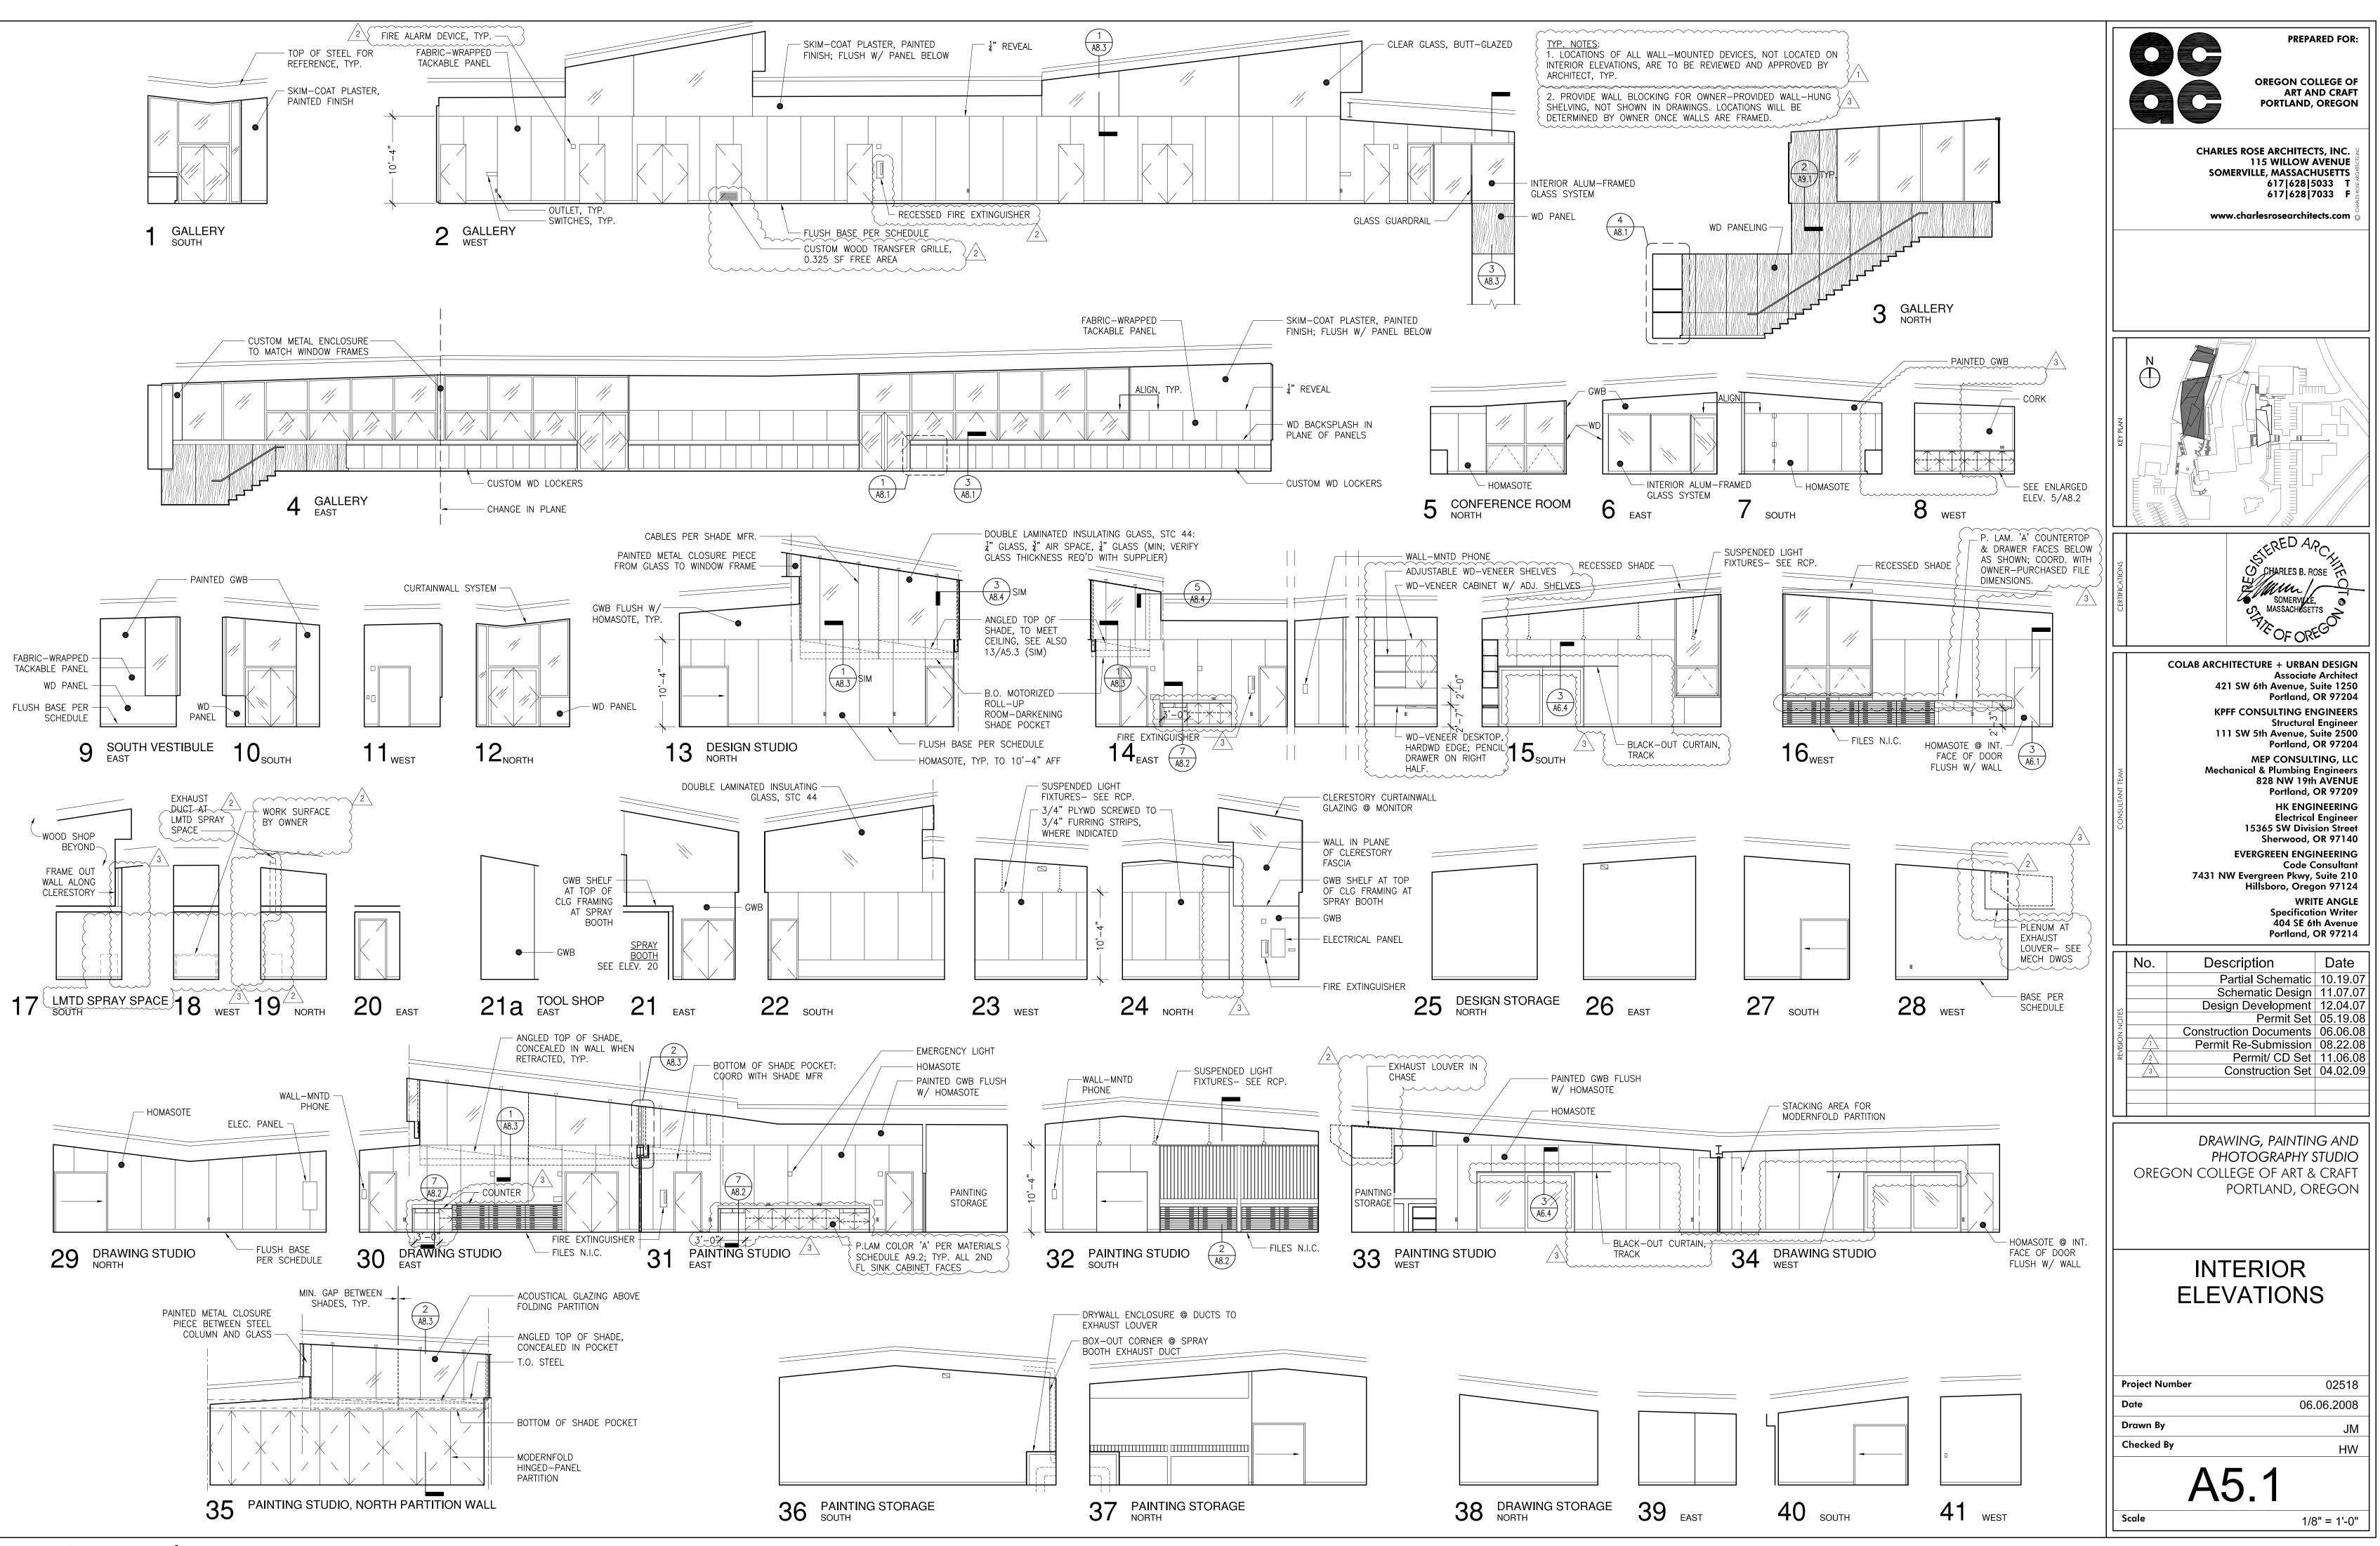



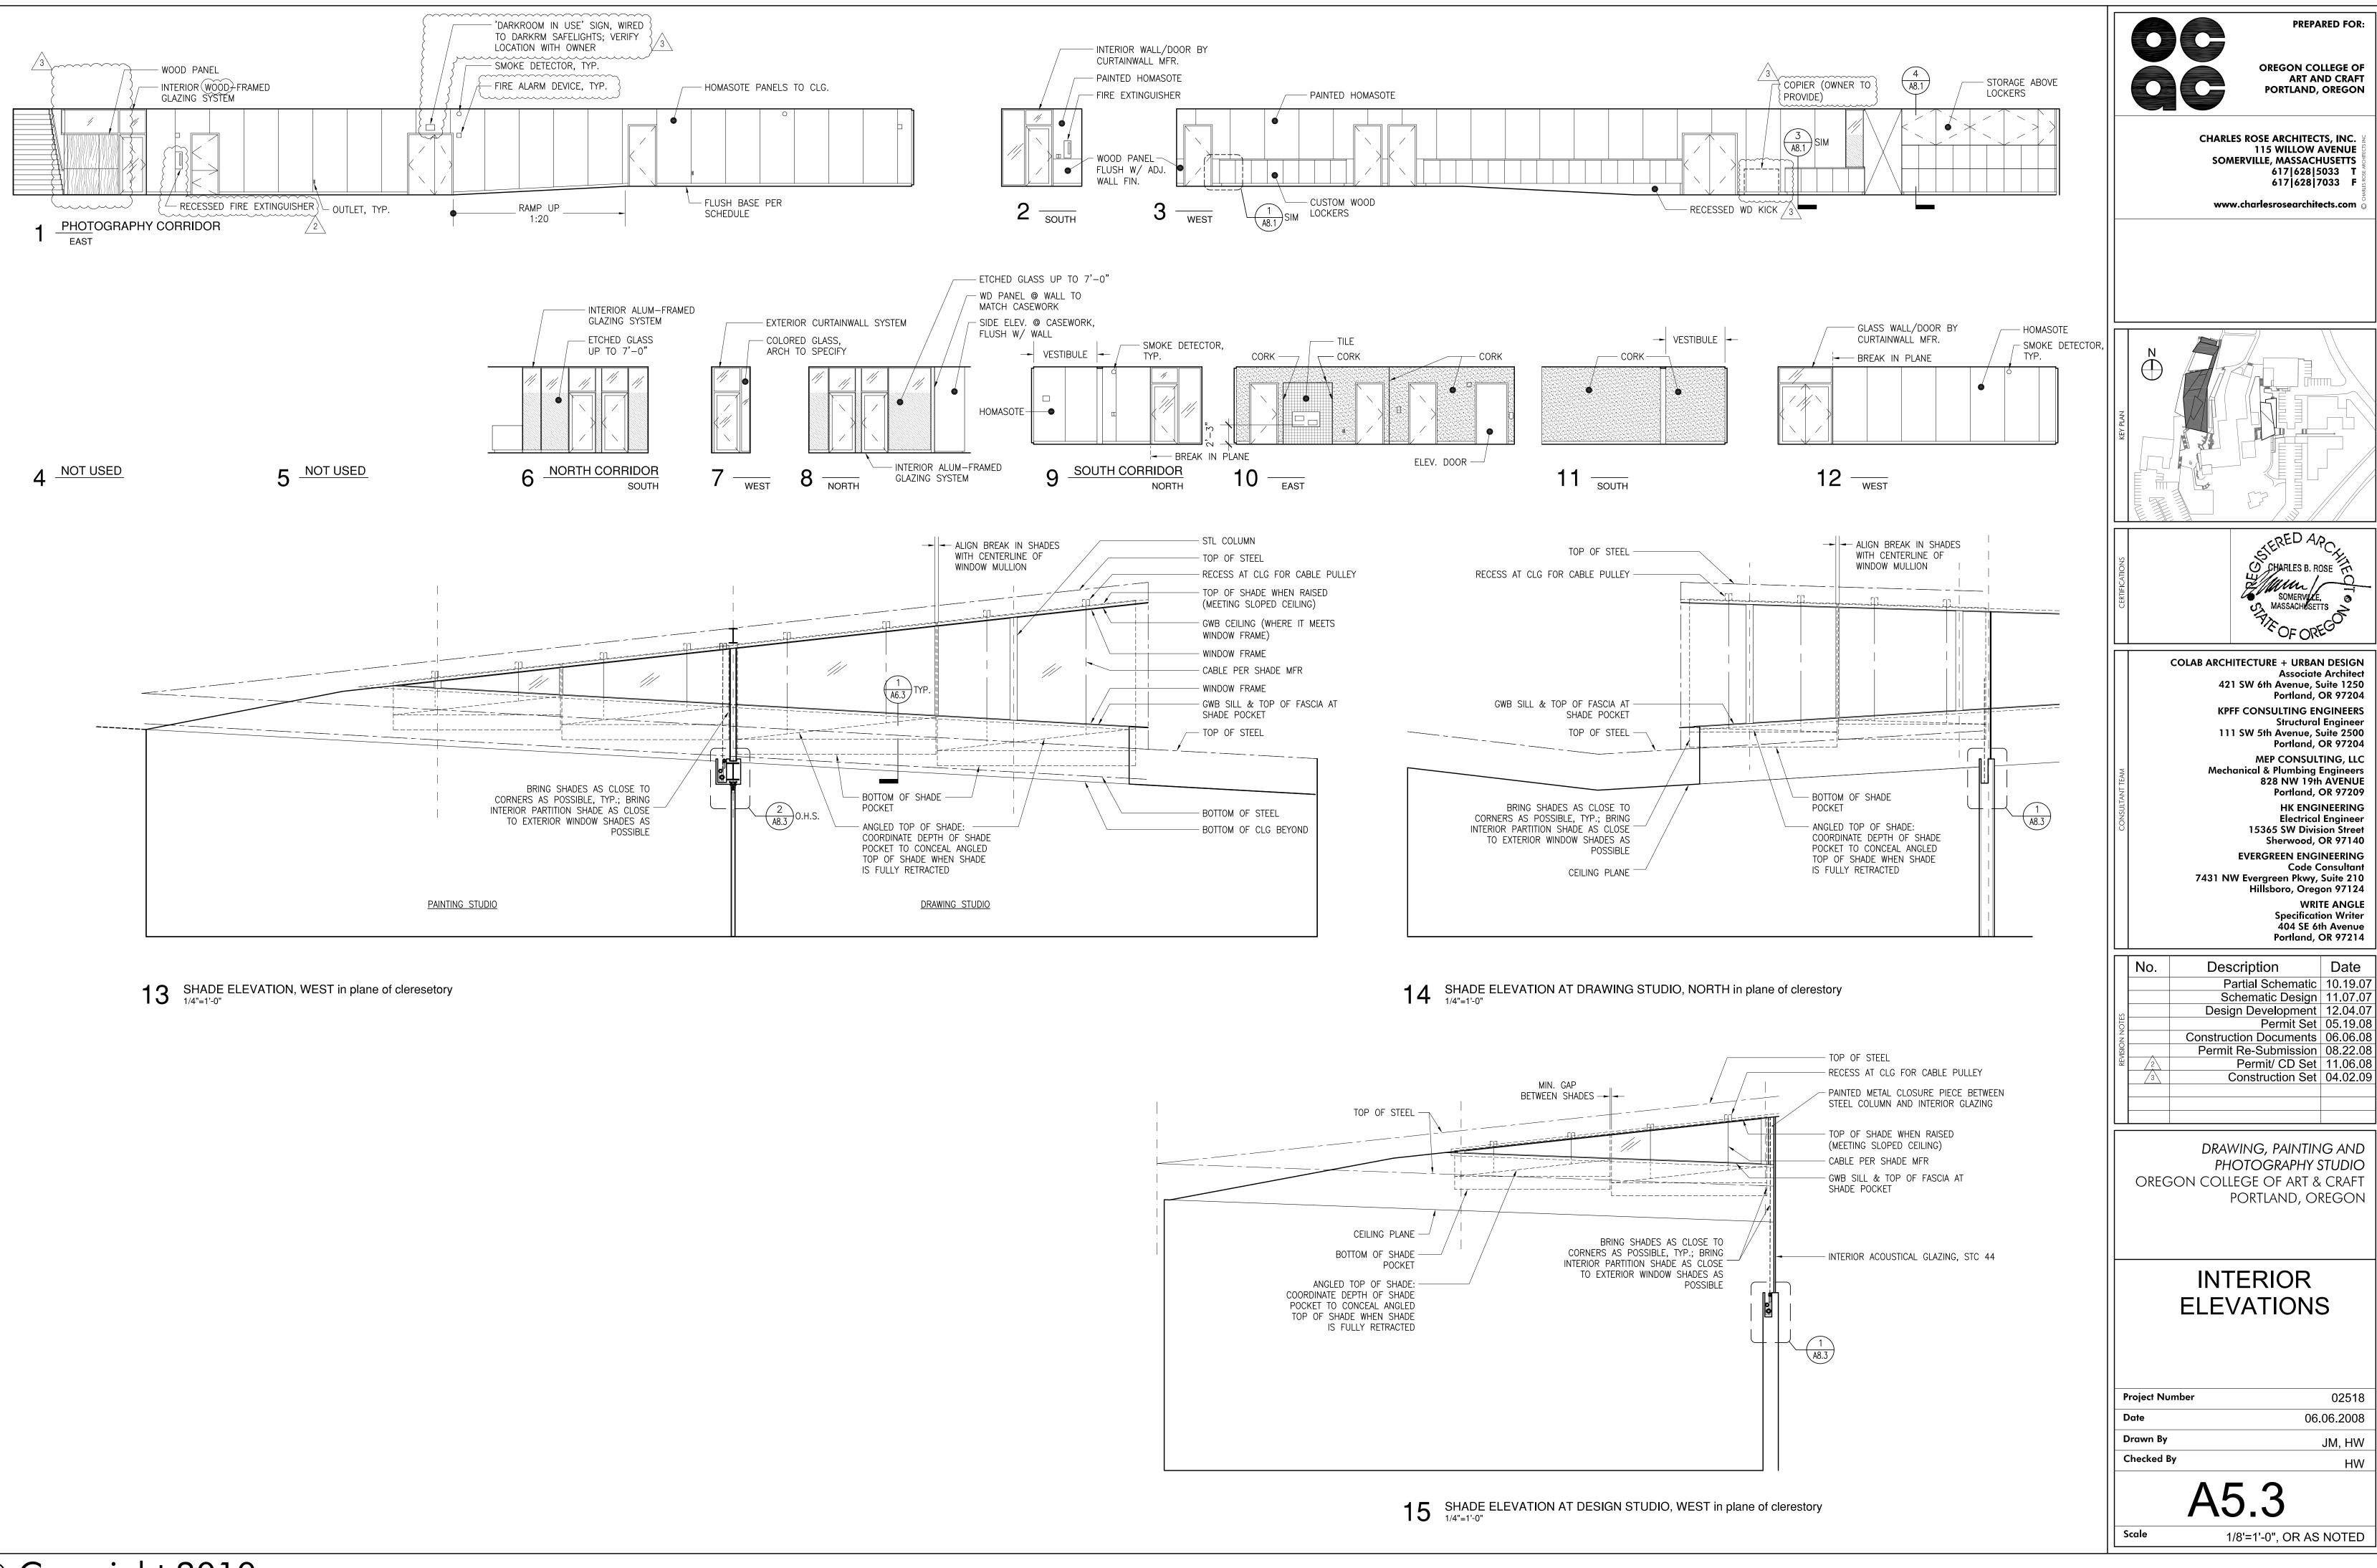

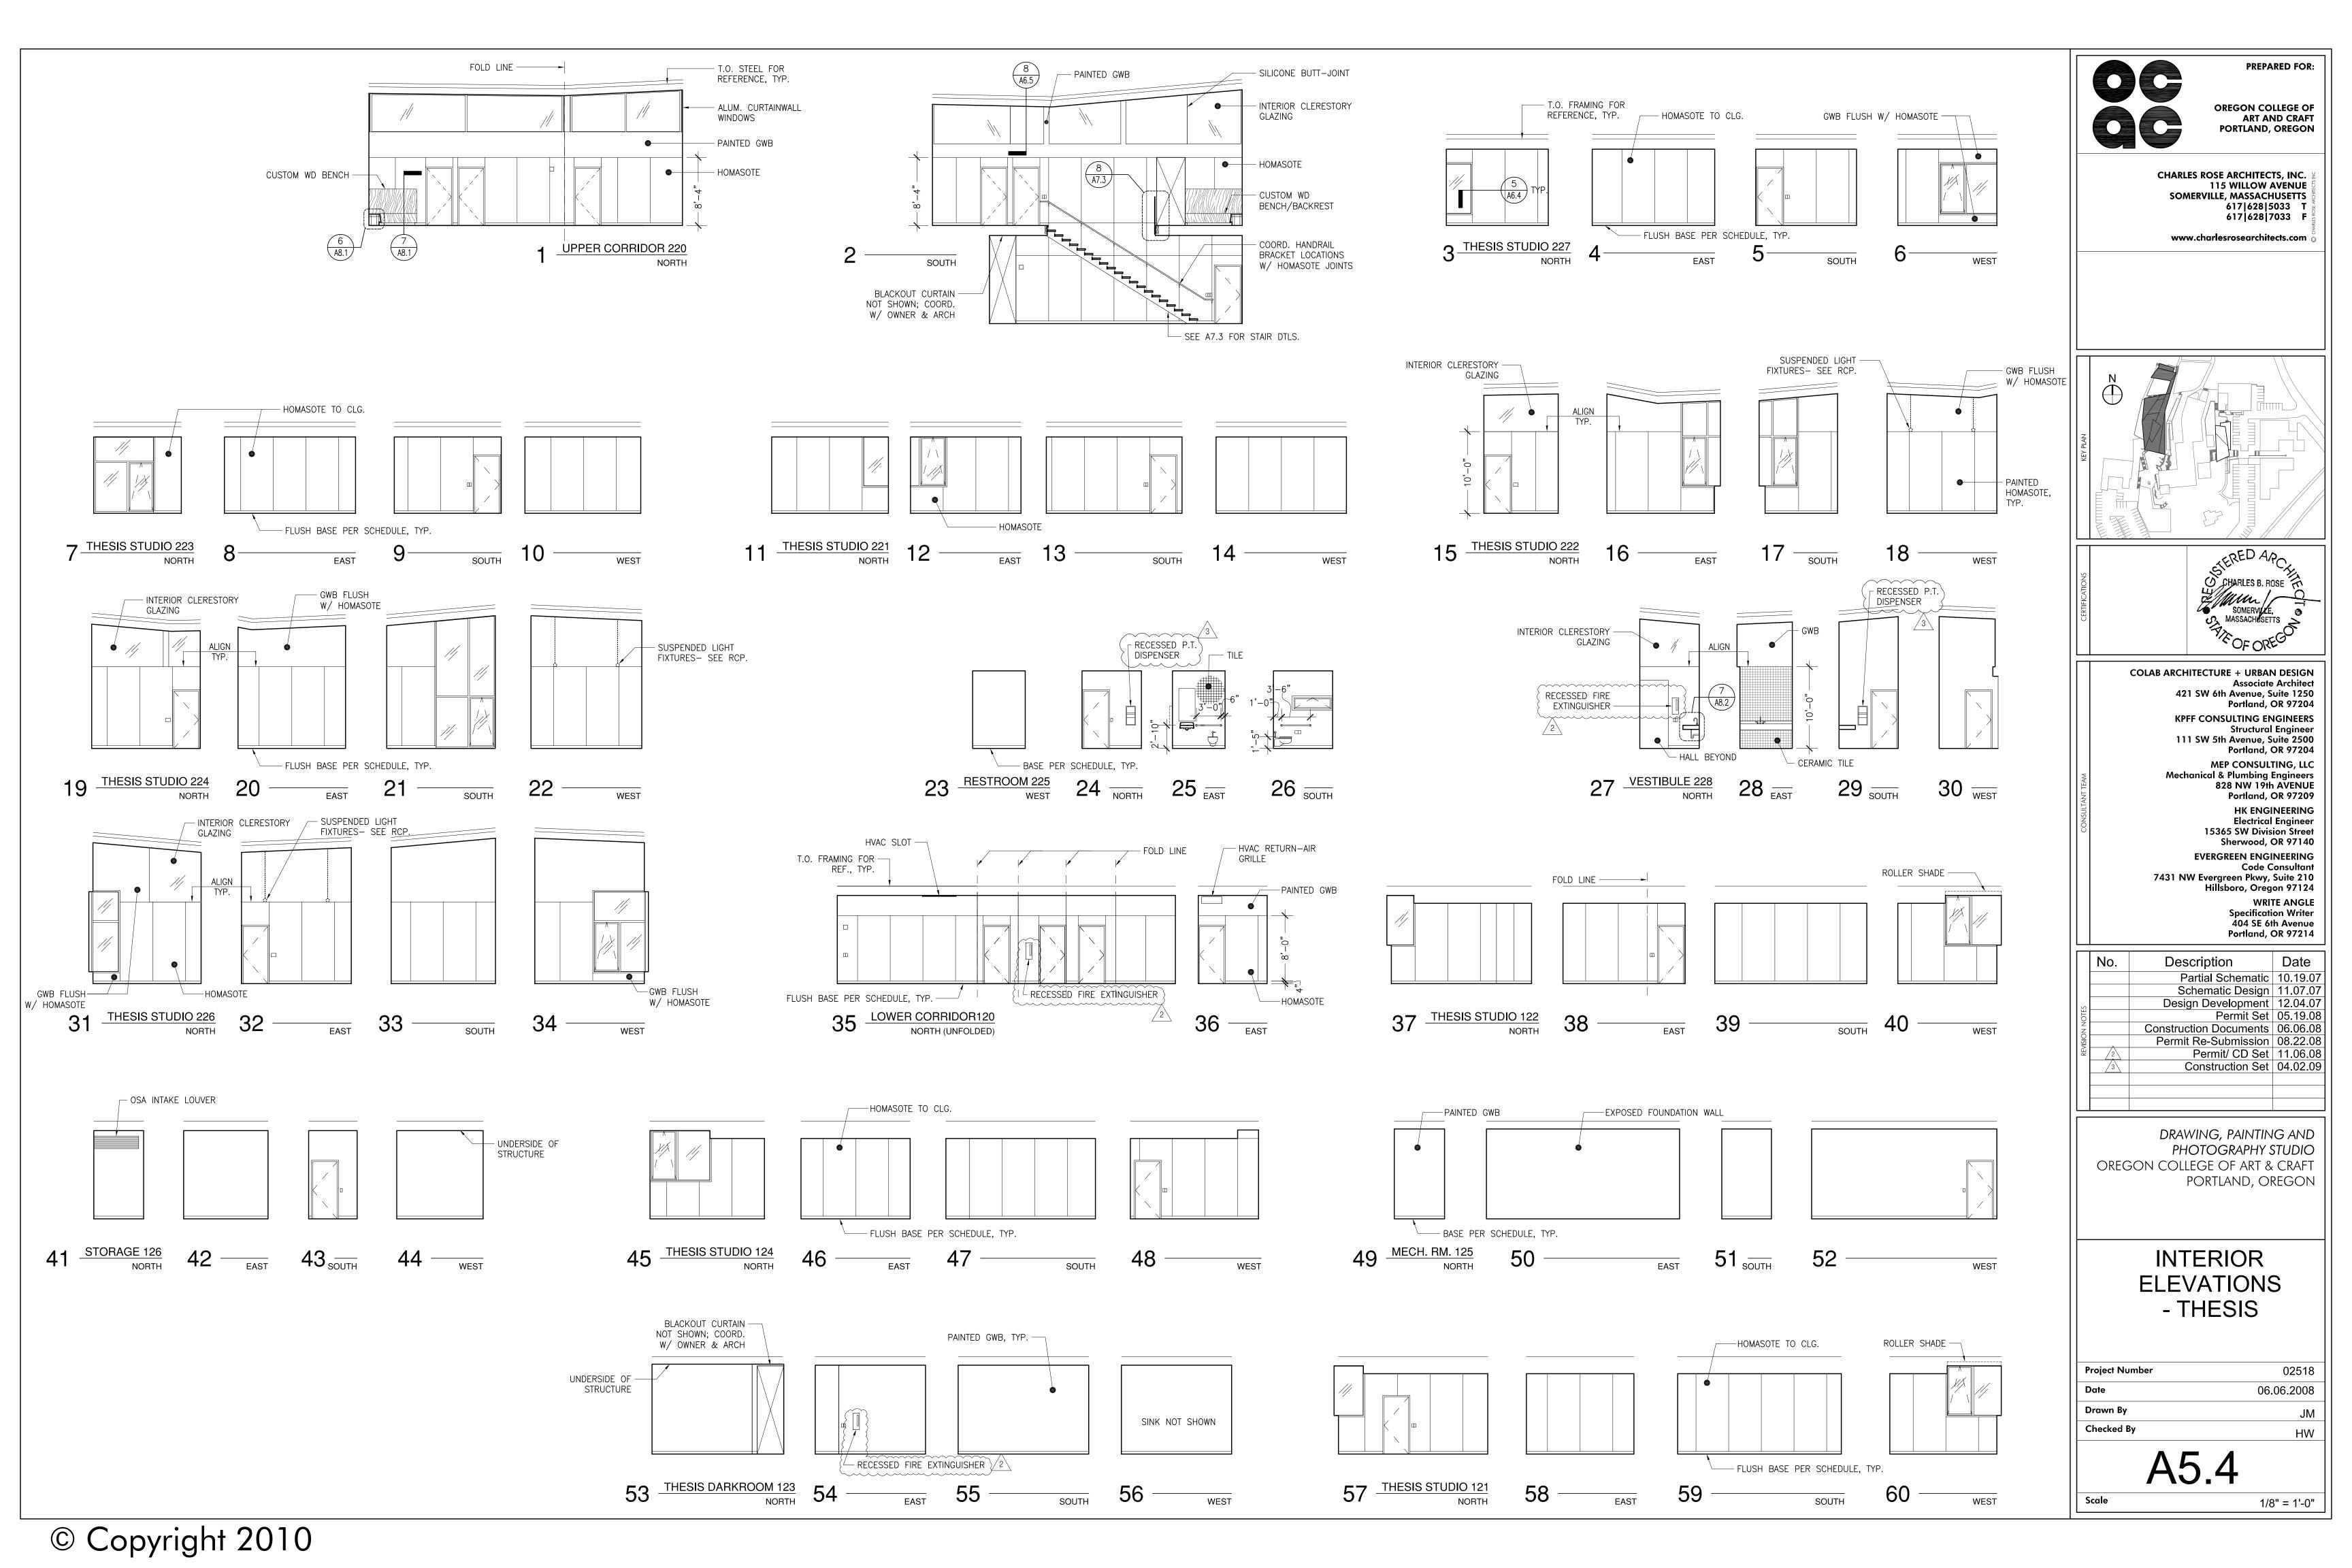

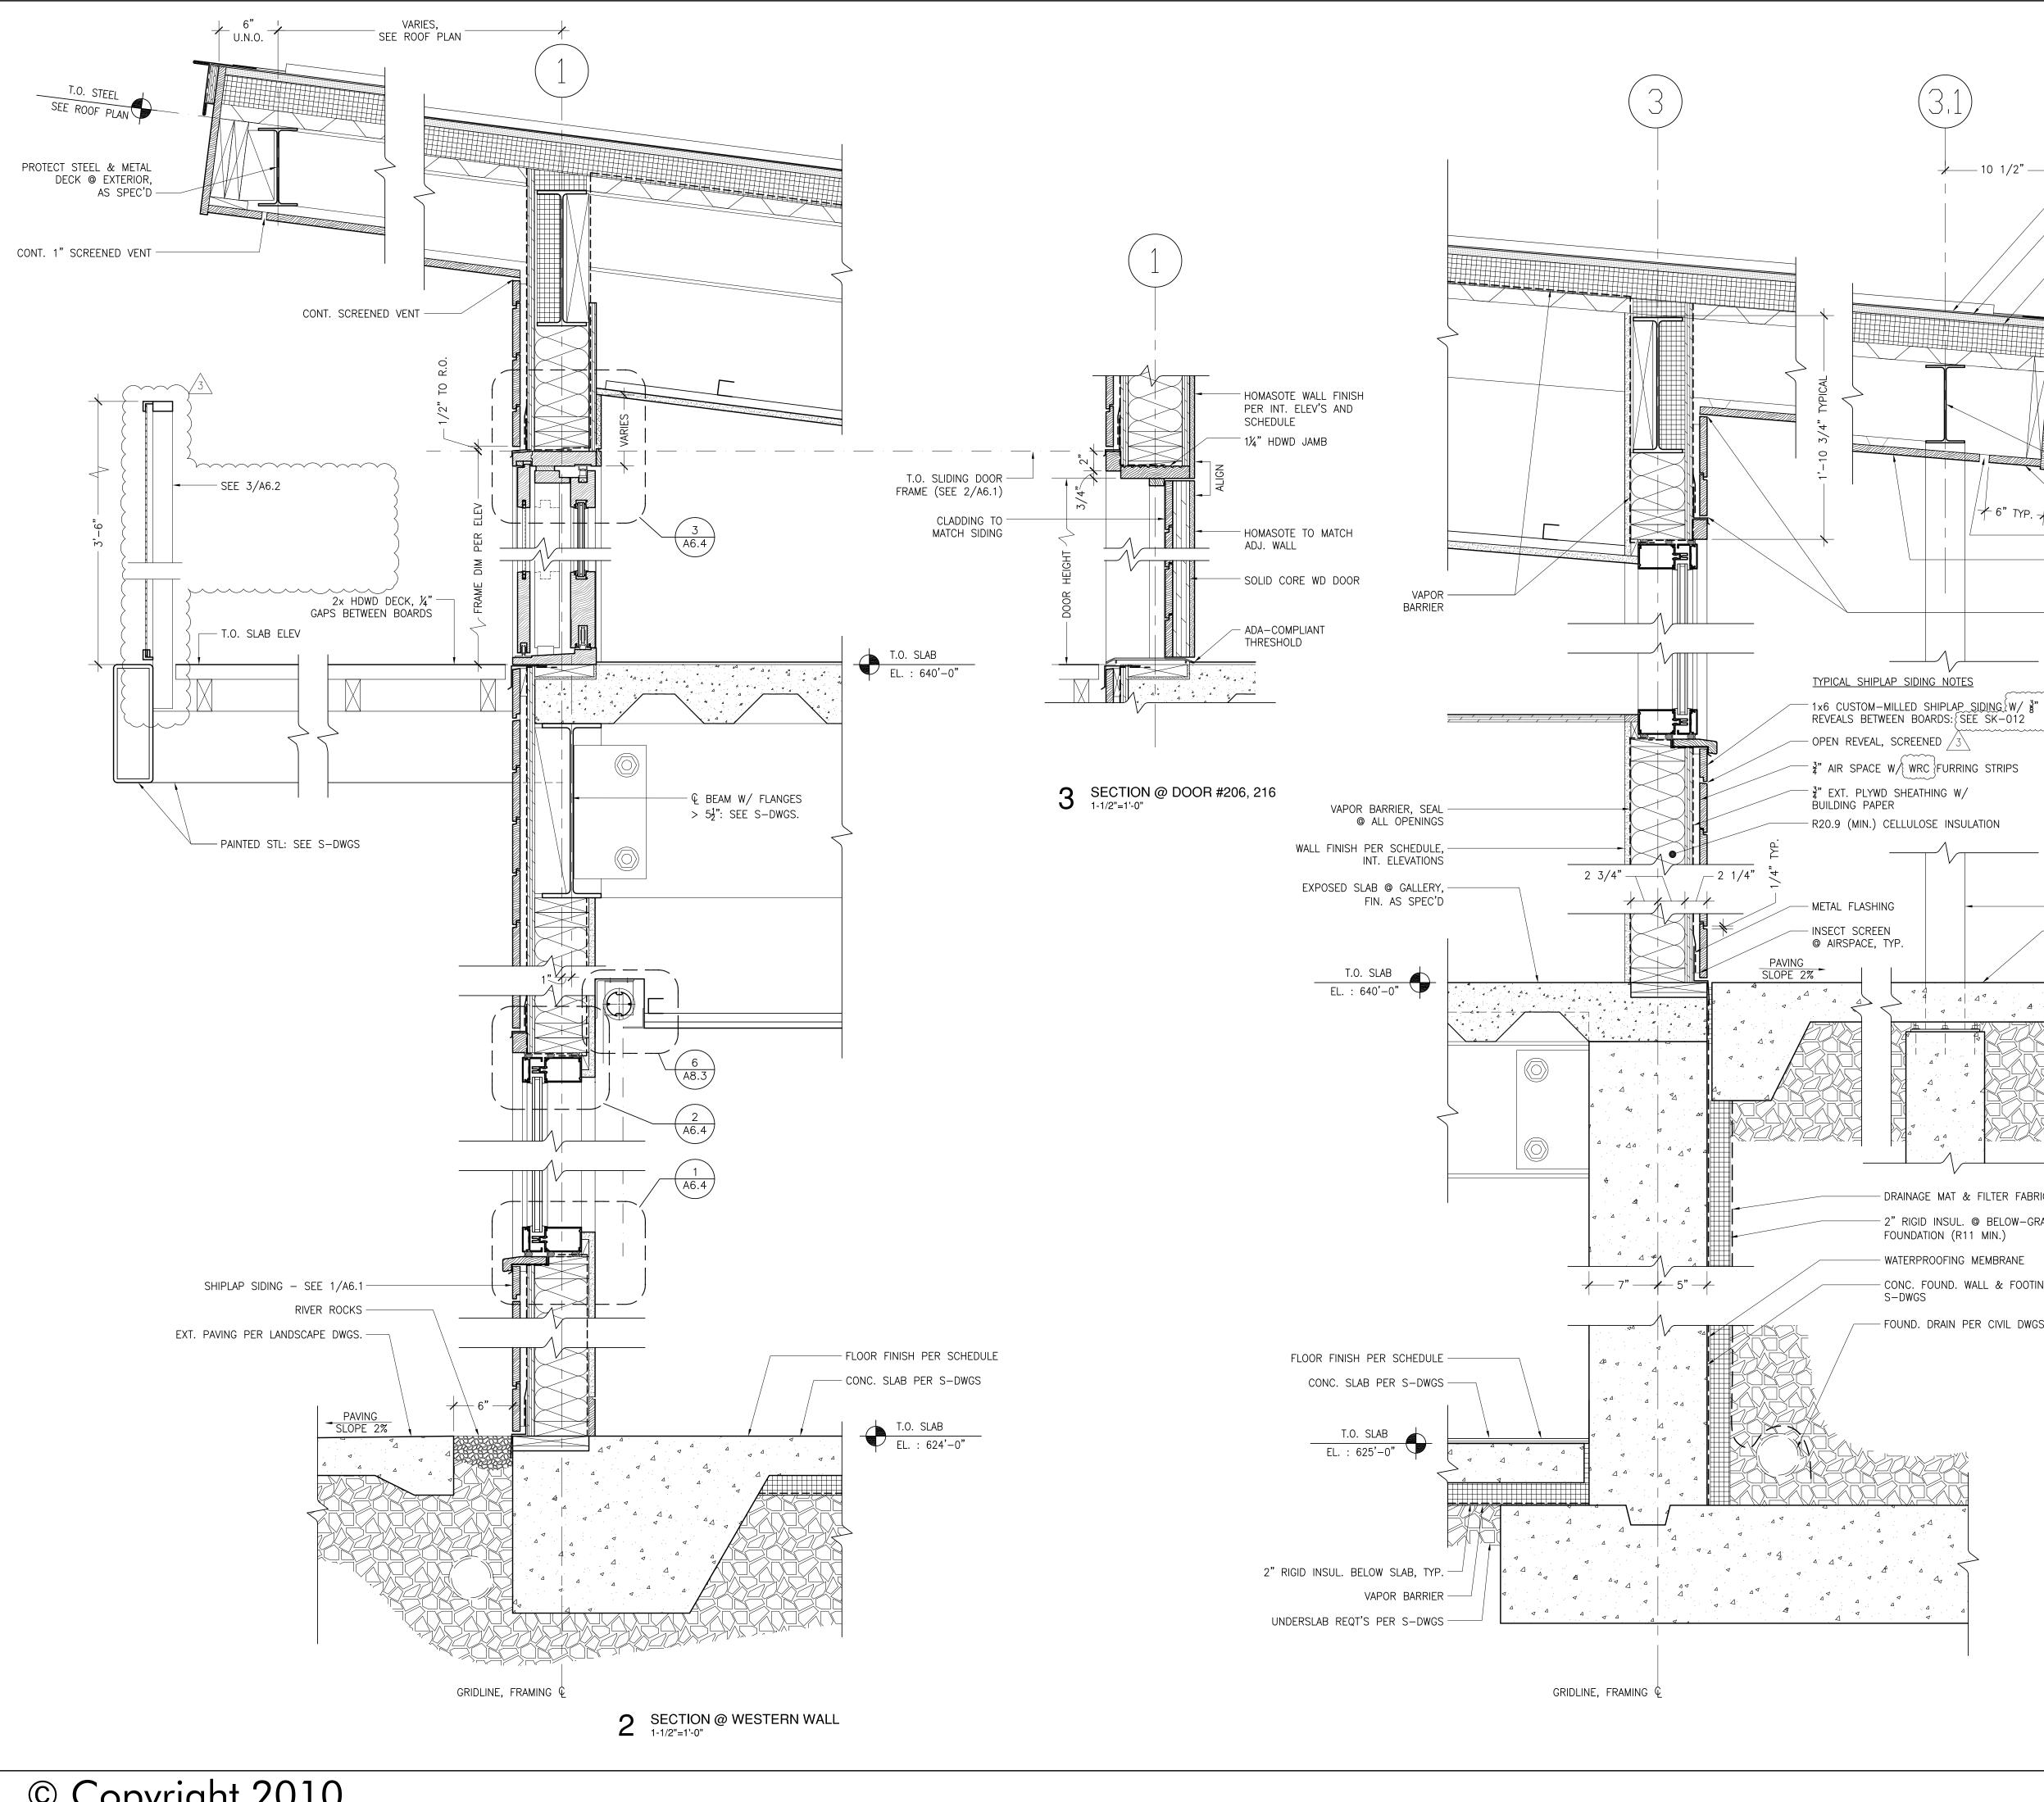

RIC
ING PER
GS
SECTION @ GALLERY WALL 1-1/2"=1'-0"

HDWD FASCIA HDWD TRIM BOARD / * 6" TYP. * CIRCULATION @ EAVE - CONT. SCREENED VENT (OPEN REVEAL) - STL COL. PER S-DWGS, PAINTED - EXT. PAVING PER LANDSCAPE DWGS. $\Delta | \Delta^{\triangleleft}$. 4

STEEL & METAL DECK @ EAVES TO BE PROTECTED PER STRUCT. & PAINTING SPEC'S. - CONT. 1" SCREENED VENT - HDWD T&G 4" BOARDS; BLOCKING OR FURRING AS REQ'D. MAINTAIN AIR

TYPICAL ROOF NOTES

MEMBRANE OVER PLATE.

10 1/2" _____

 $\frac{1}{2}$

T.O. STEEL SEE ROOF PLAN

- METAL DRIP EDGE

AS SPEC'D: SUBMIT SHOP DRAWINGS

W/ SARNAFIL LOW-PROFILE PLATE

- 3" RIGID INSULATION: (R19, MIN.)

- MOCK-UP REQUIRED W/ ADHERED

SARNACLAD METAL FLASHING

- SARNAFIL ADHERED FELTBACK CLASS 'A' MEMBRANE

DENS-DECK SUBSTRATE: MECH. ADHERE

115 WILLOW AVENUE SOMERVILLE, MASSACHUSETTS 617 628 5033 1 617 628 7033 F www.charlesrosearchitects.com

 \square

OC

PREPARED FOR:

OREGON COLLEGE OF ART AND CRAFT

PORTLAND, OREGON

TERED ARC

O CHARLES B. ROSE

Mum /

SOMERVILLE,

MASSACHUSETTS

CHARLES ROSE ARCHITECTS, INC.

FOR OF OREG COLAB ARCHITECTURE + URBAN DESIGN Associate Architect 421 SW 6th Avenue, Suite 1250 Portland, OR 97204 **KPFF CONSULTING ENGINEERS** Structural Engineer 111 SW 5th Avenue, Suite 2500 Portland, OR 97204 MEP CONSULTING, LLC Mechanical & Plumbing Engineers 828 NW 19th AVENUE Portland, OR 97209 HK ENGINEERING Electrical Engineer 15365 SW Division Street Sherwood, OR 97140 **EVERGREEN ENGINEERING** Code Consultant 7431 NW Evergreen Pkwy, Suite 210 Hillsboro, Oregon 97124 WRITE ANGLE Specification Writer 404 SE 6th Avenue Portland, OR 97214

No. Description Date Partial Schematic 10.19.07 Permit/ CD Set 11.06.08 Construction Set 04.02.09

Schematic Design 11.07.07 Design Development 12.04.07 Permit Set 05.19.08 Construction Documents06.06.08Permit Re-Submission08.22.08

DRAWING, PAINTING AND PHOTOGRAPHY STUDIO OREGON COLLEGE OF ART & CRAFT

PORTLAND, OREGON

WALL

SECTIONS

Project Number Date Drawn By

Checked By

Scale

06.06.2008


02518


ΡM


ΗW


AS NOTED


A6.1

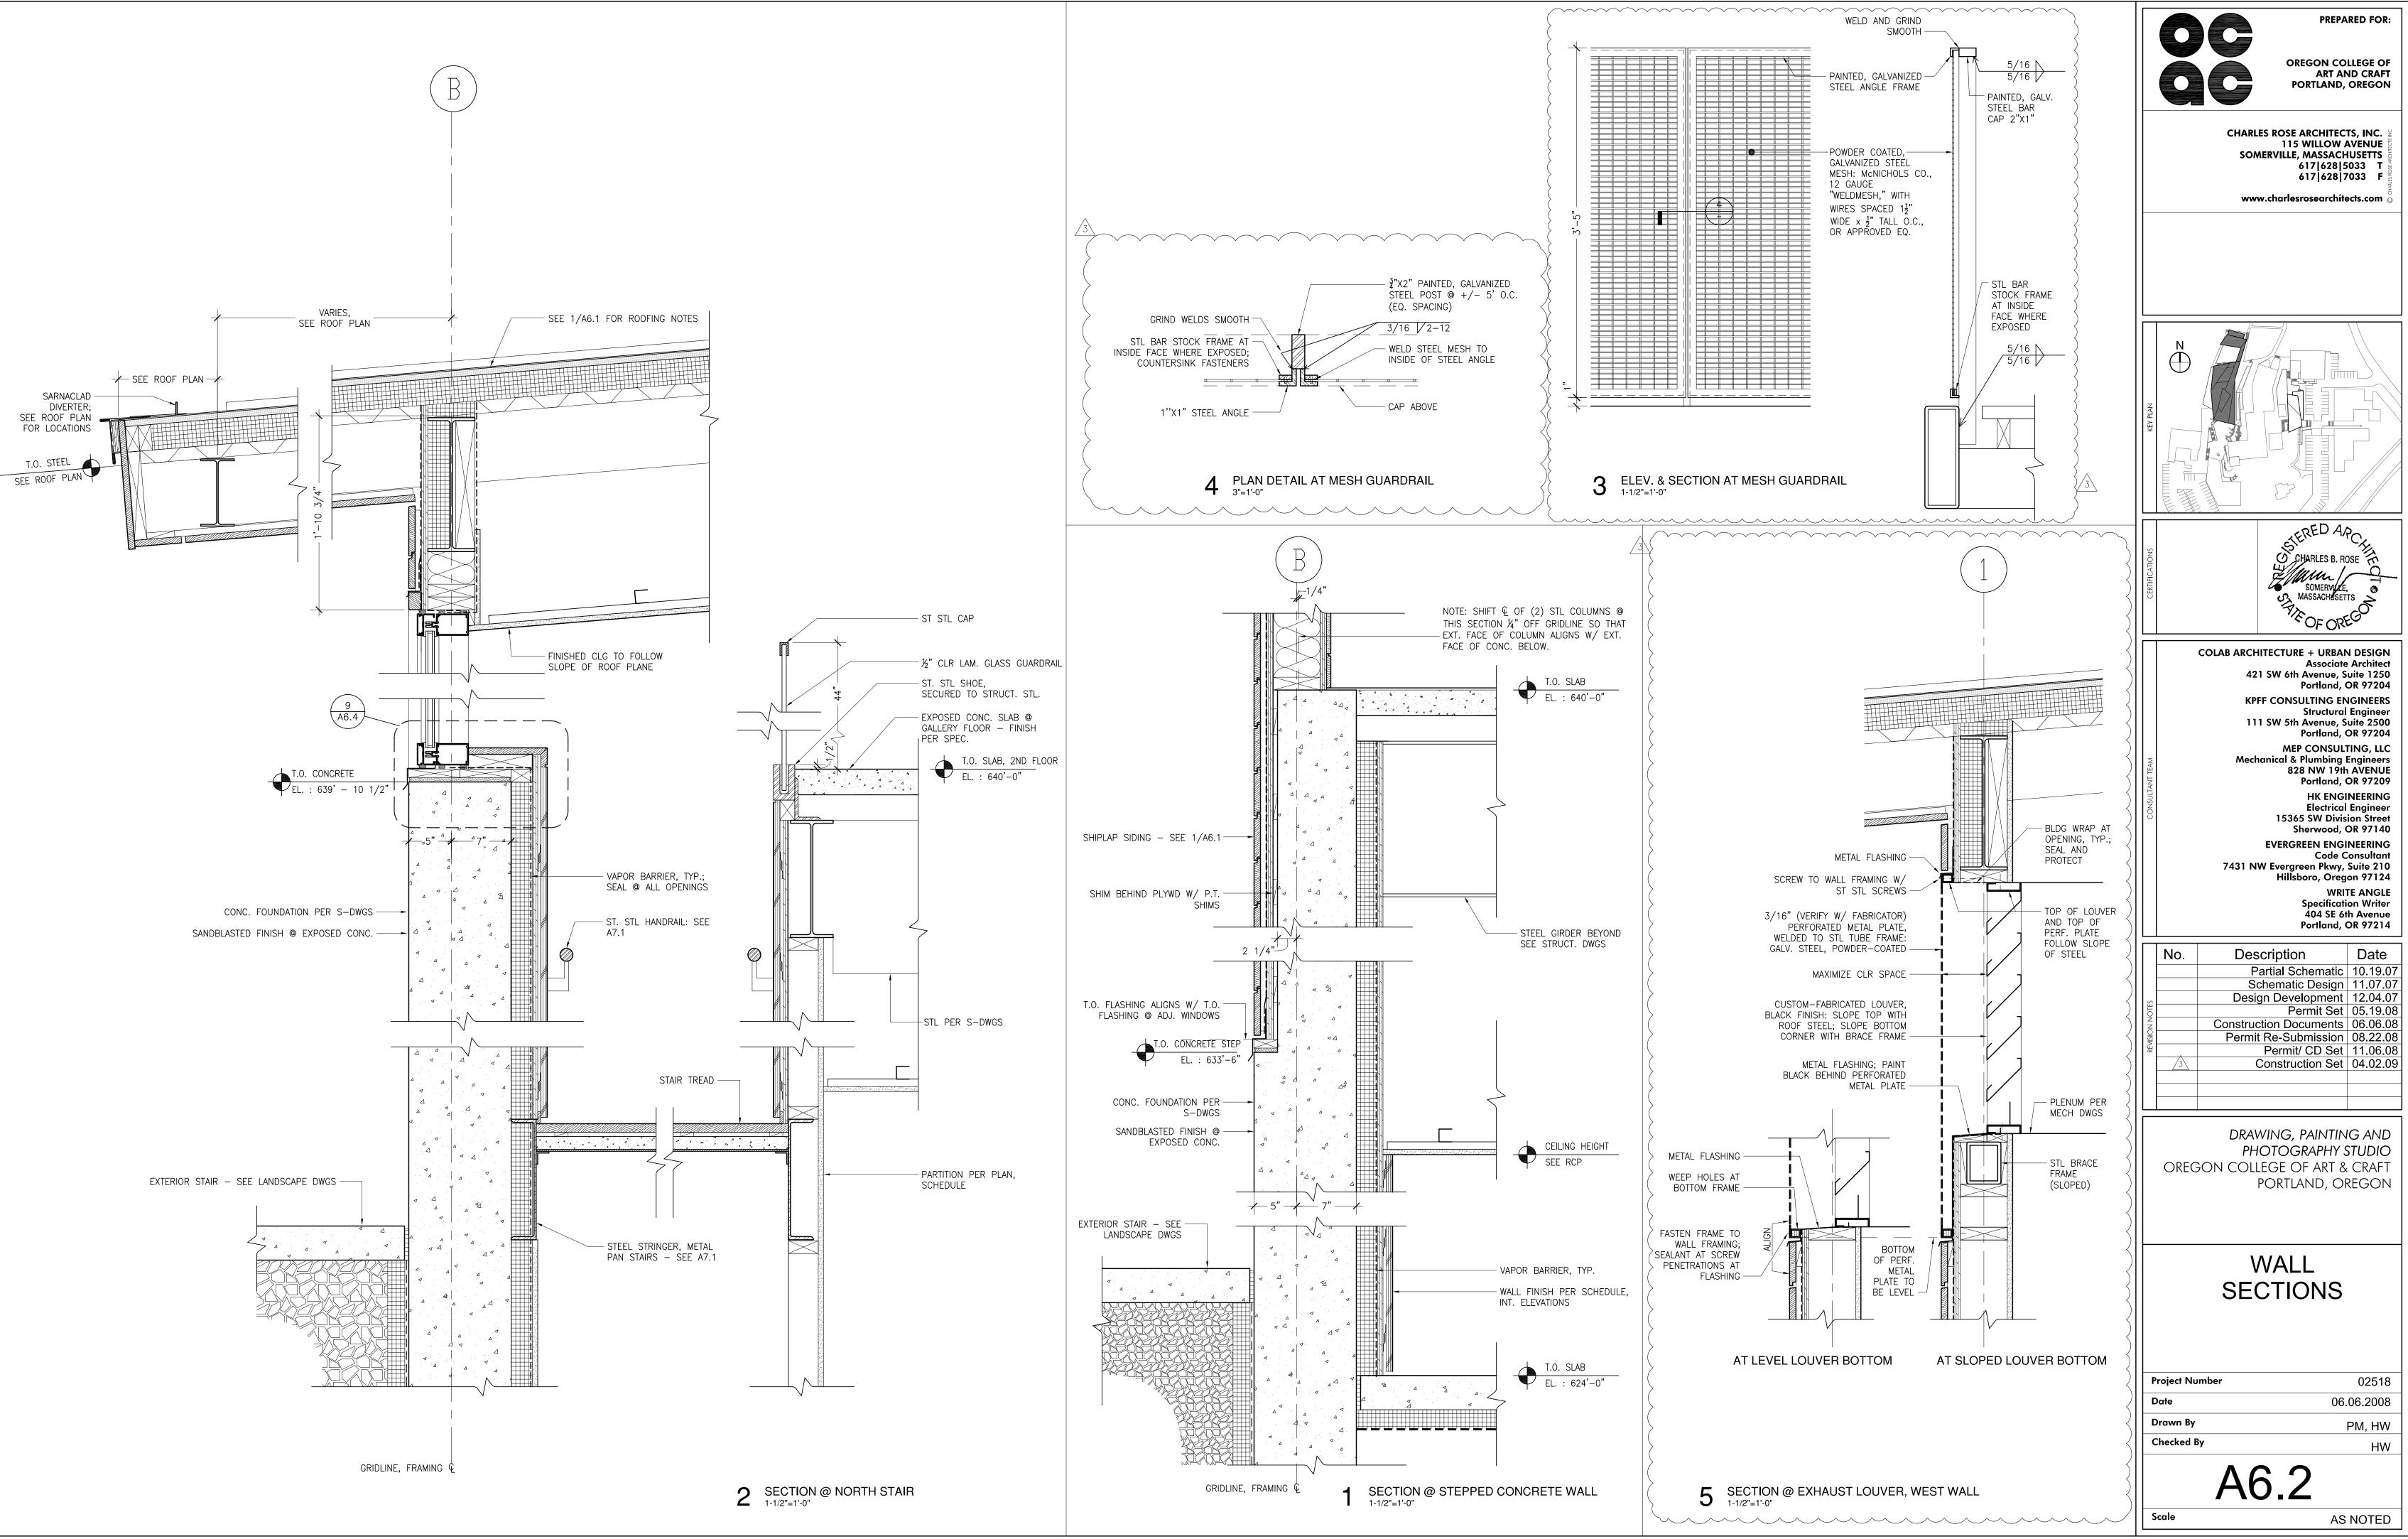


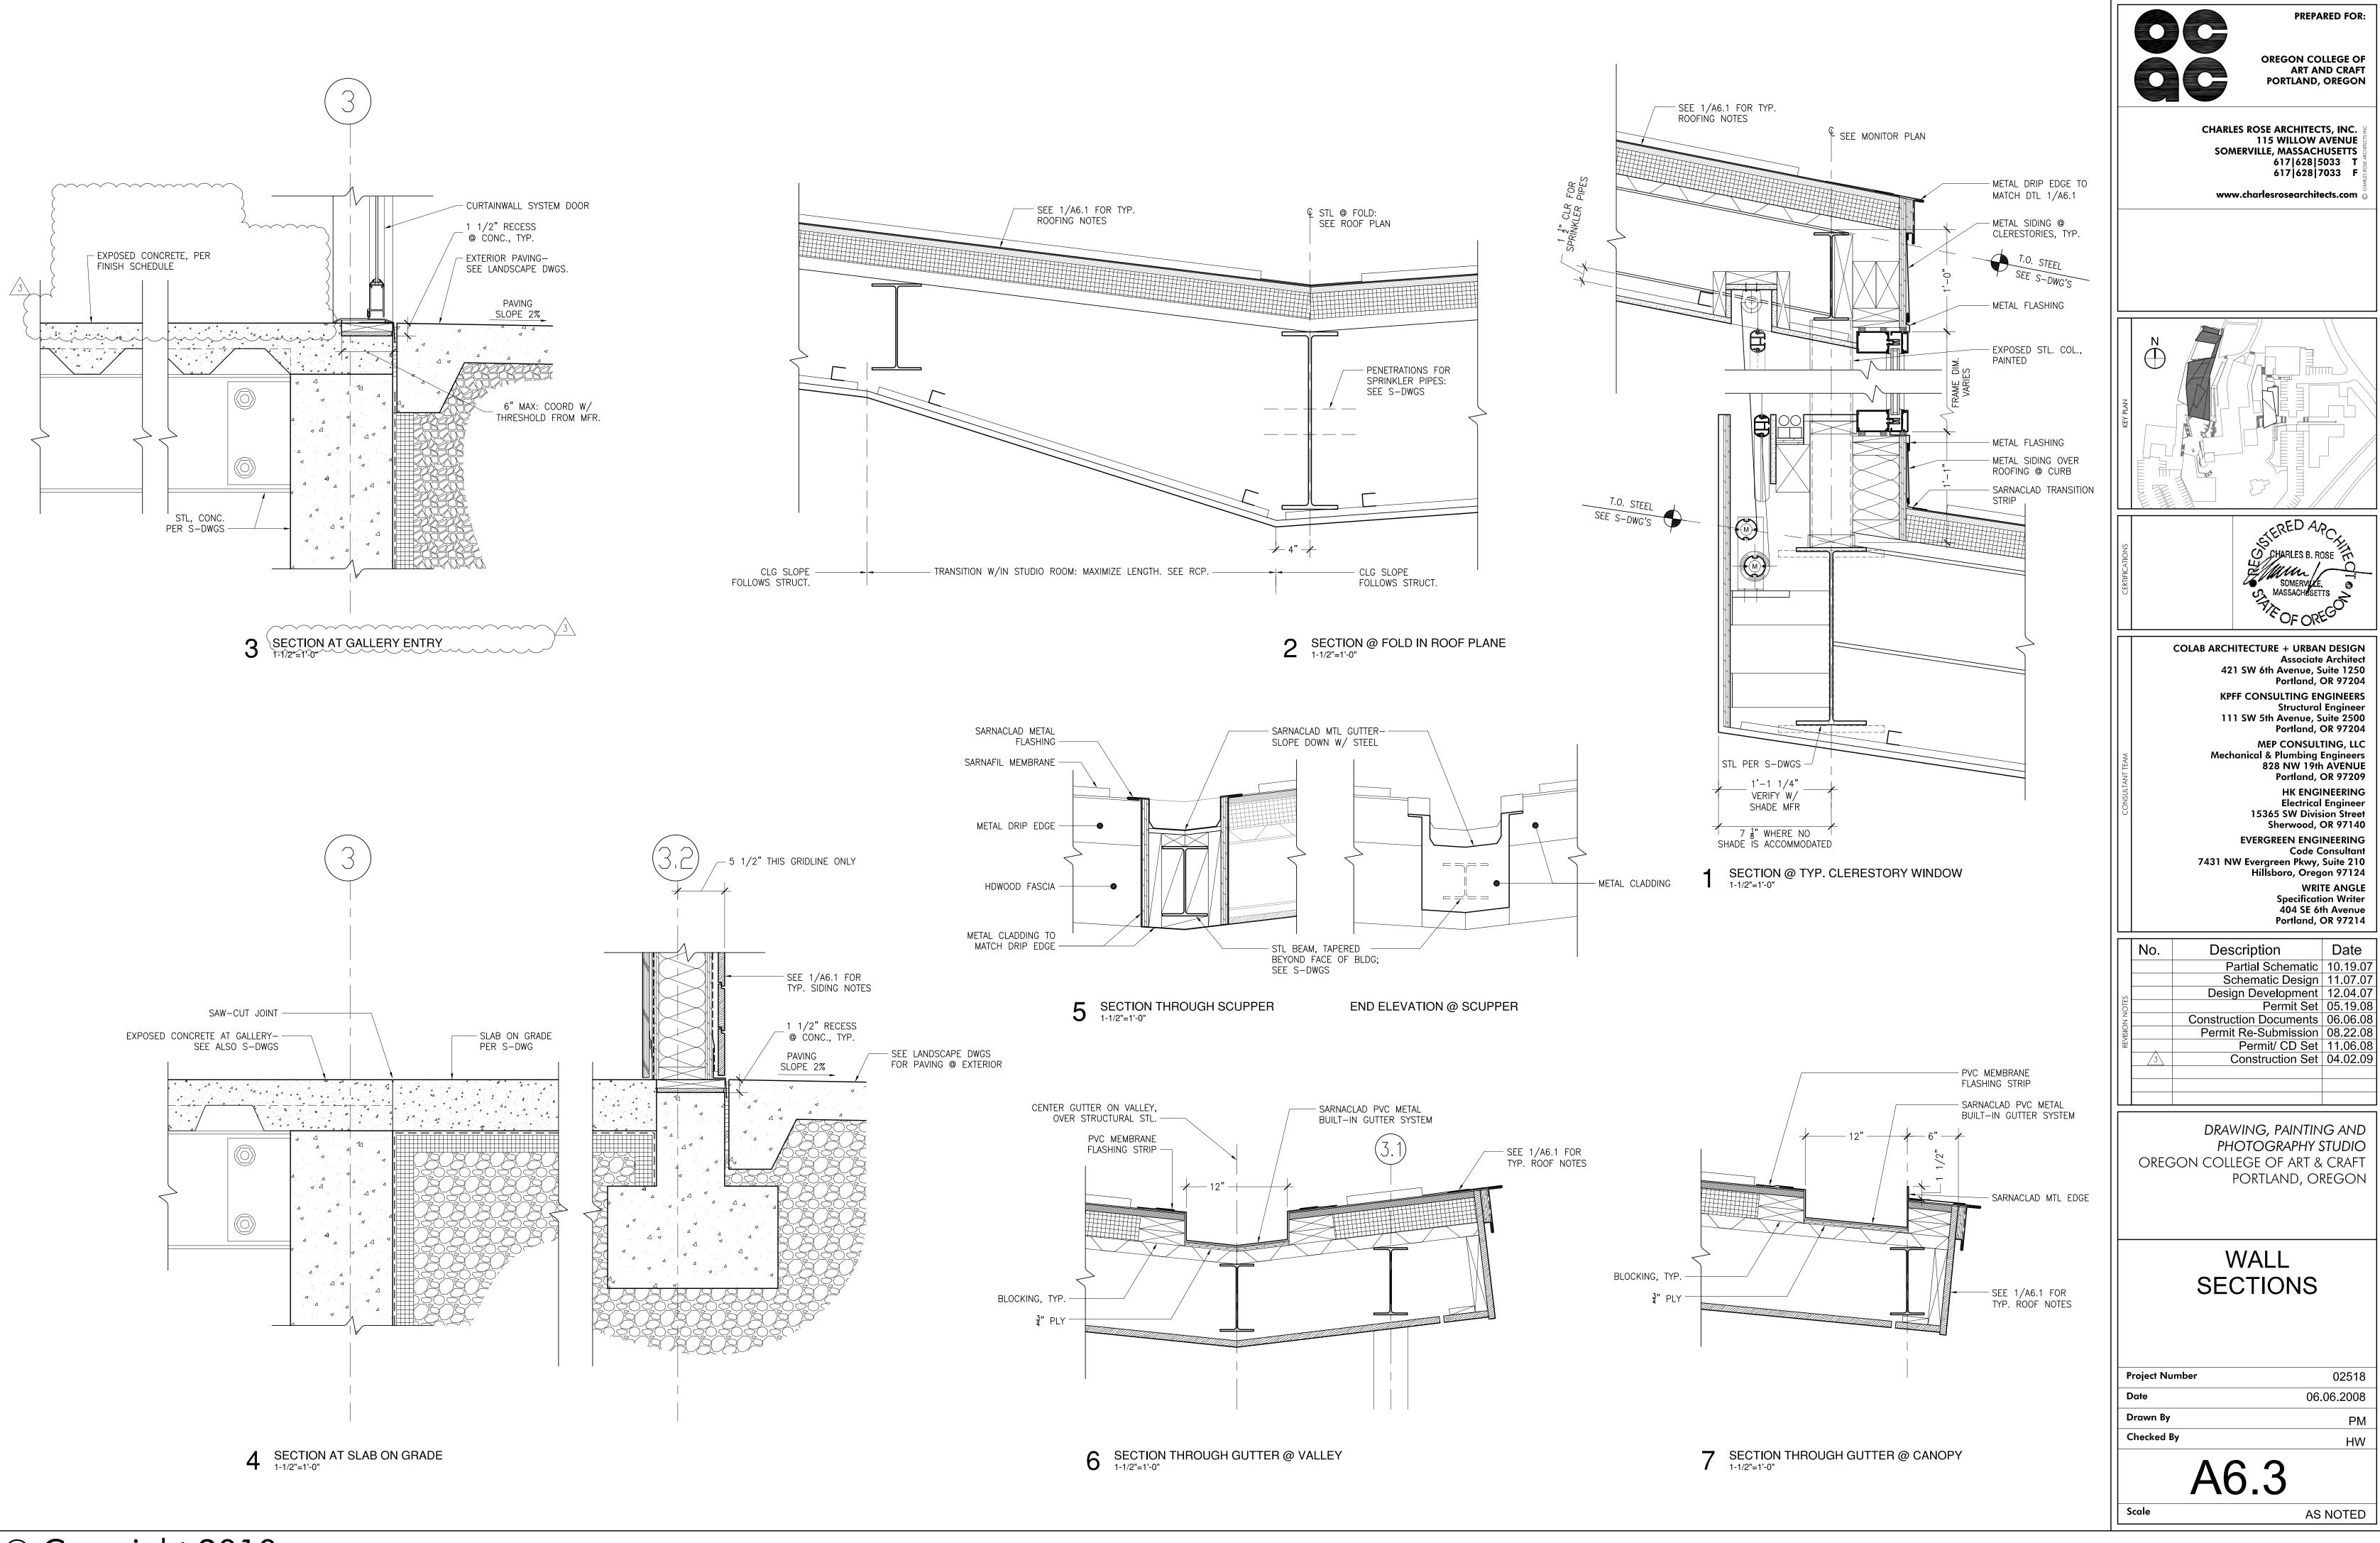


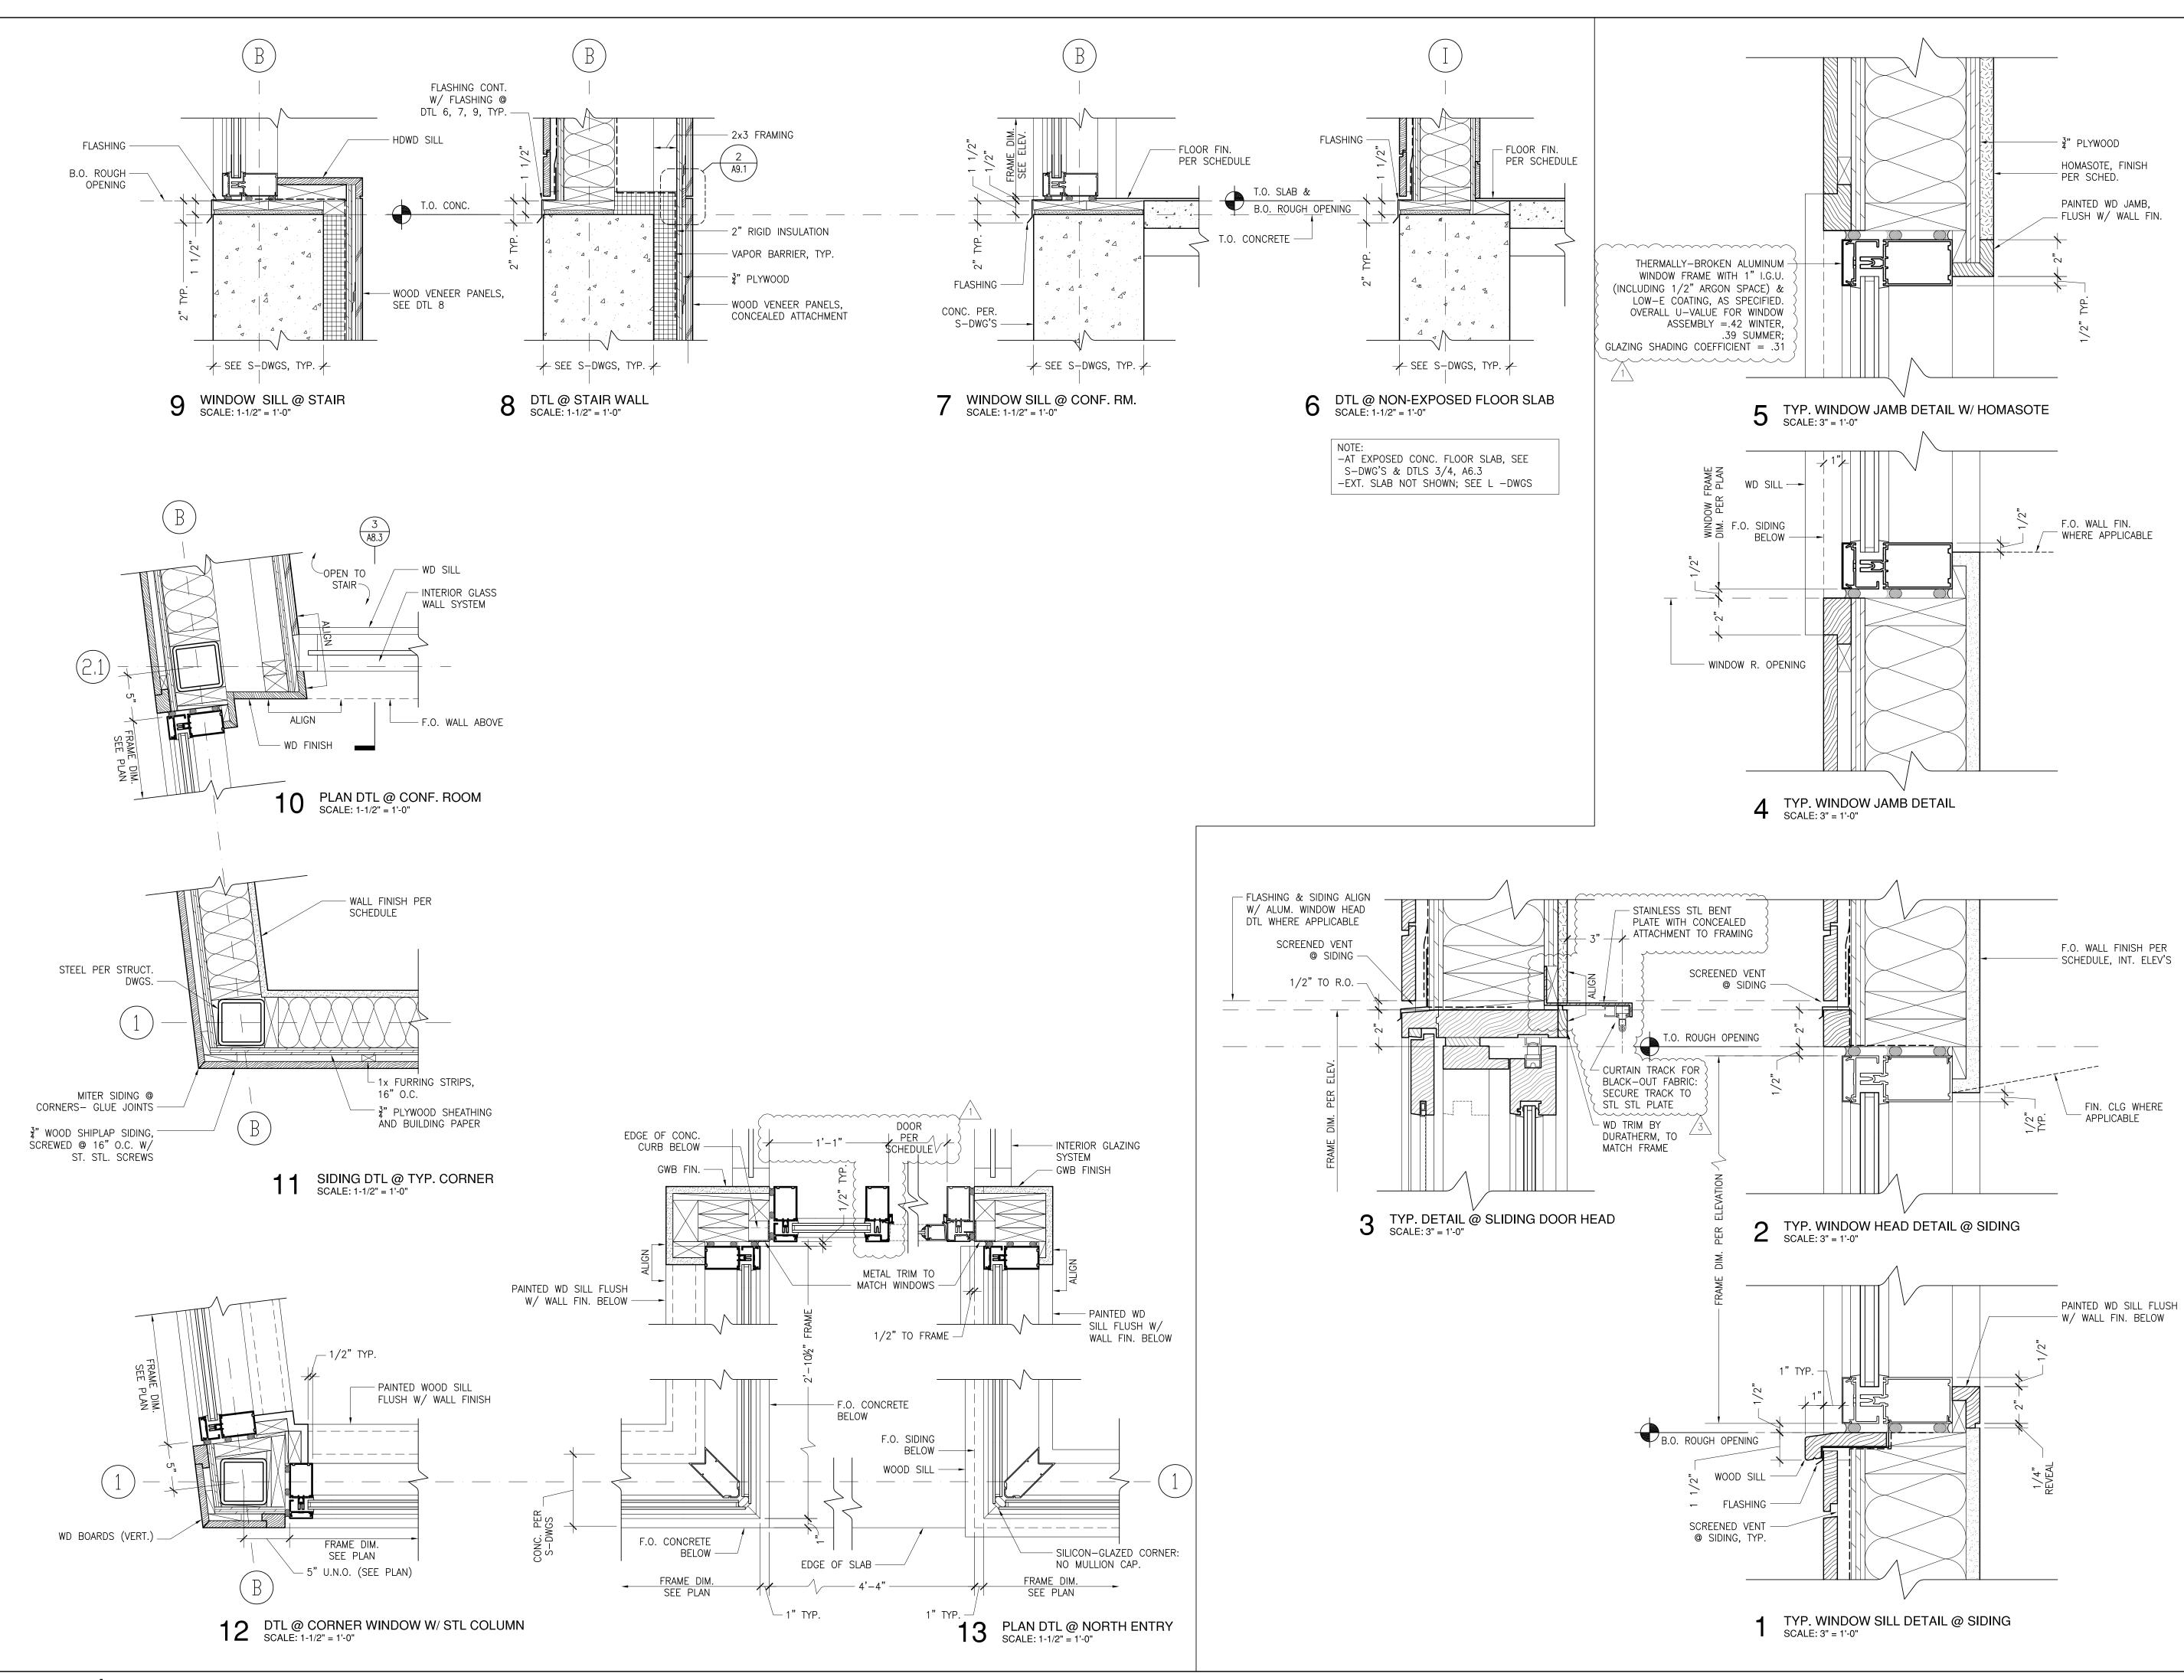


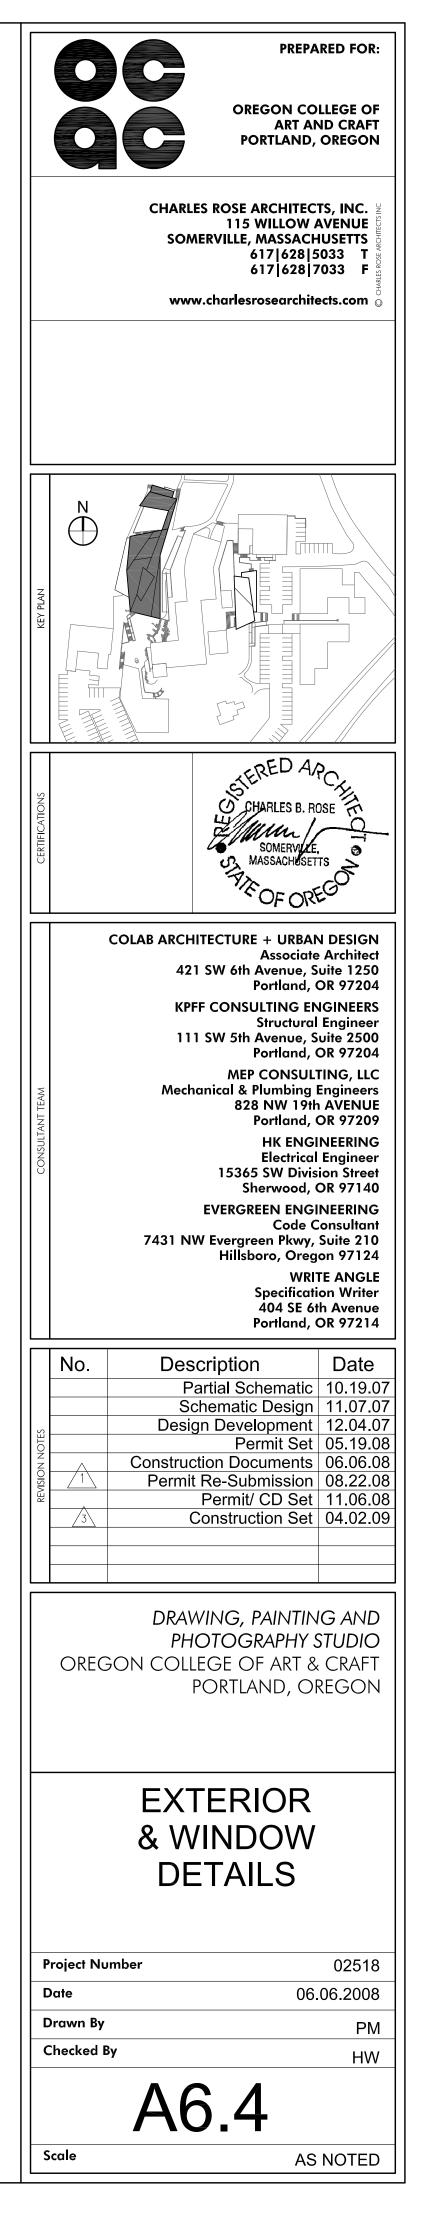

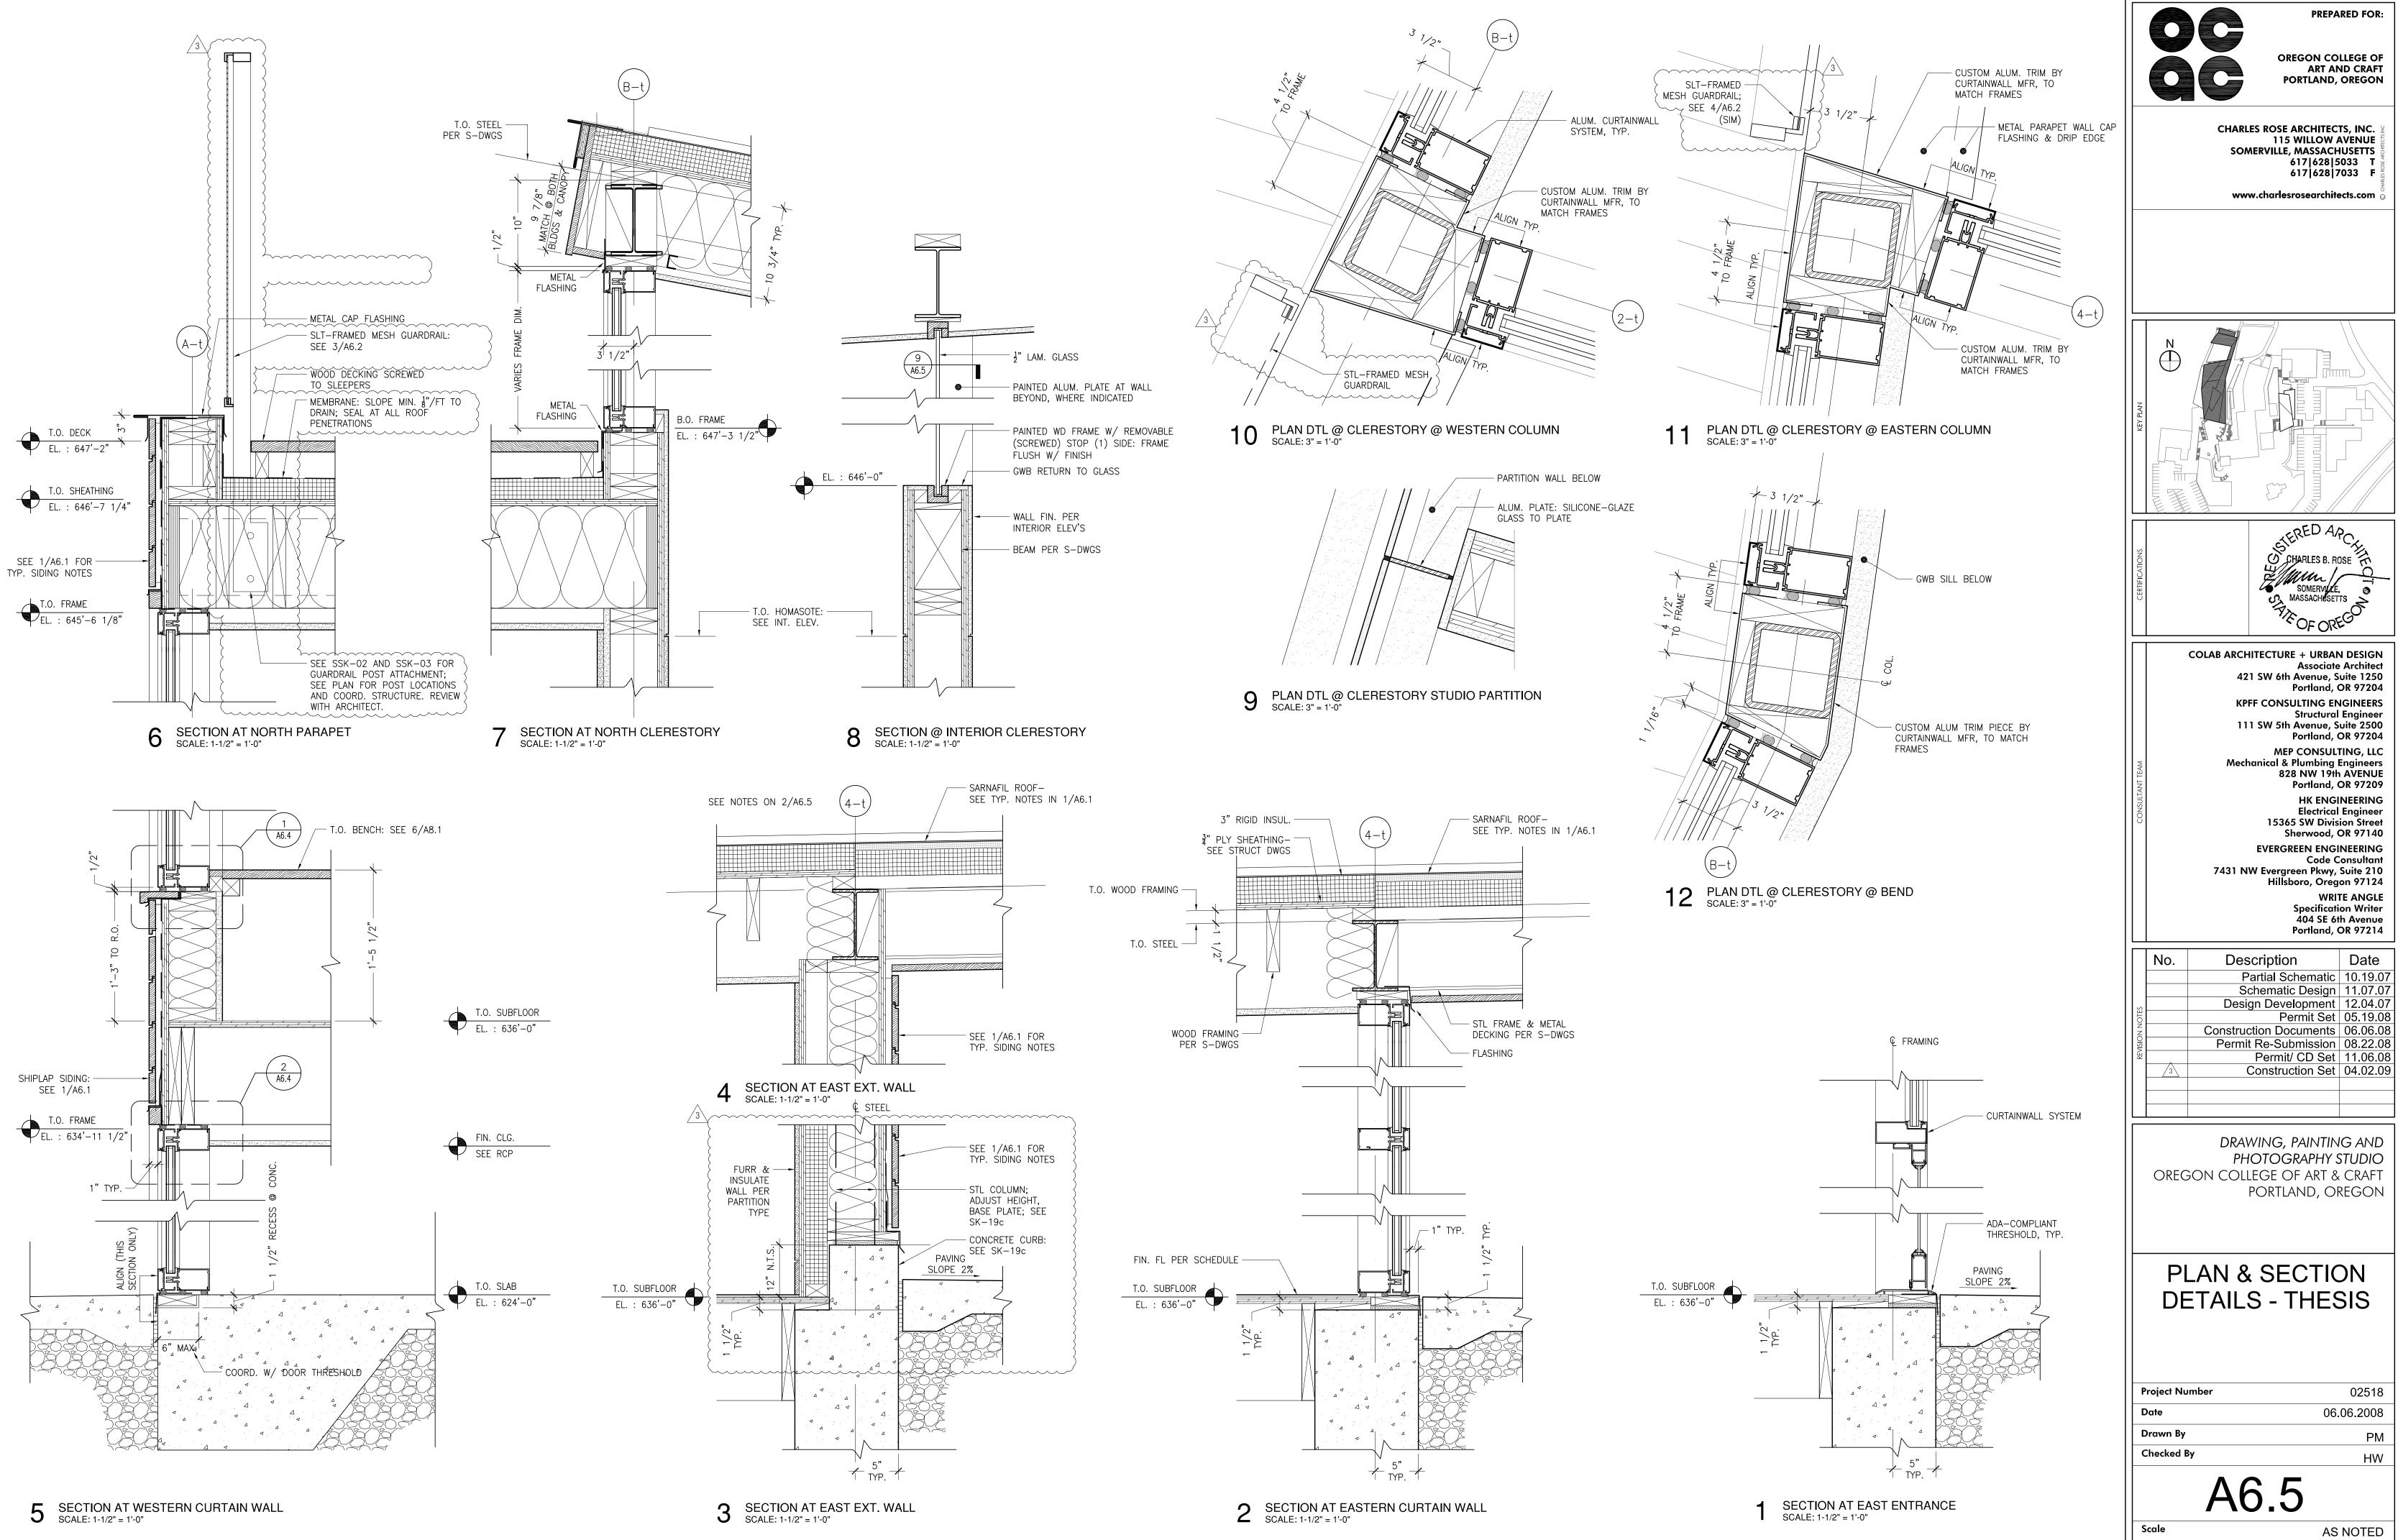


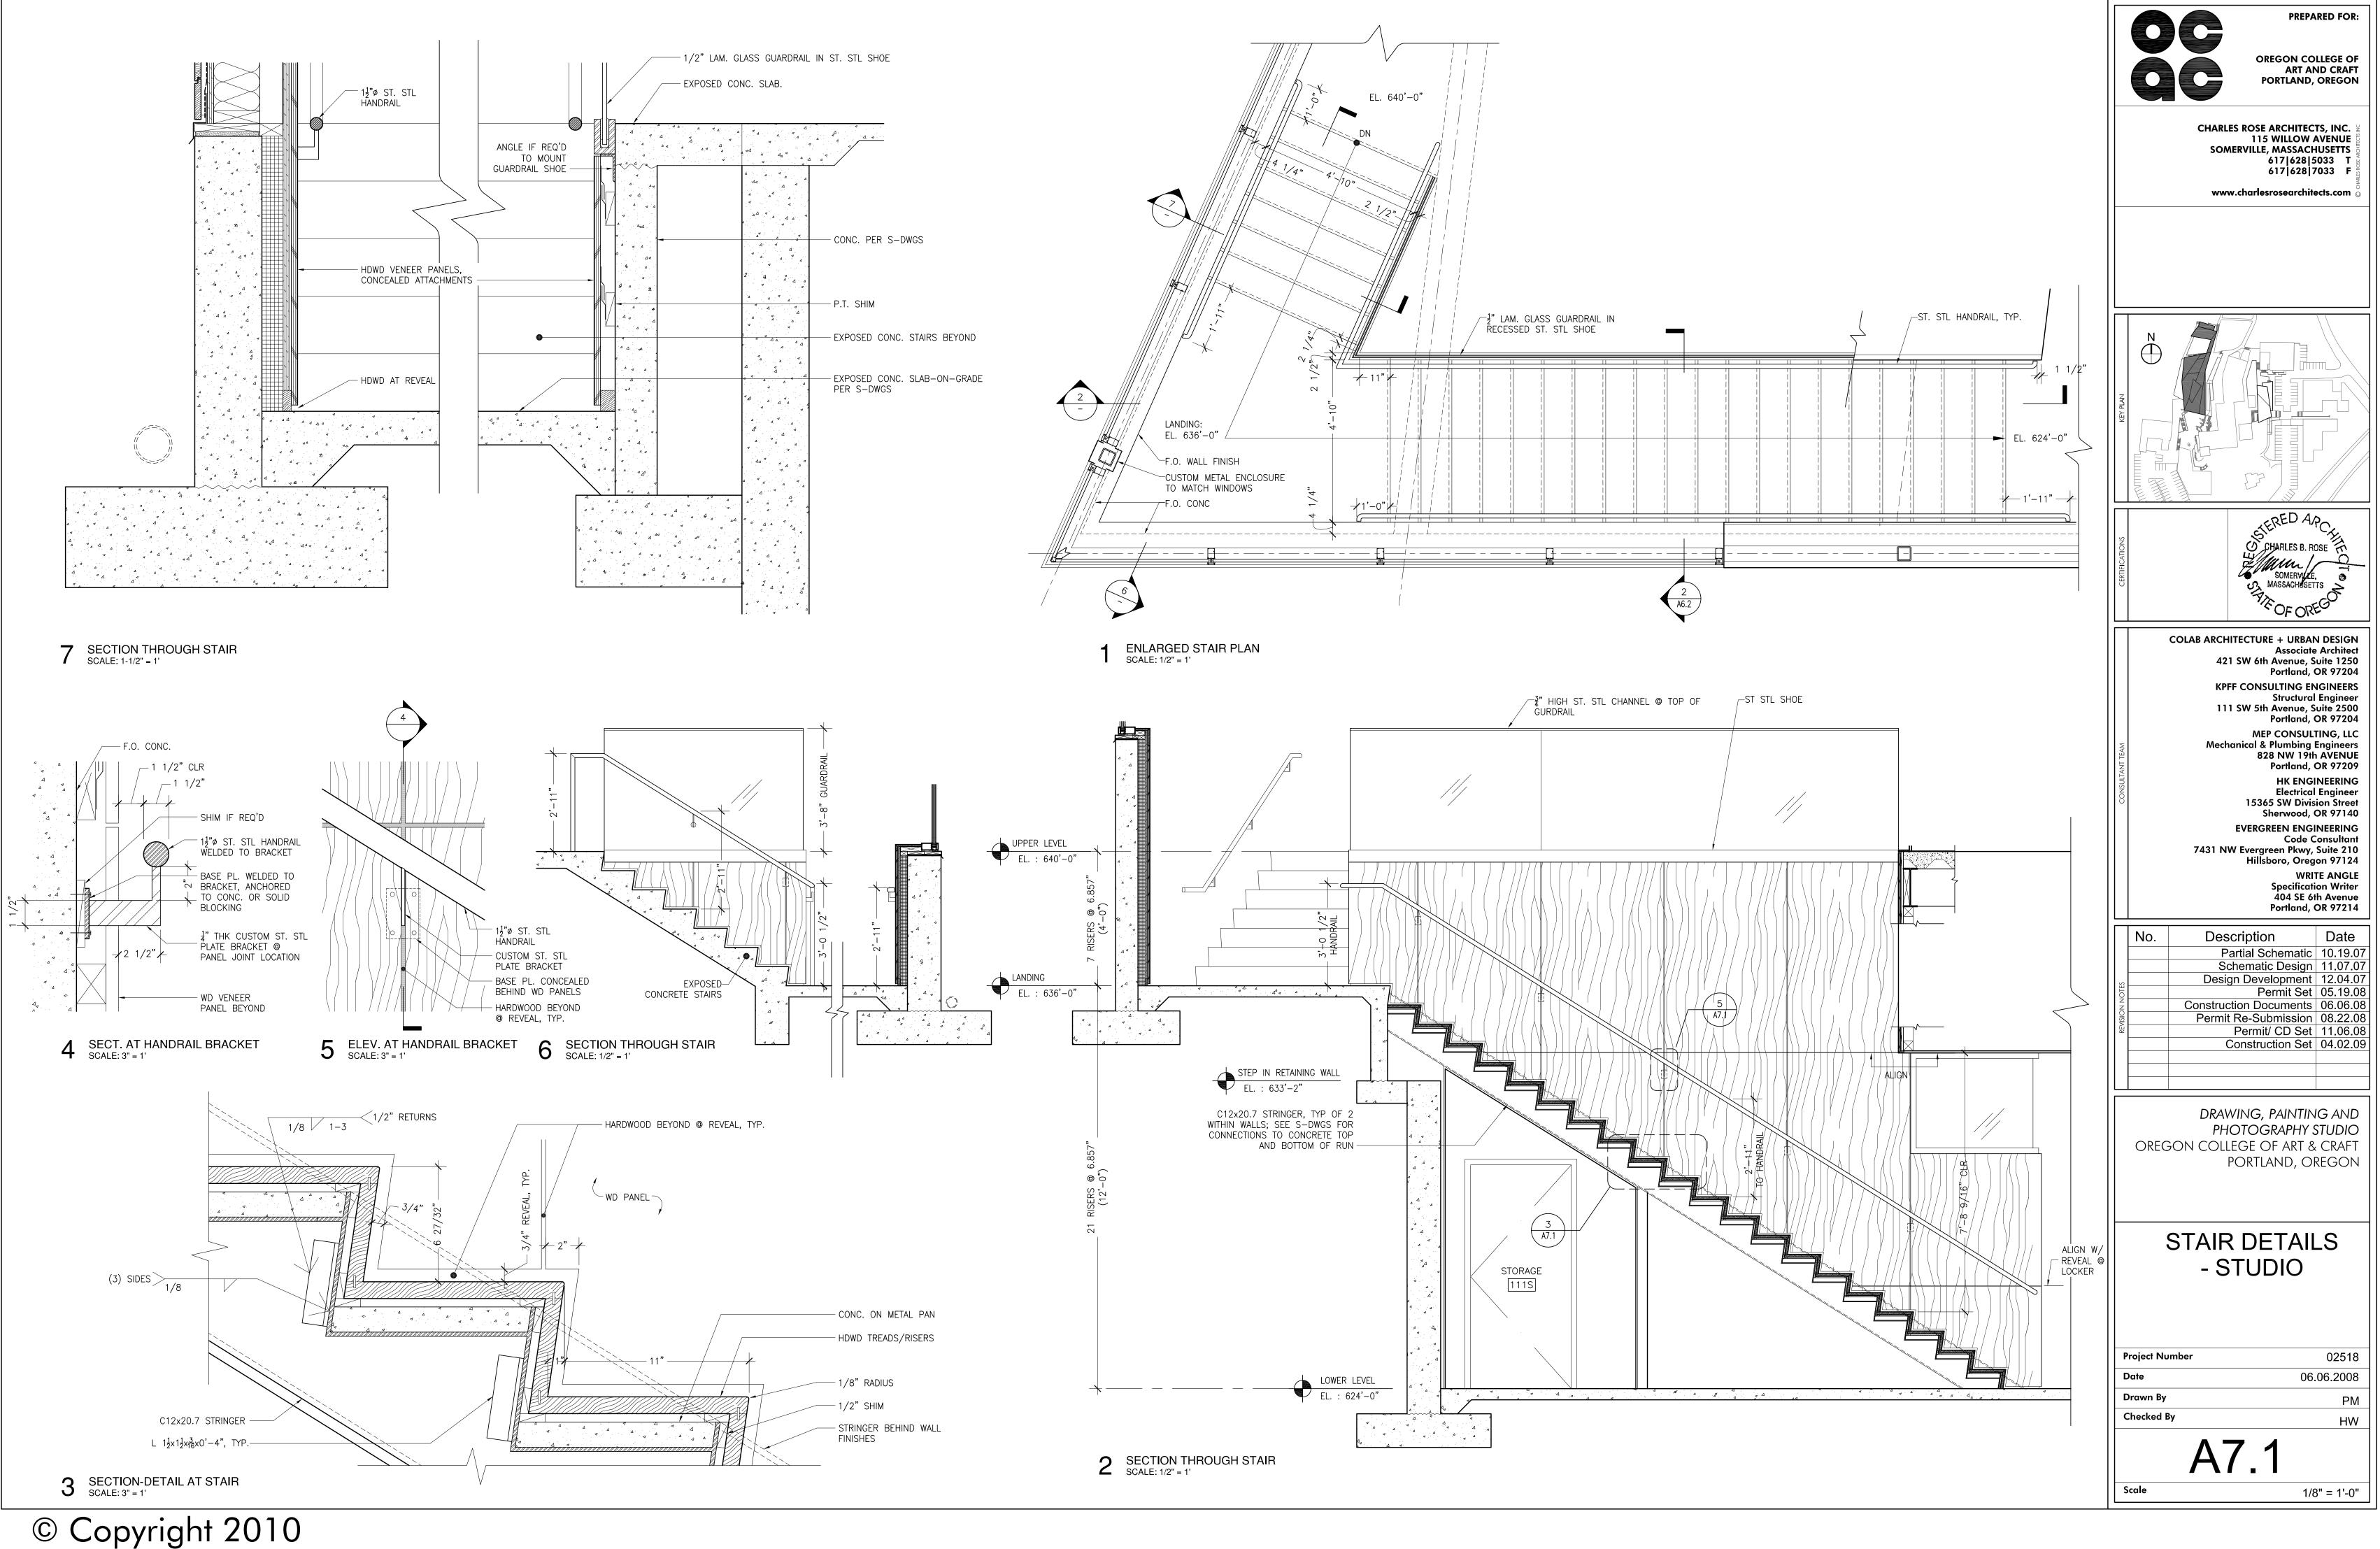


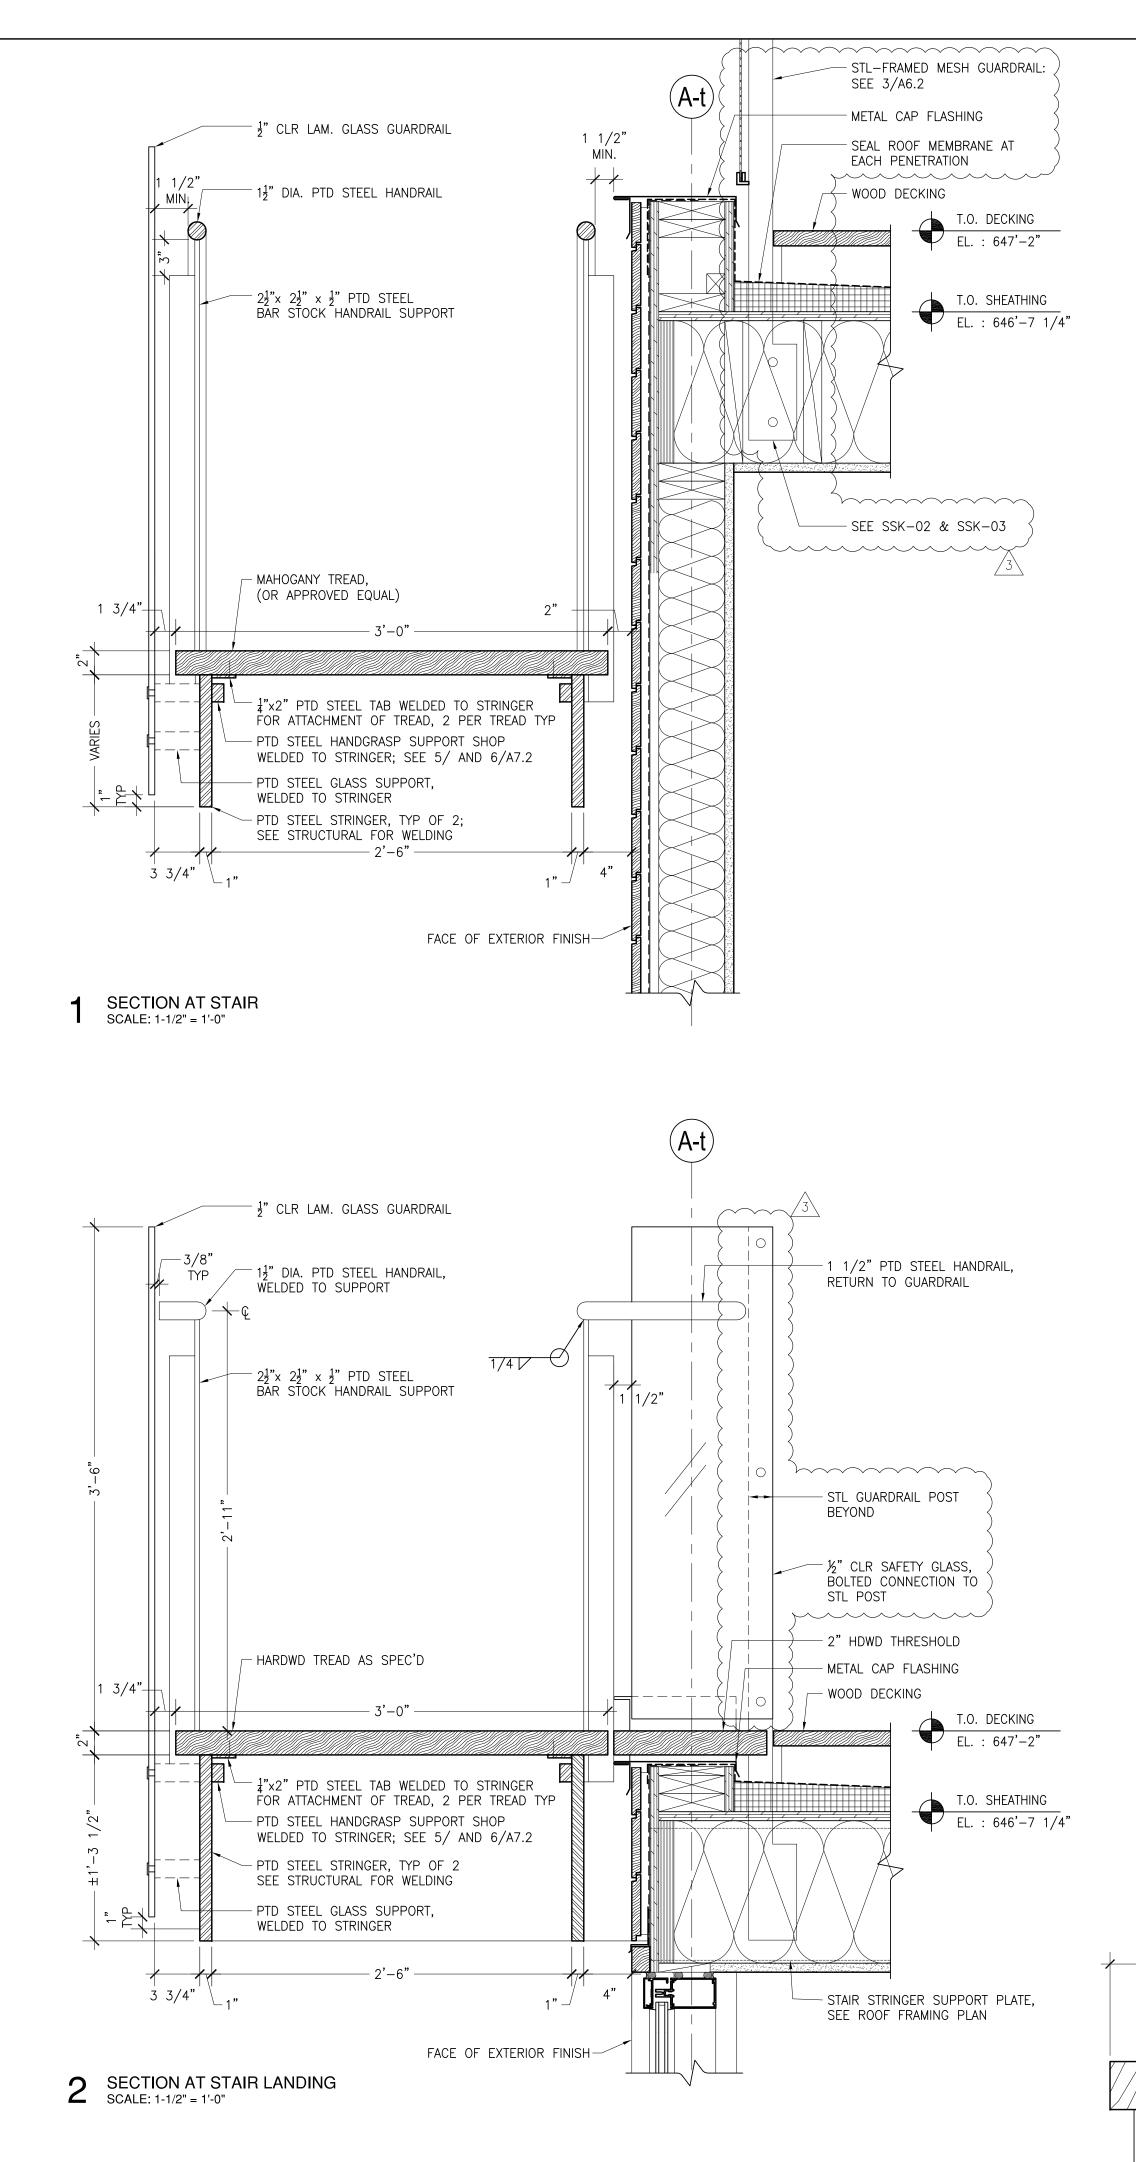


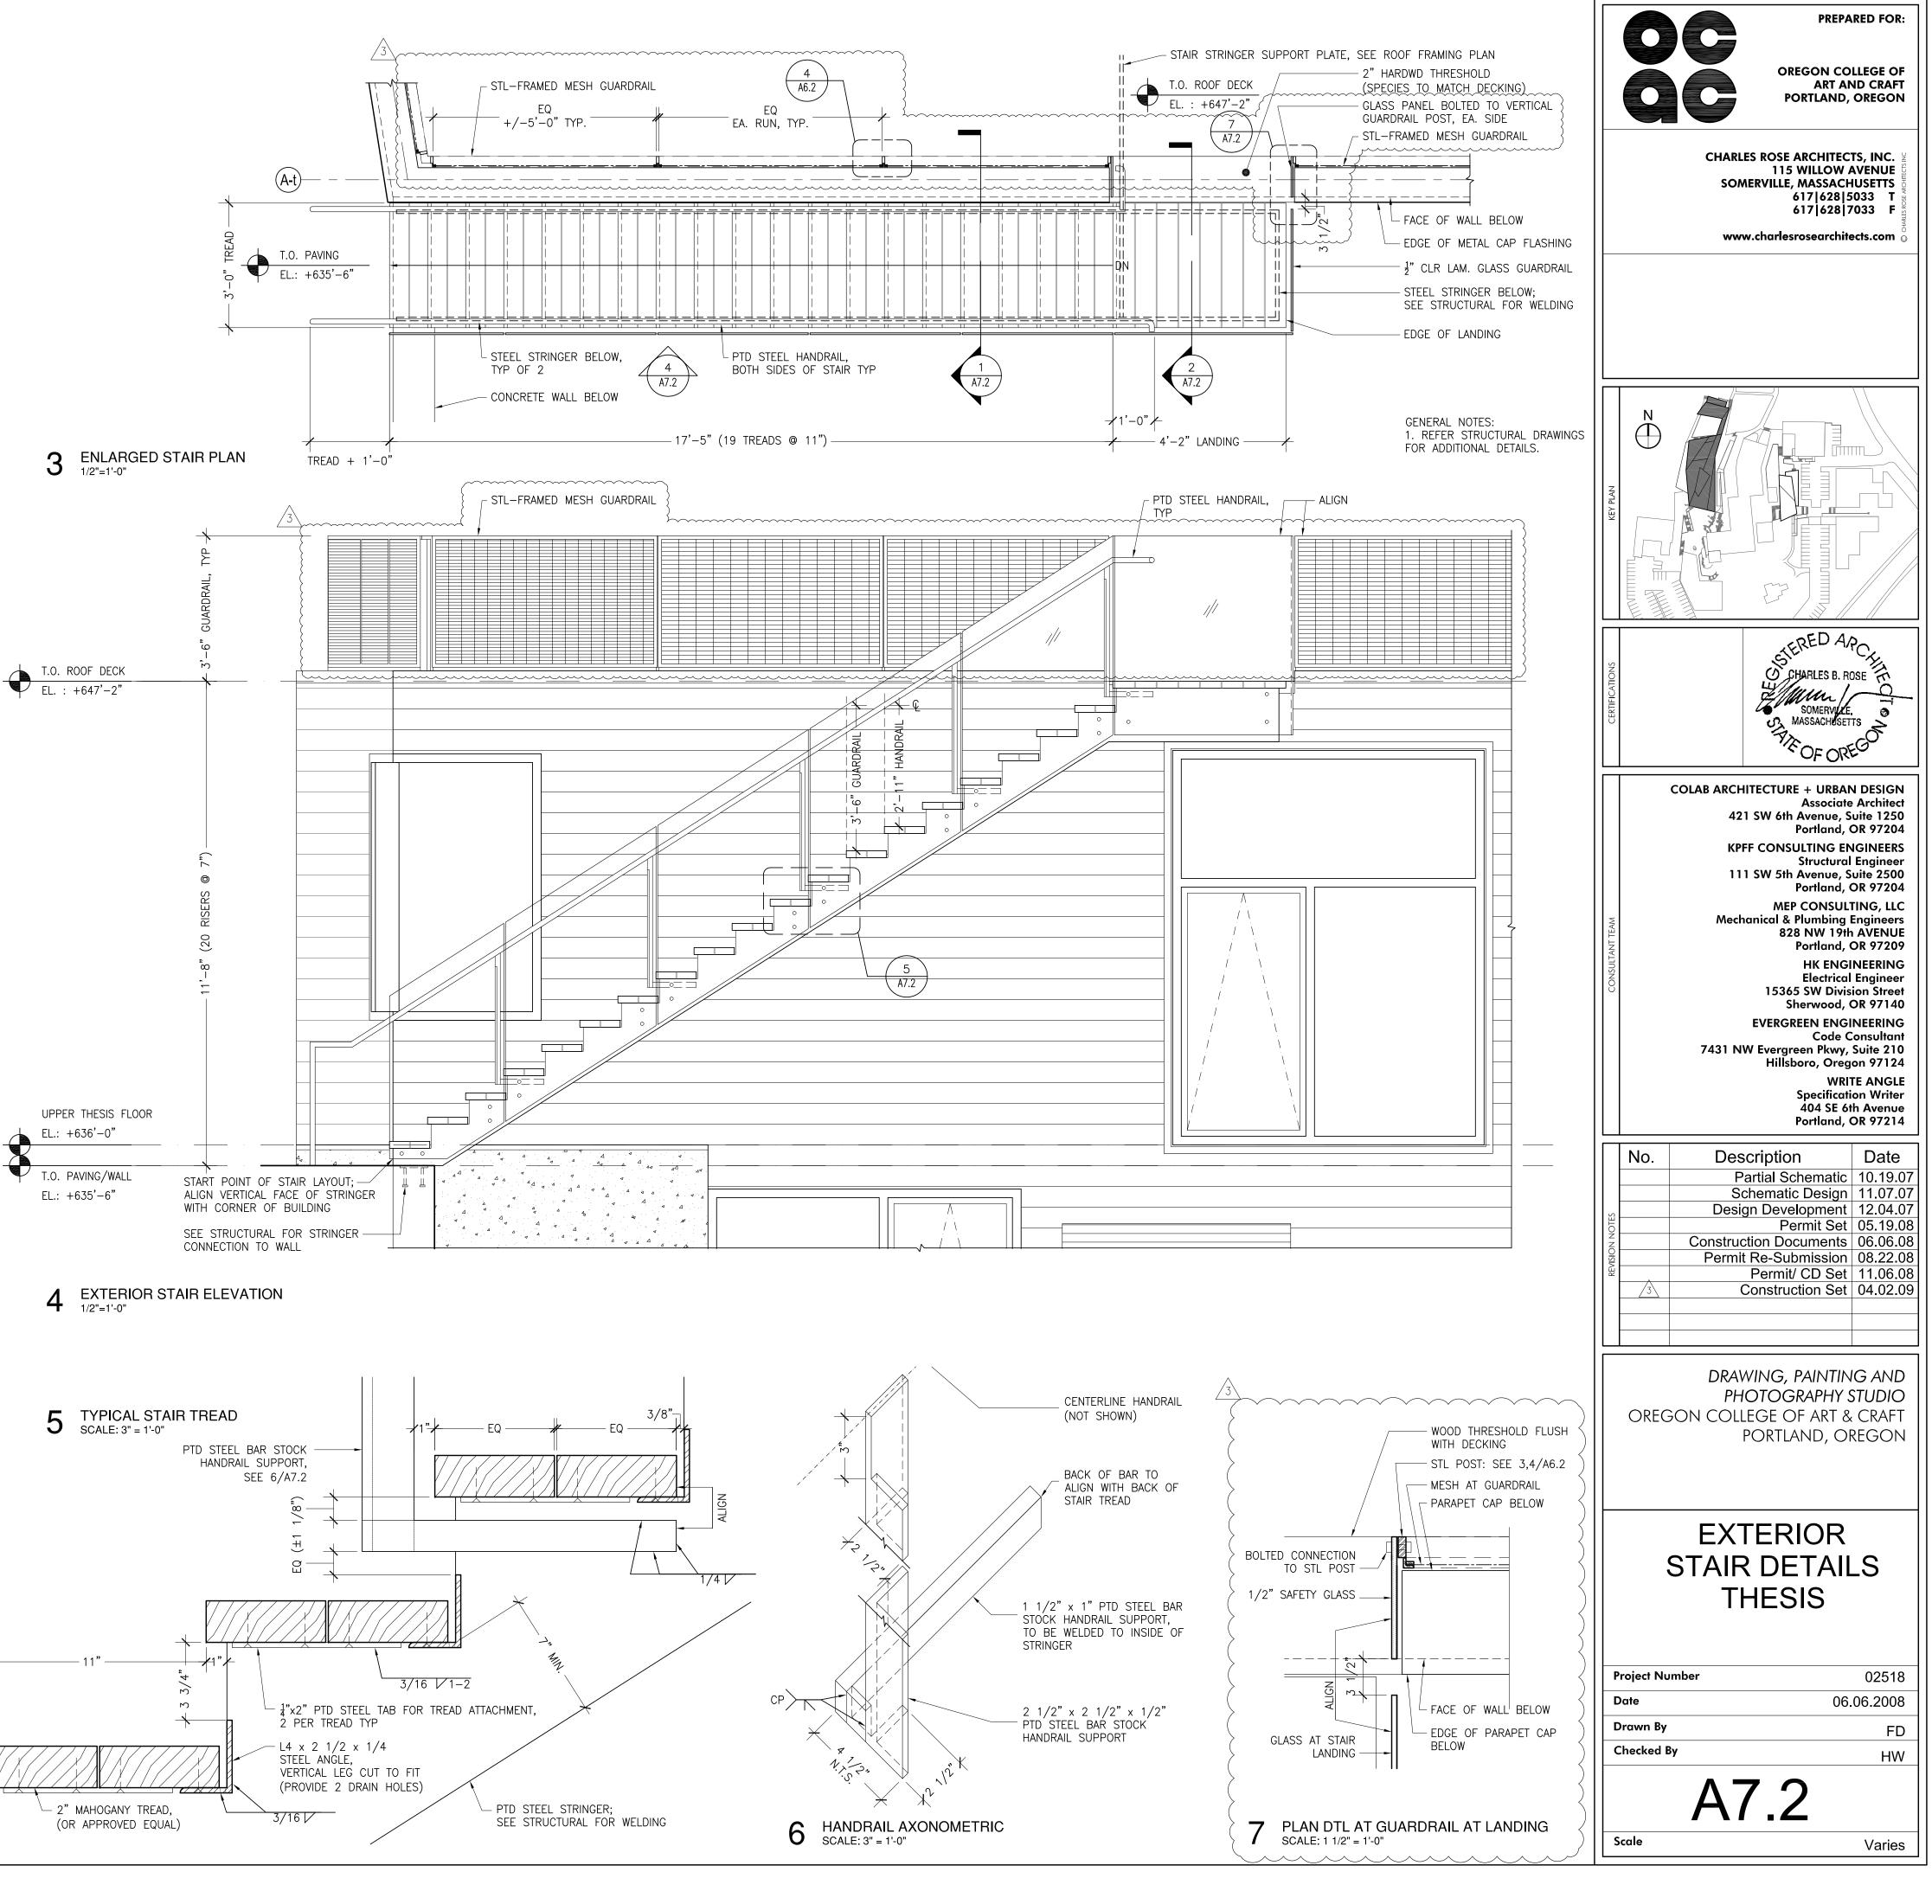




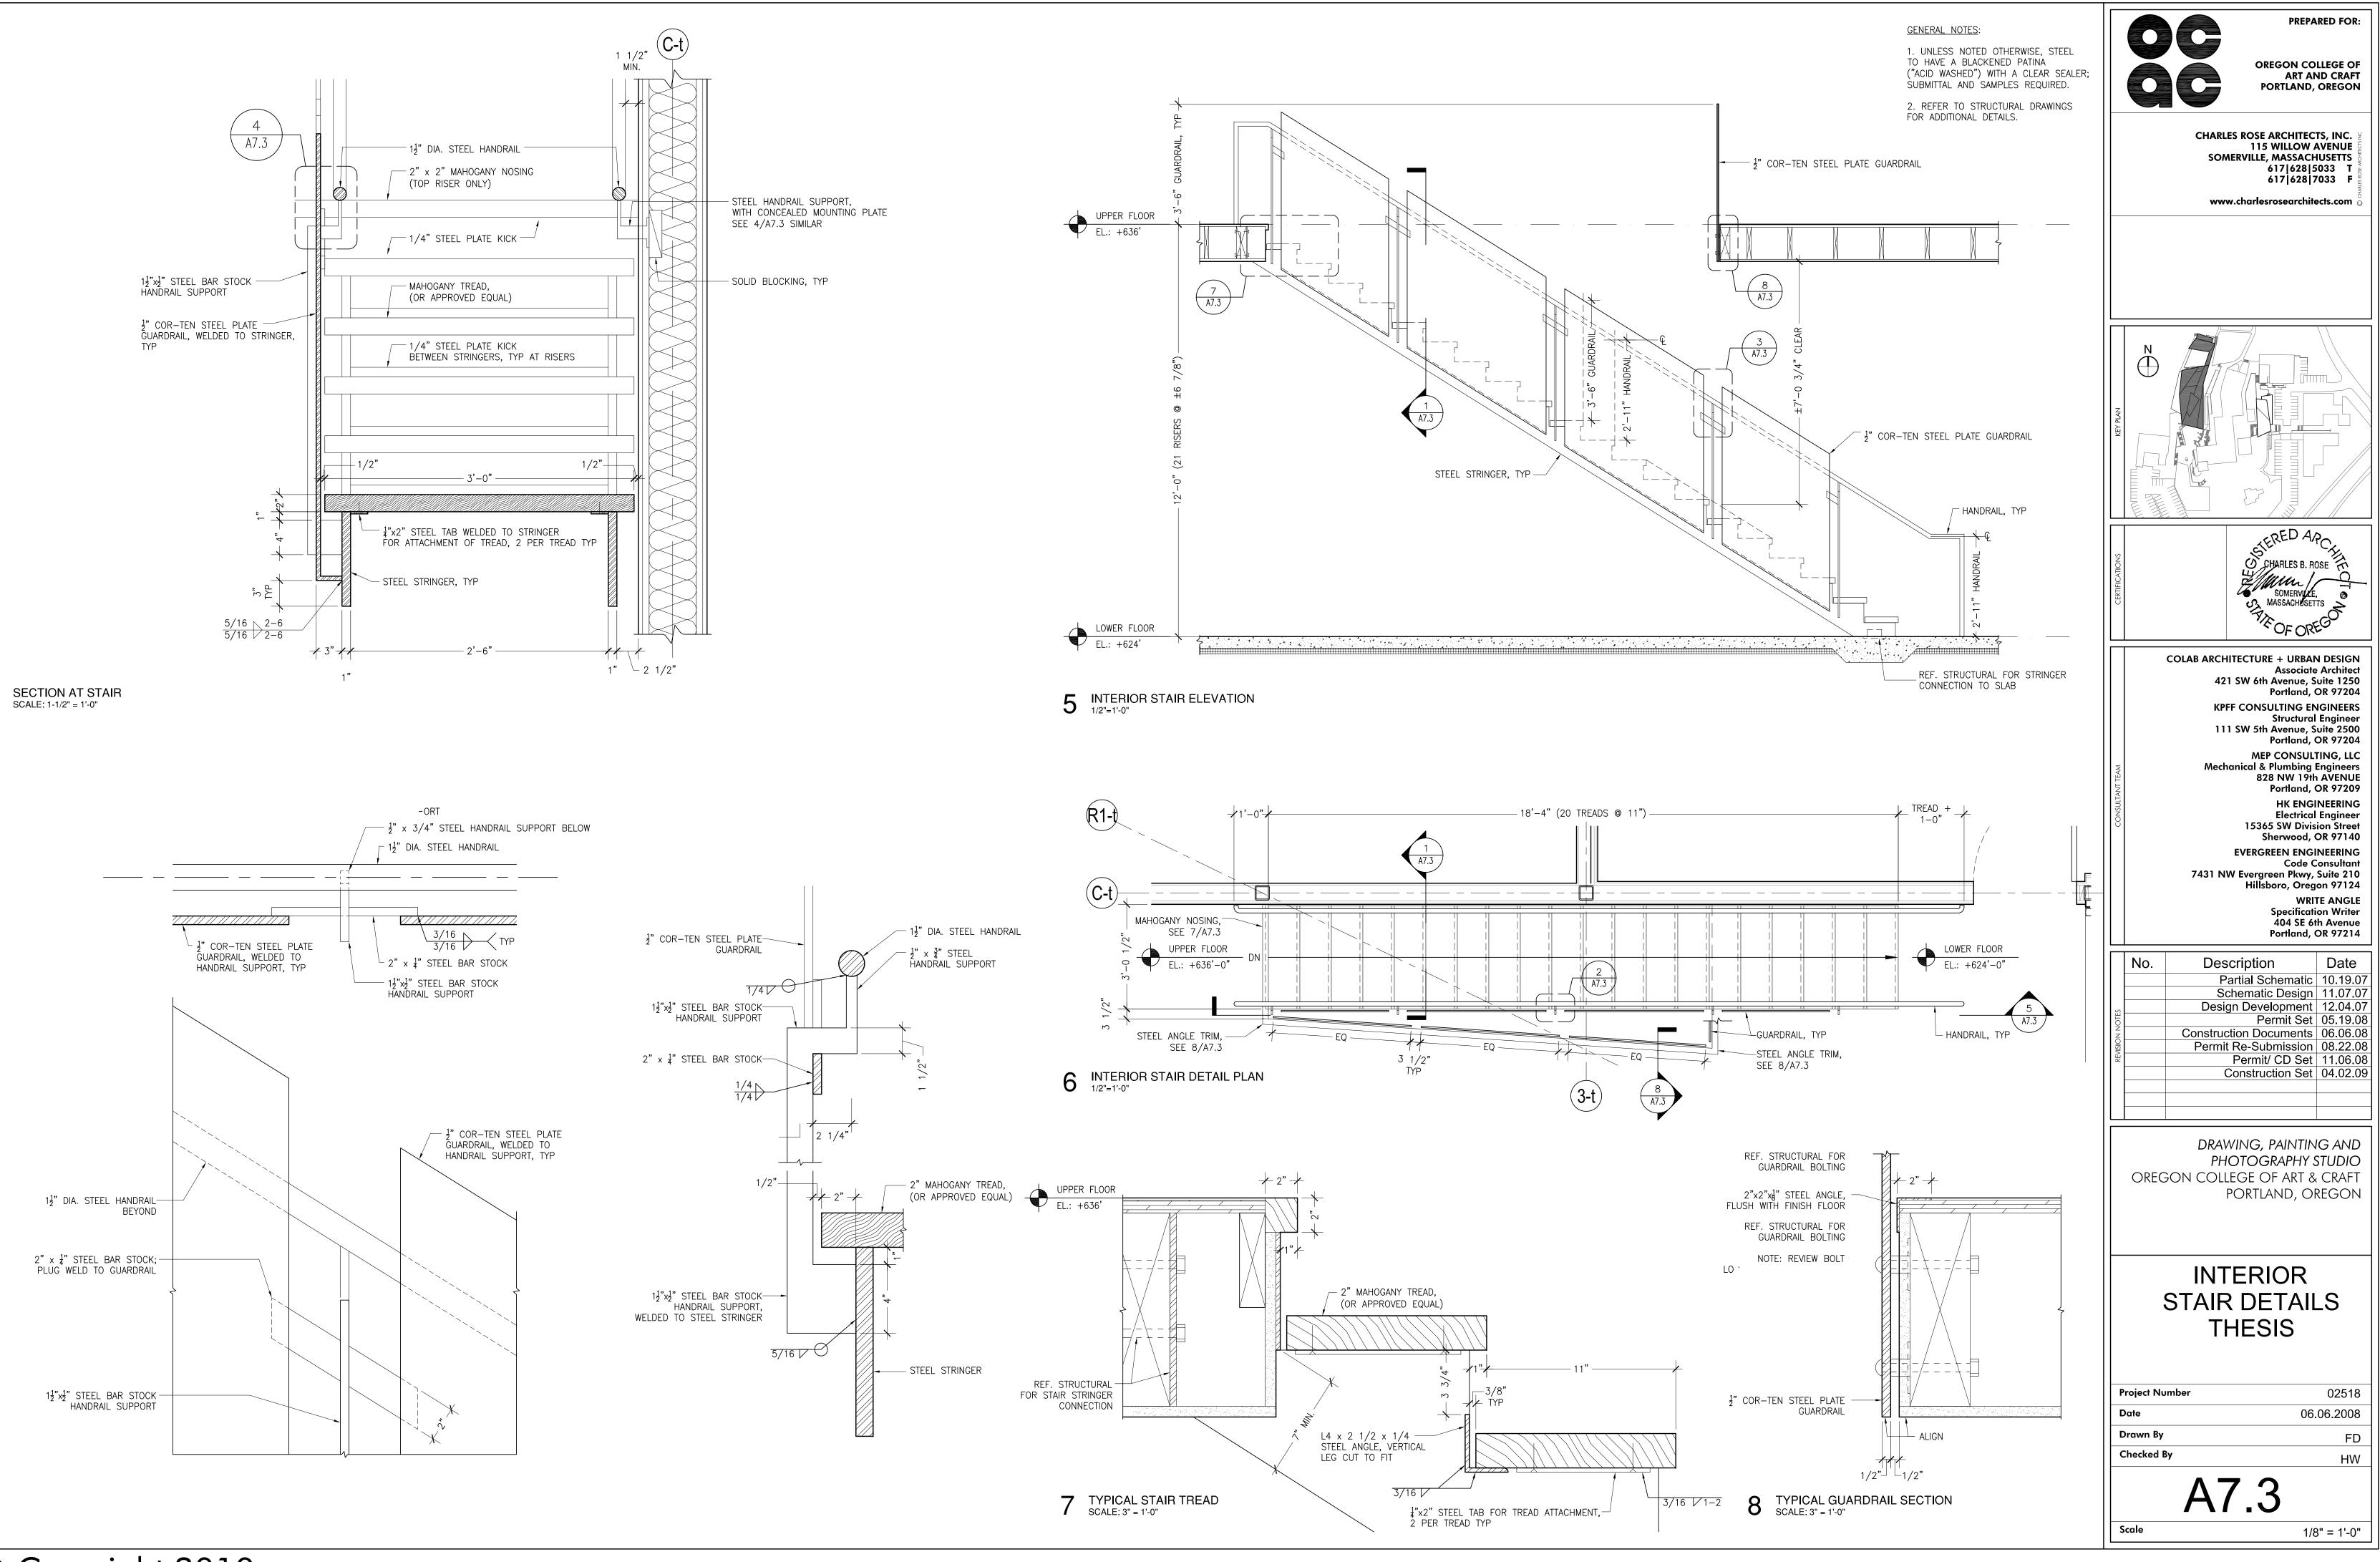


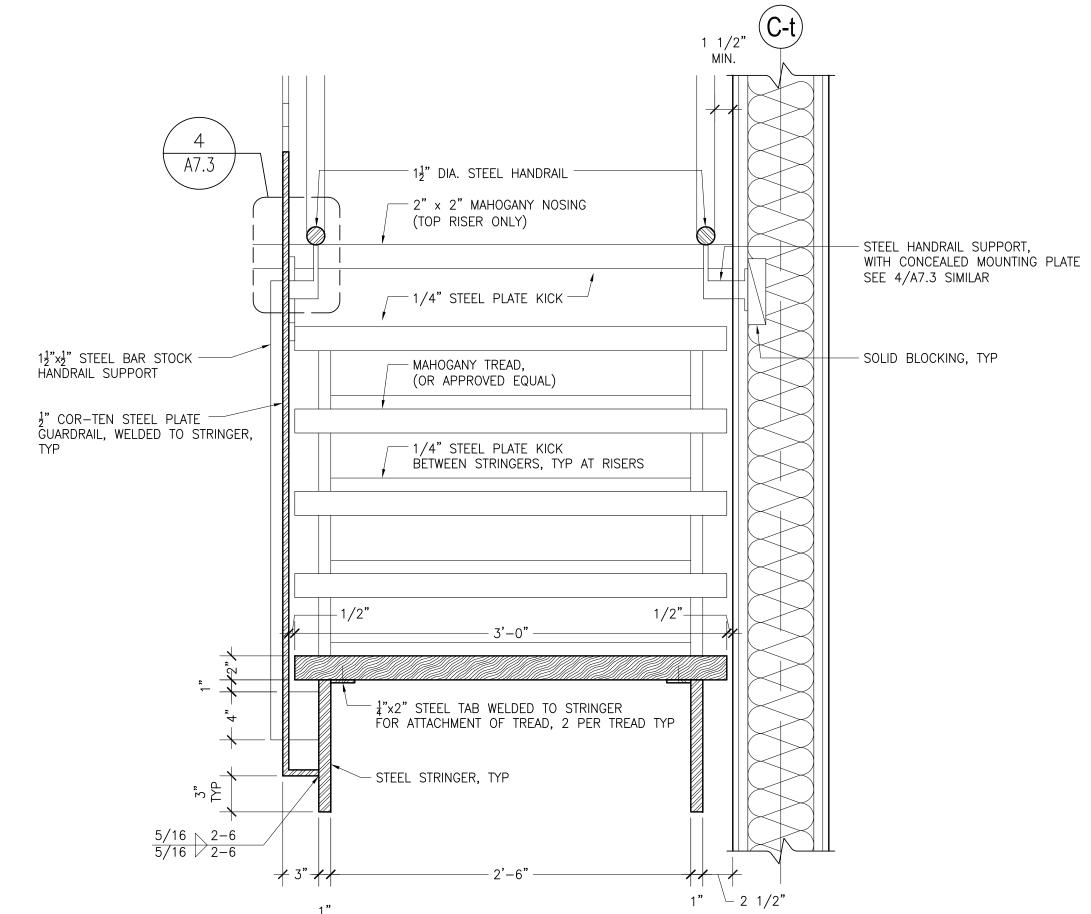

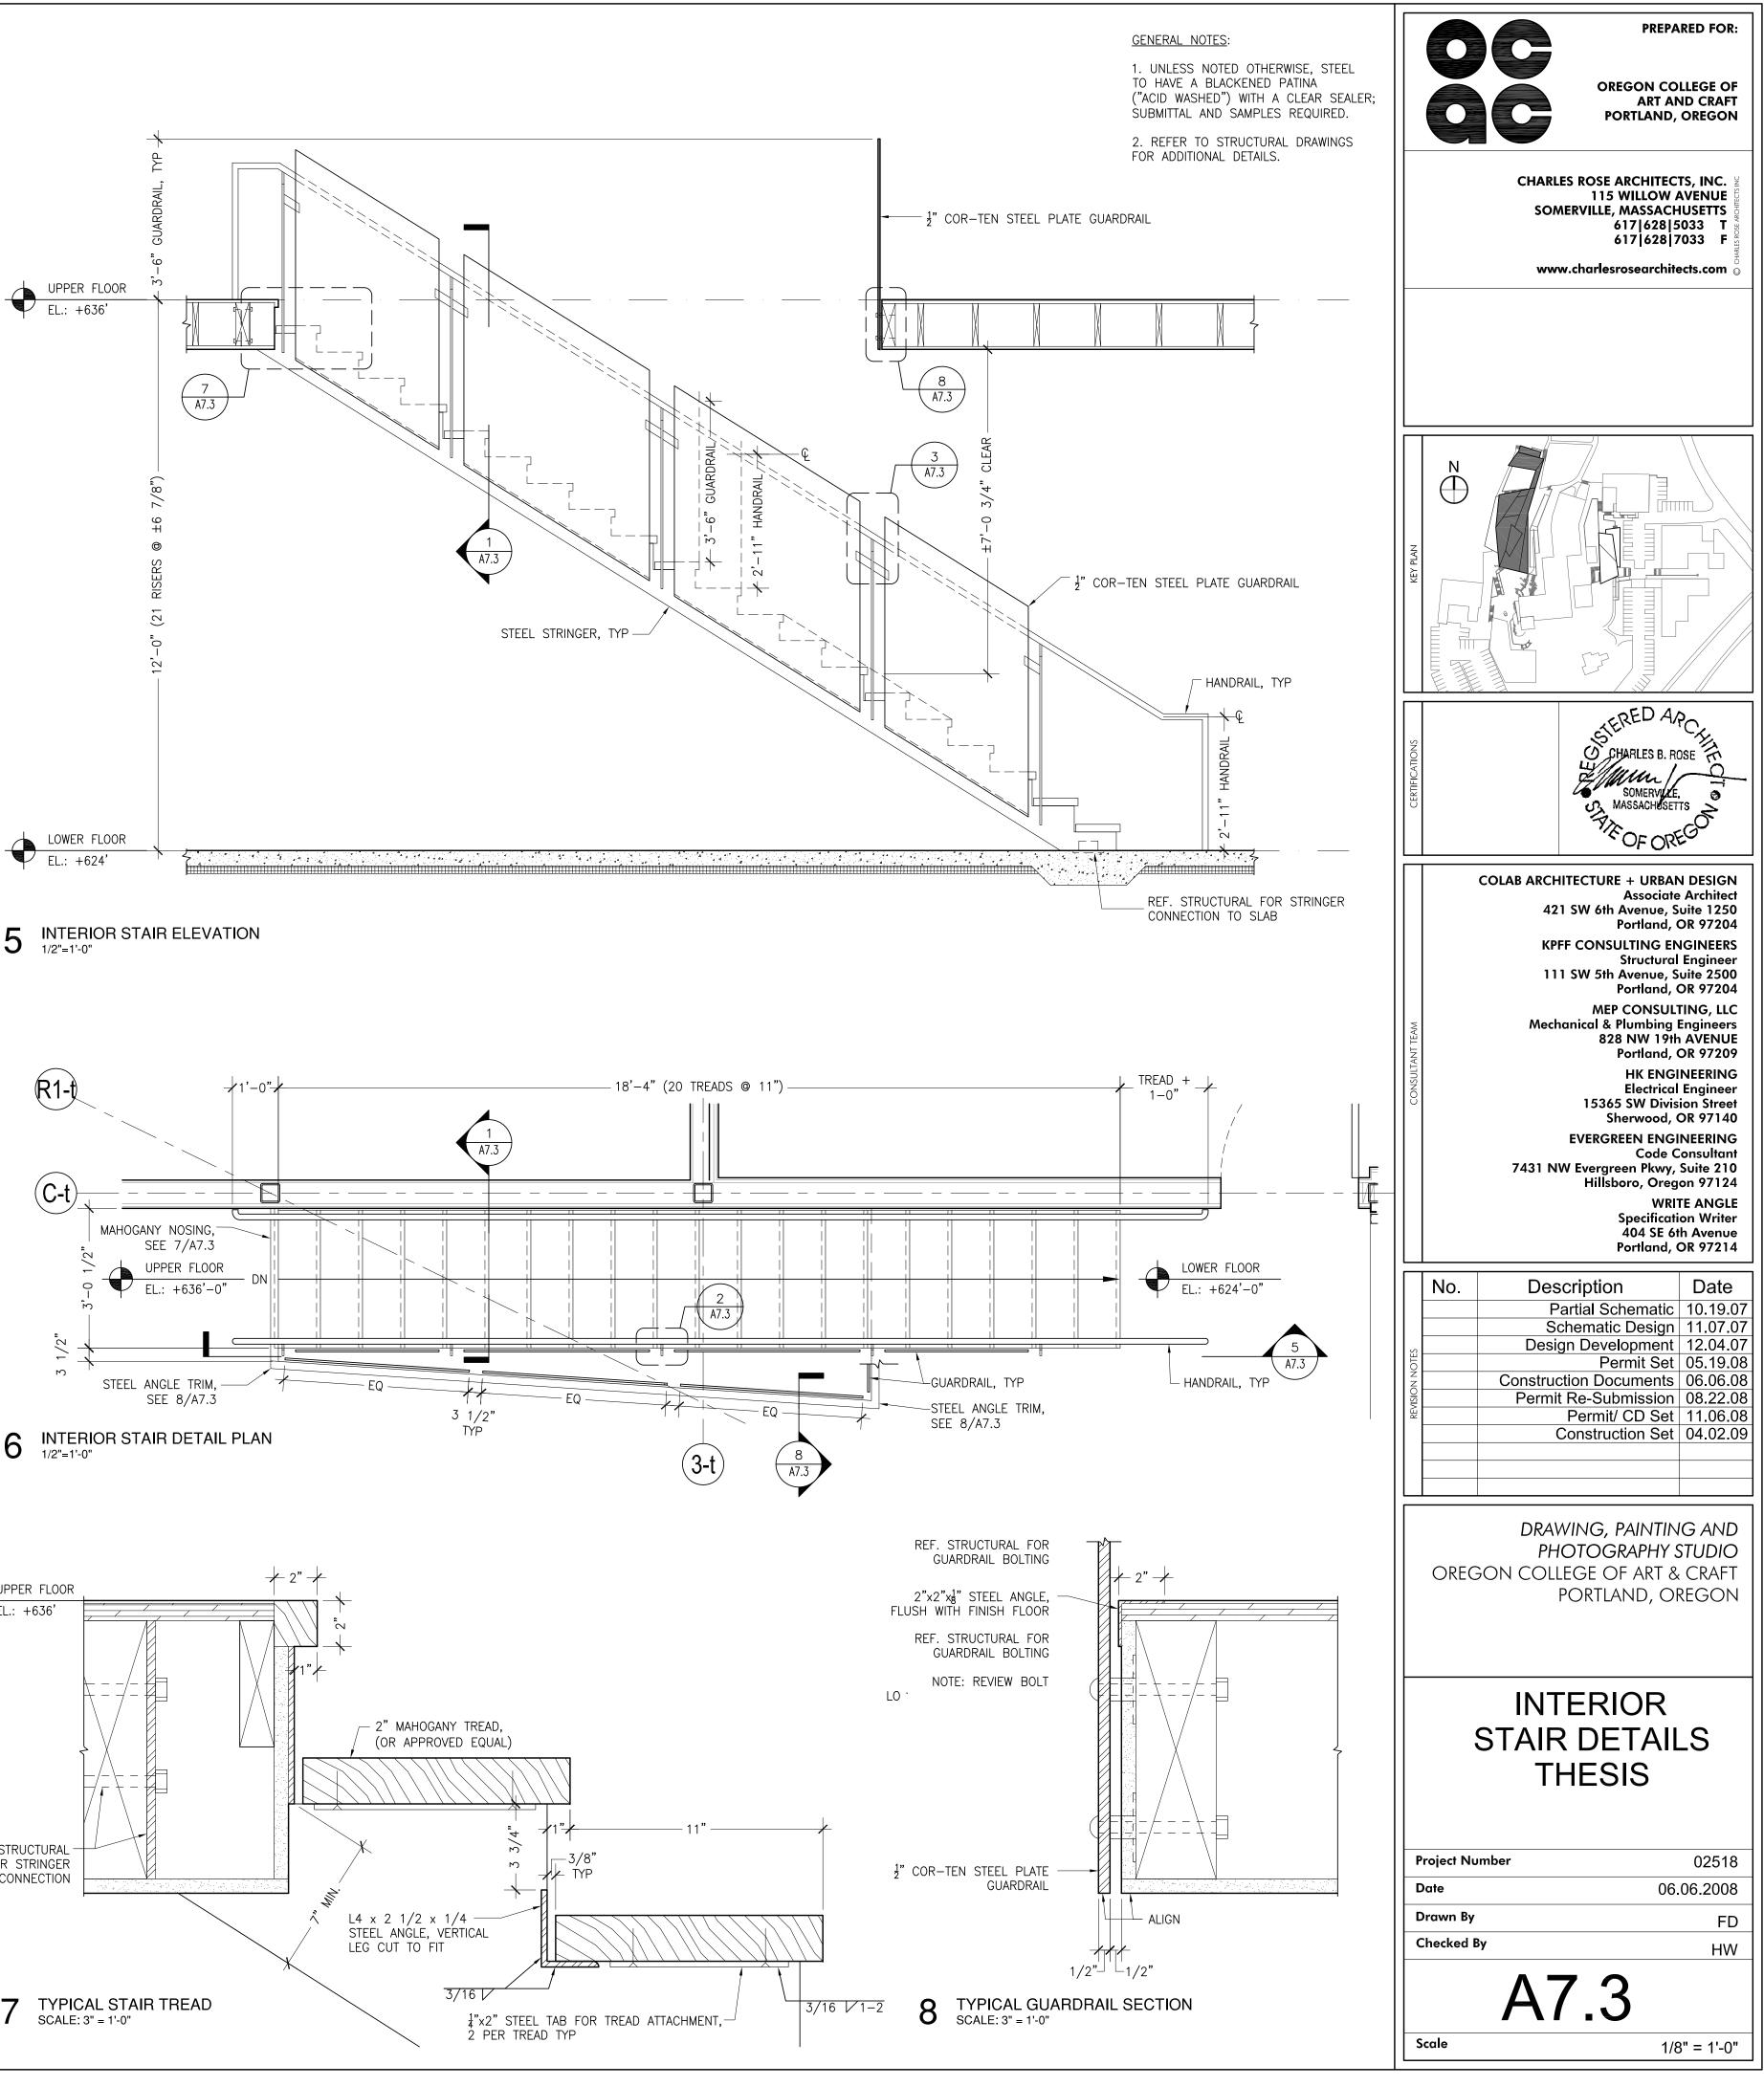

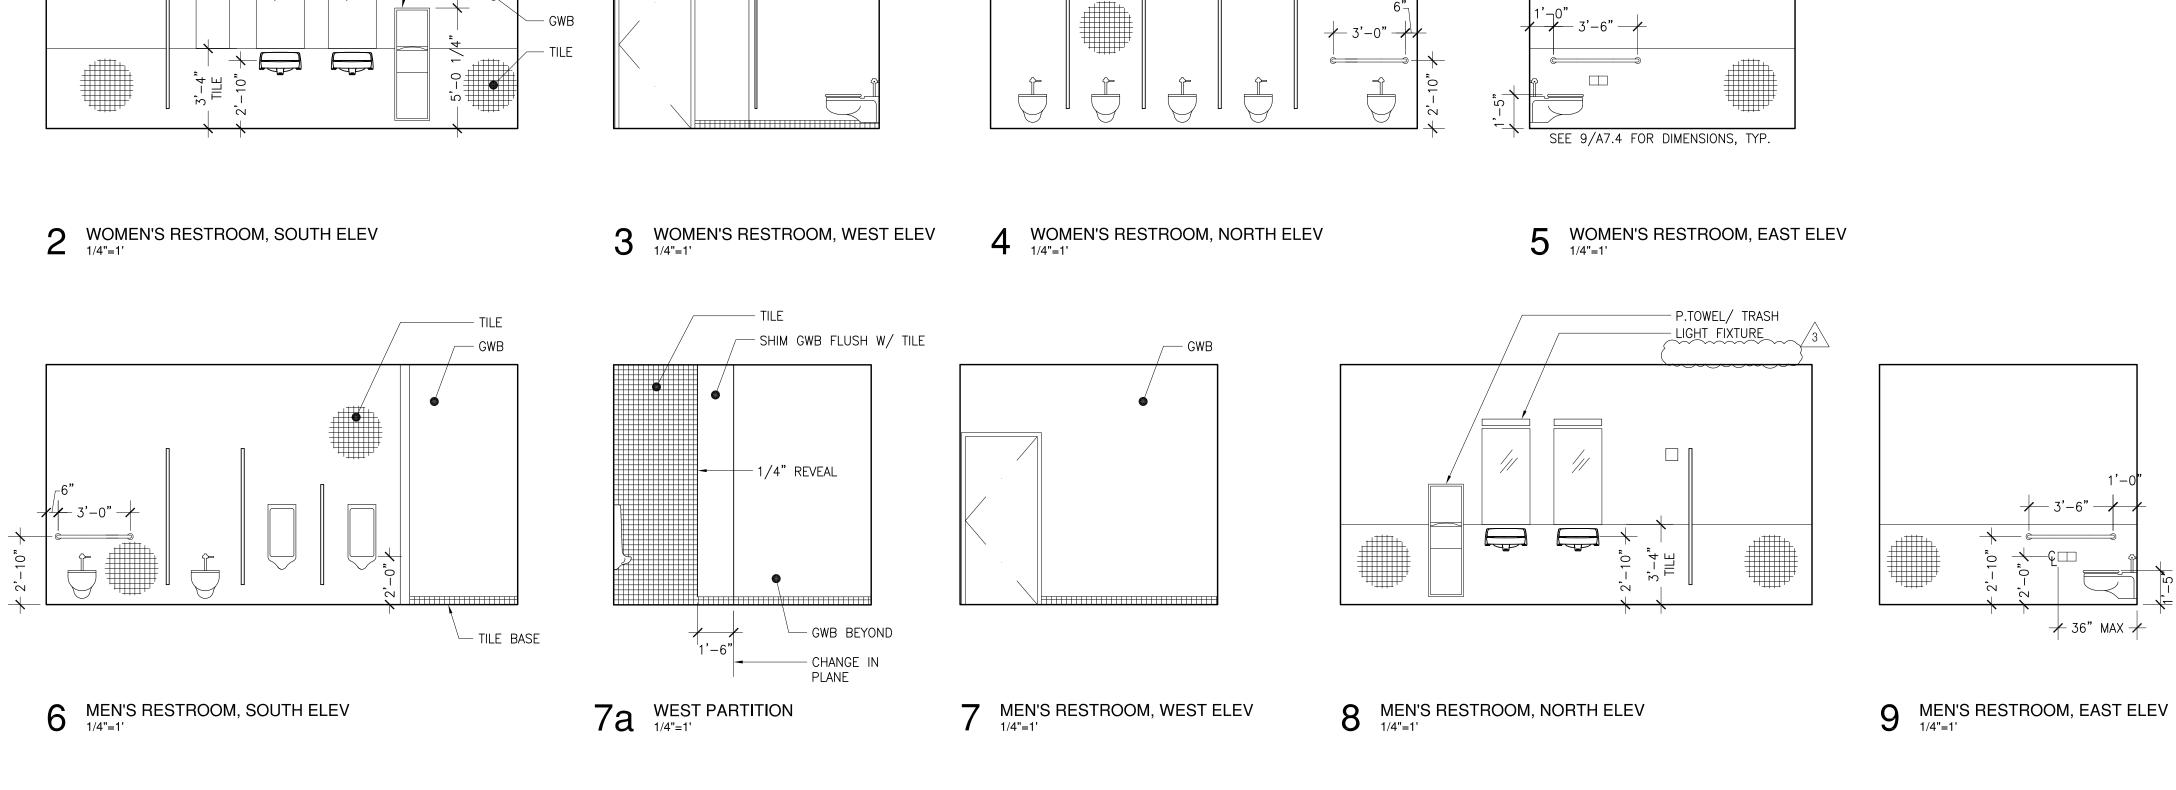





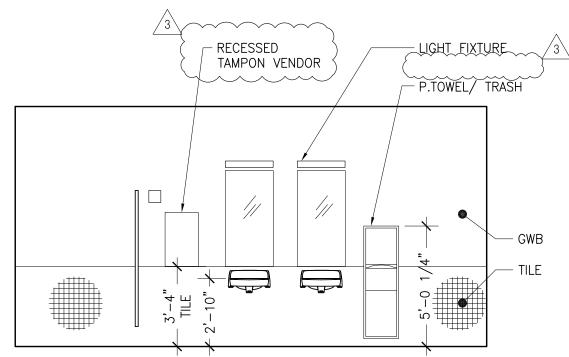



₩₩

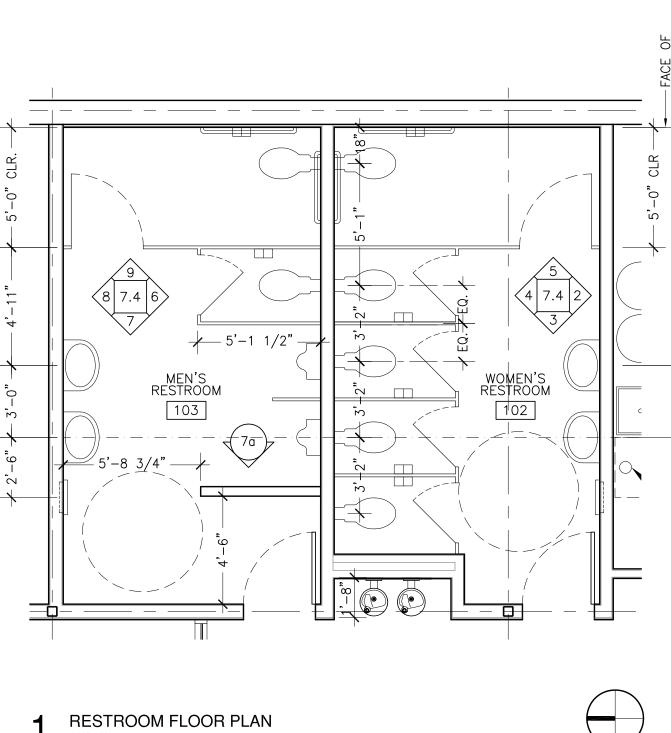


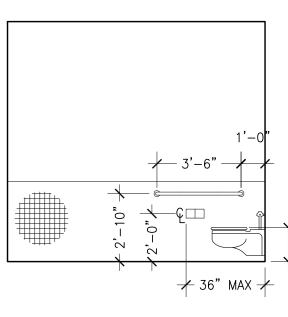









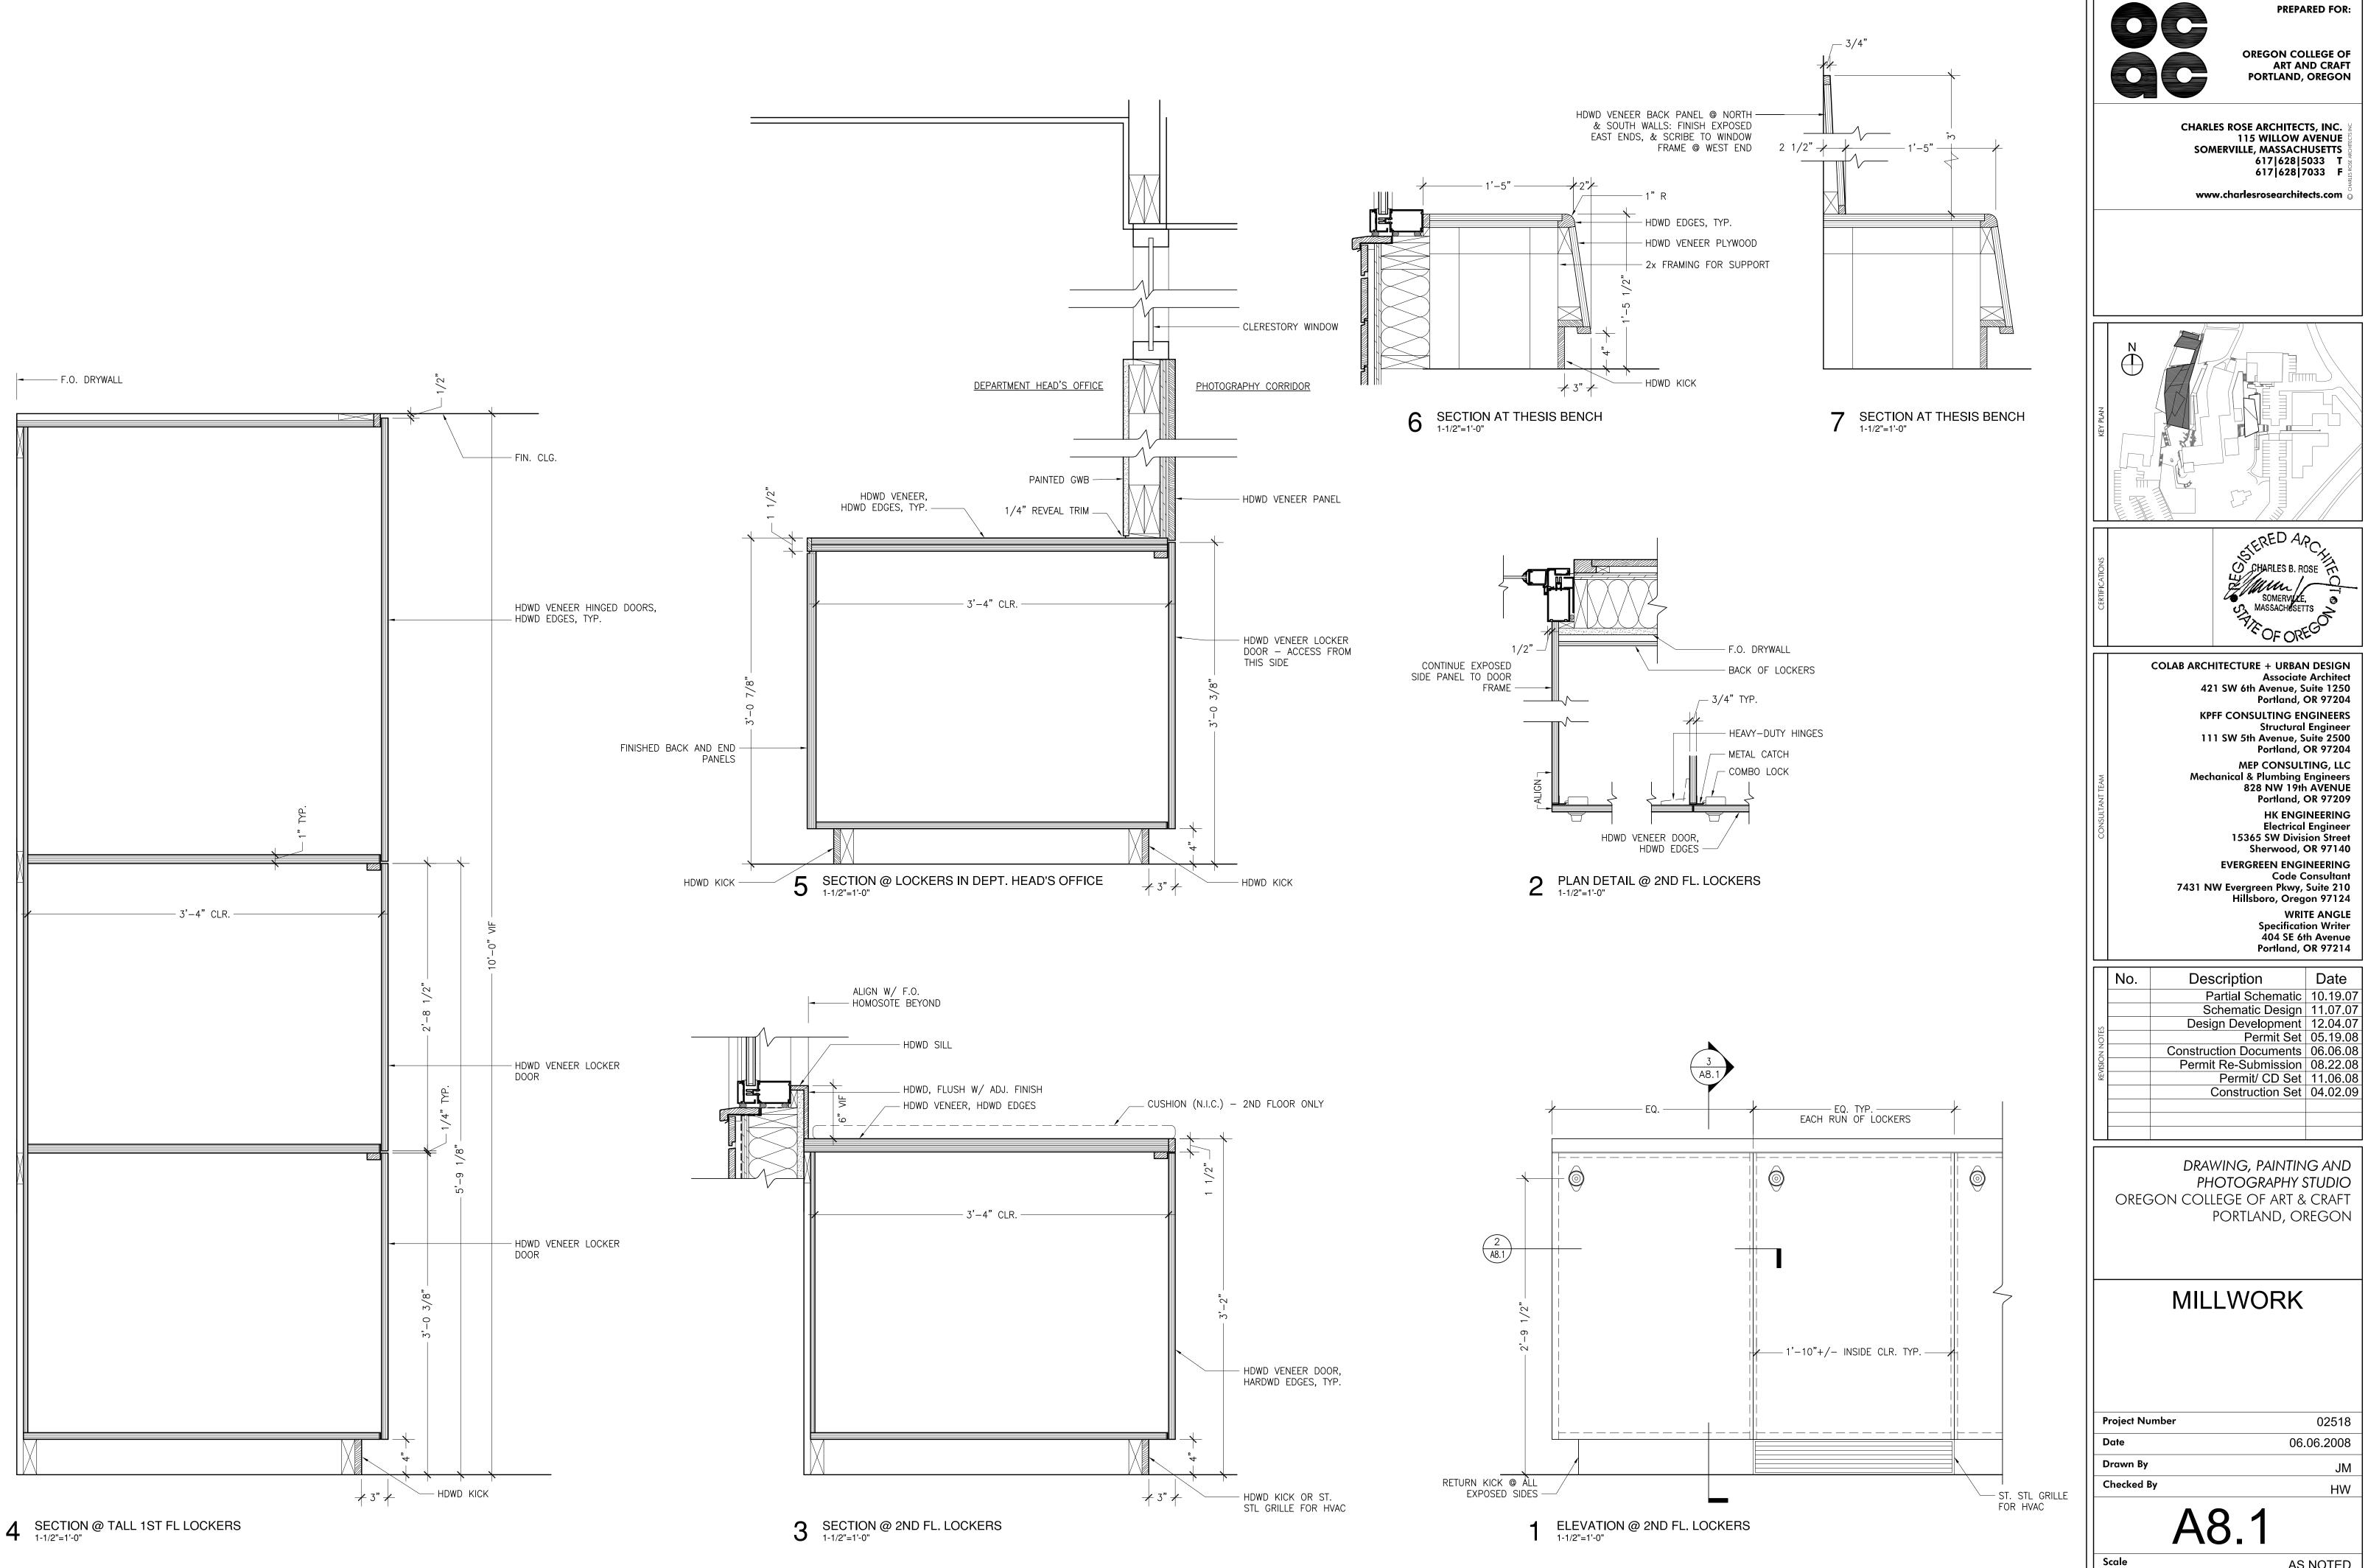


AS NOTED

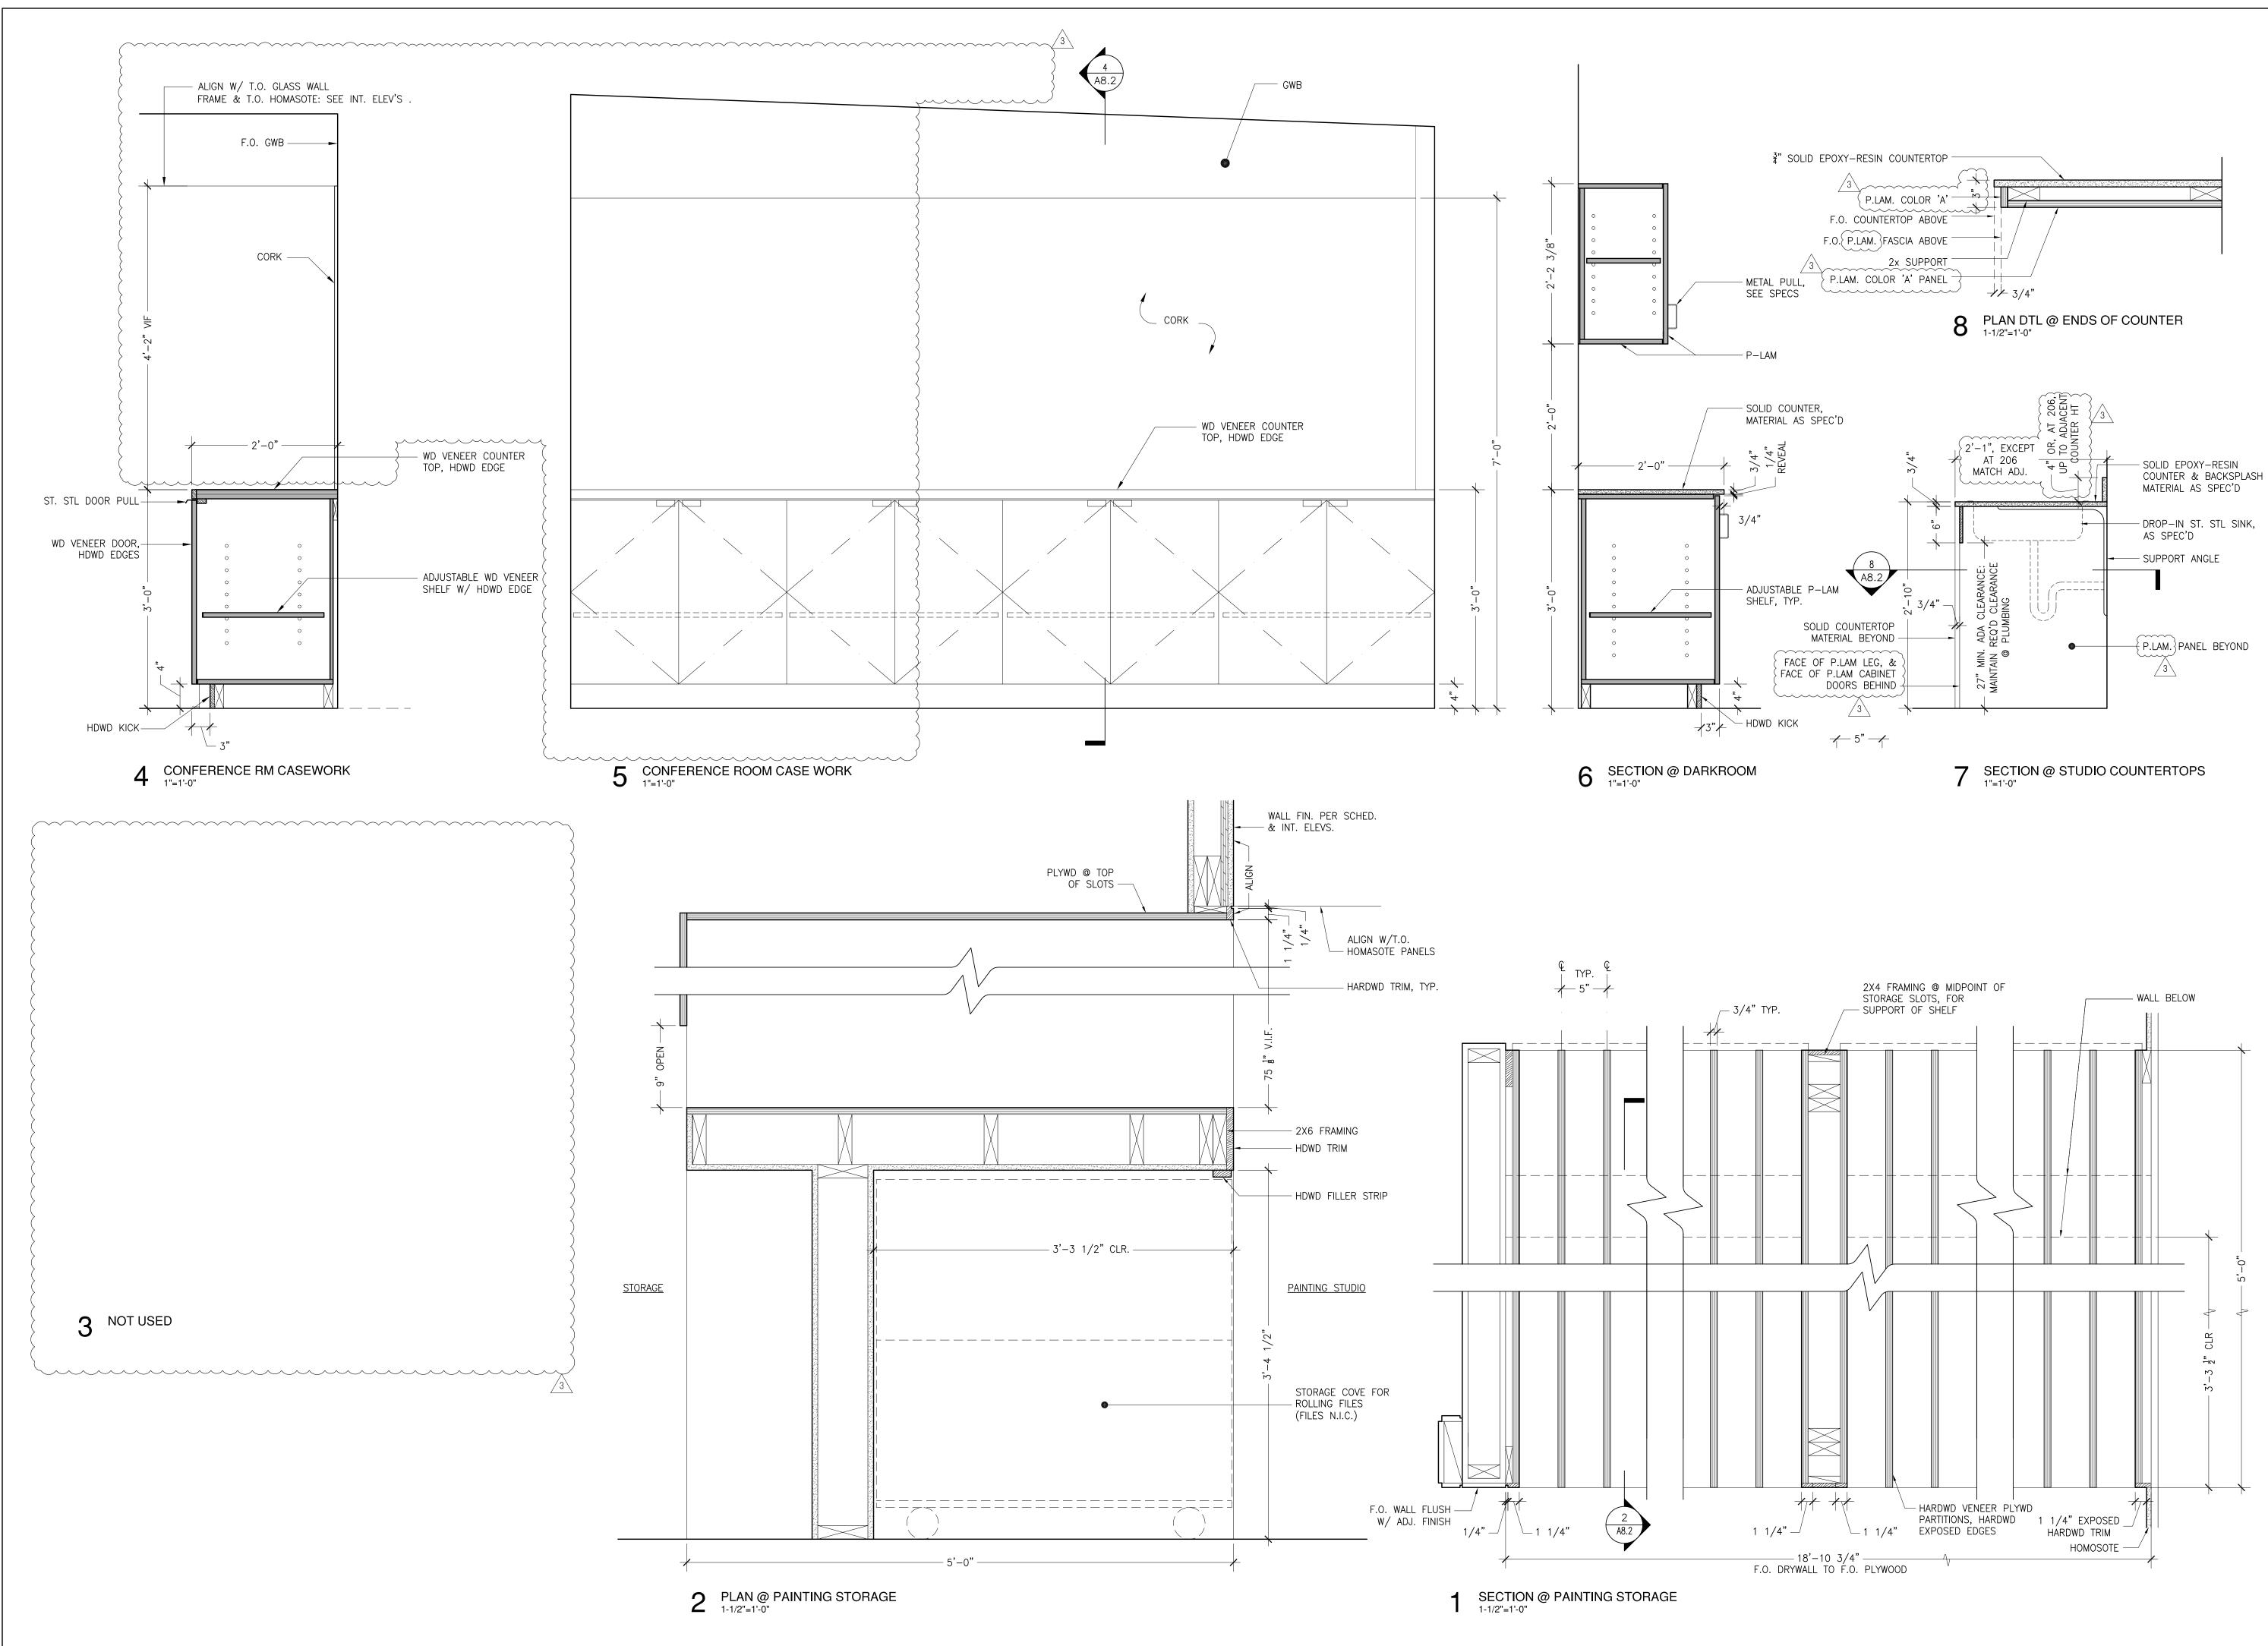




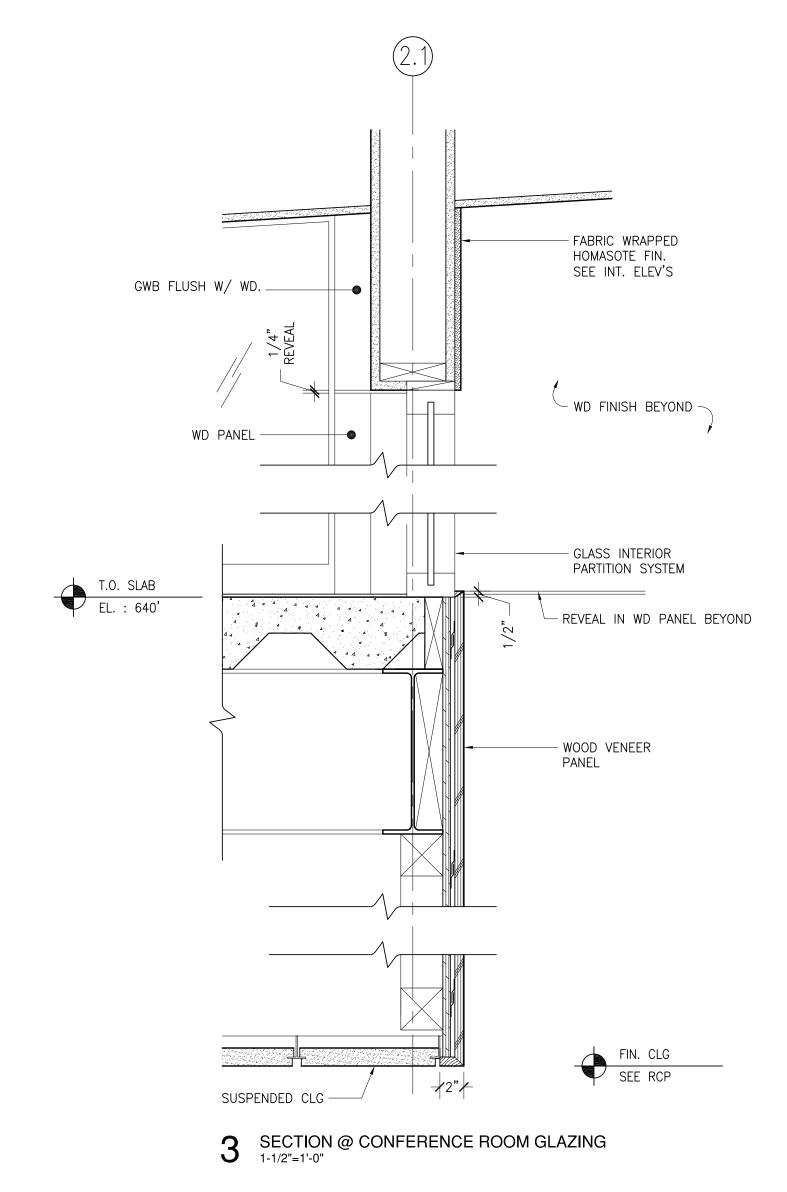





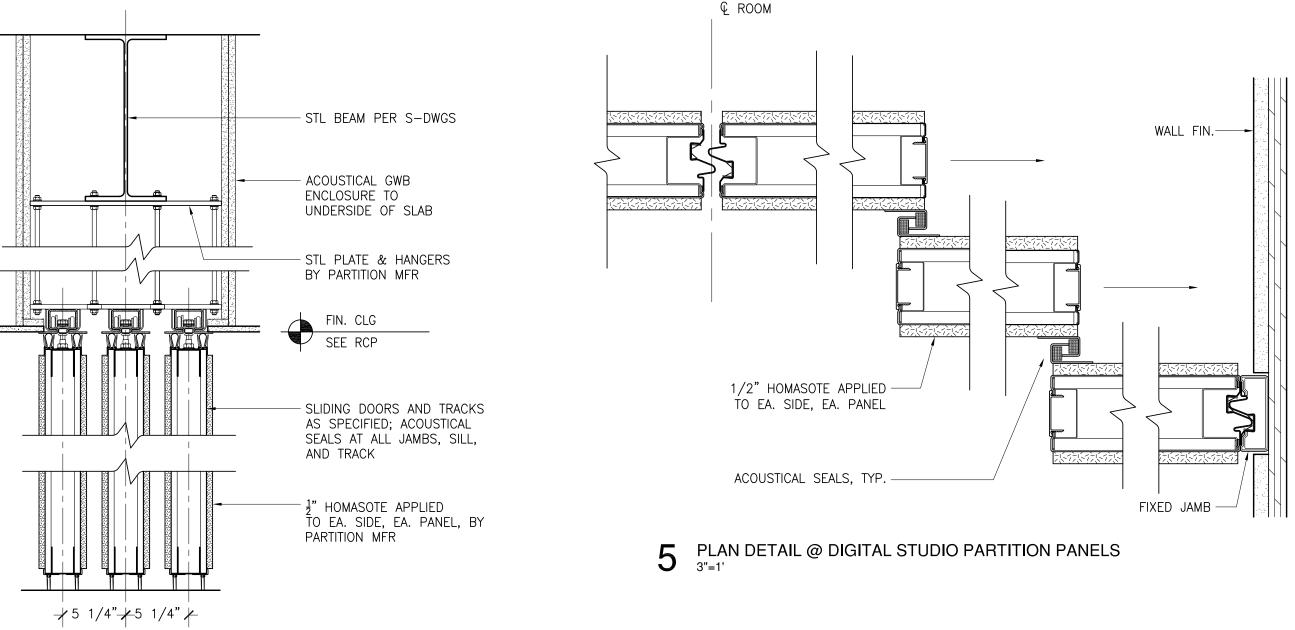




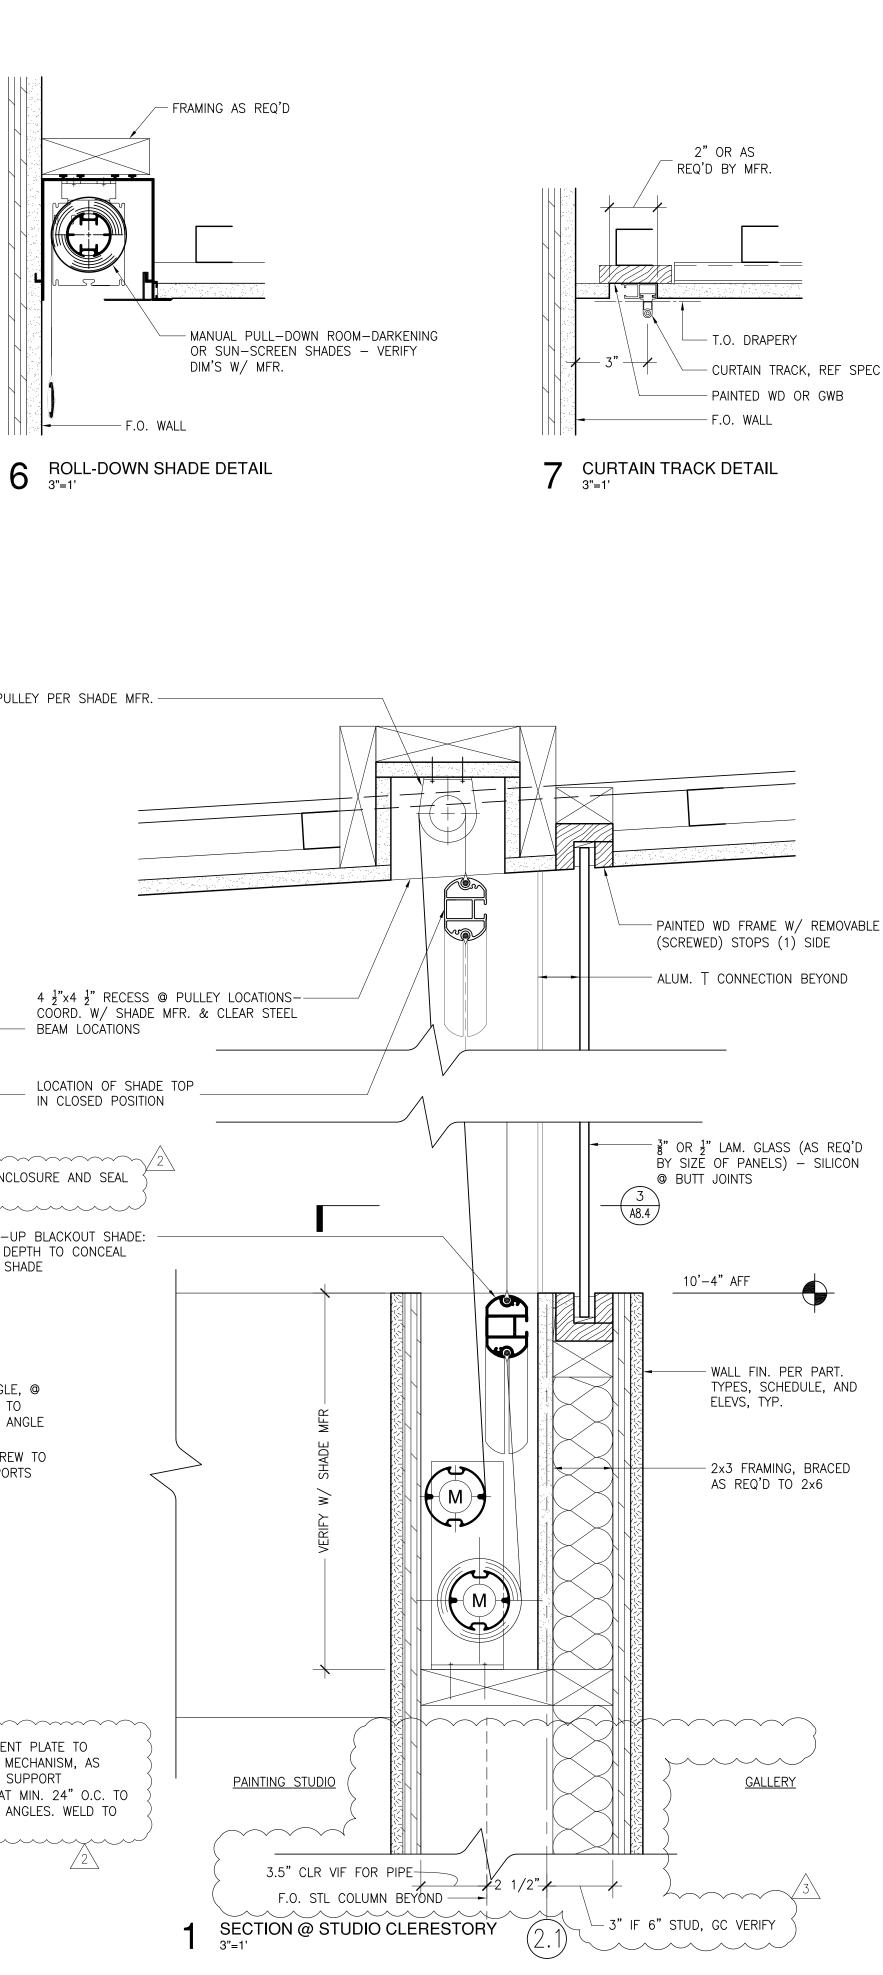

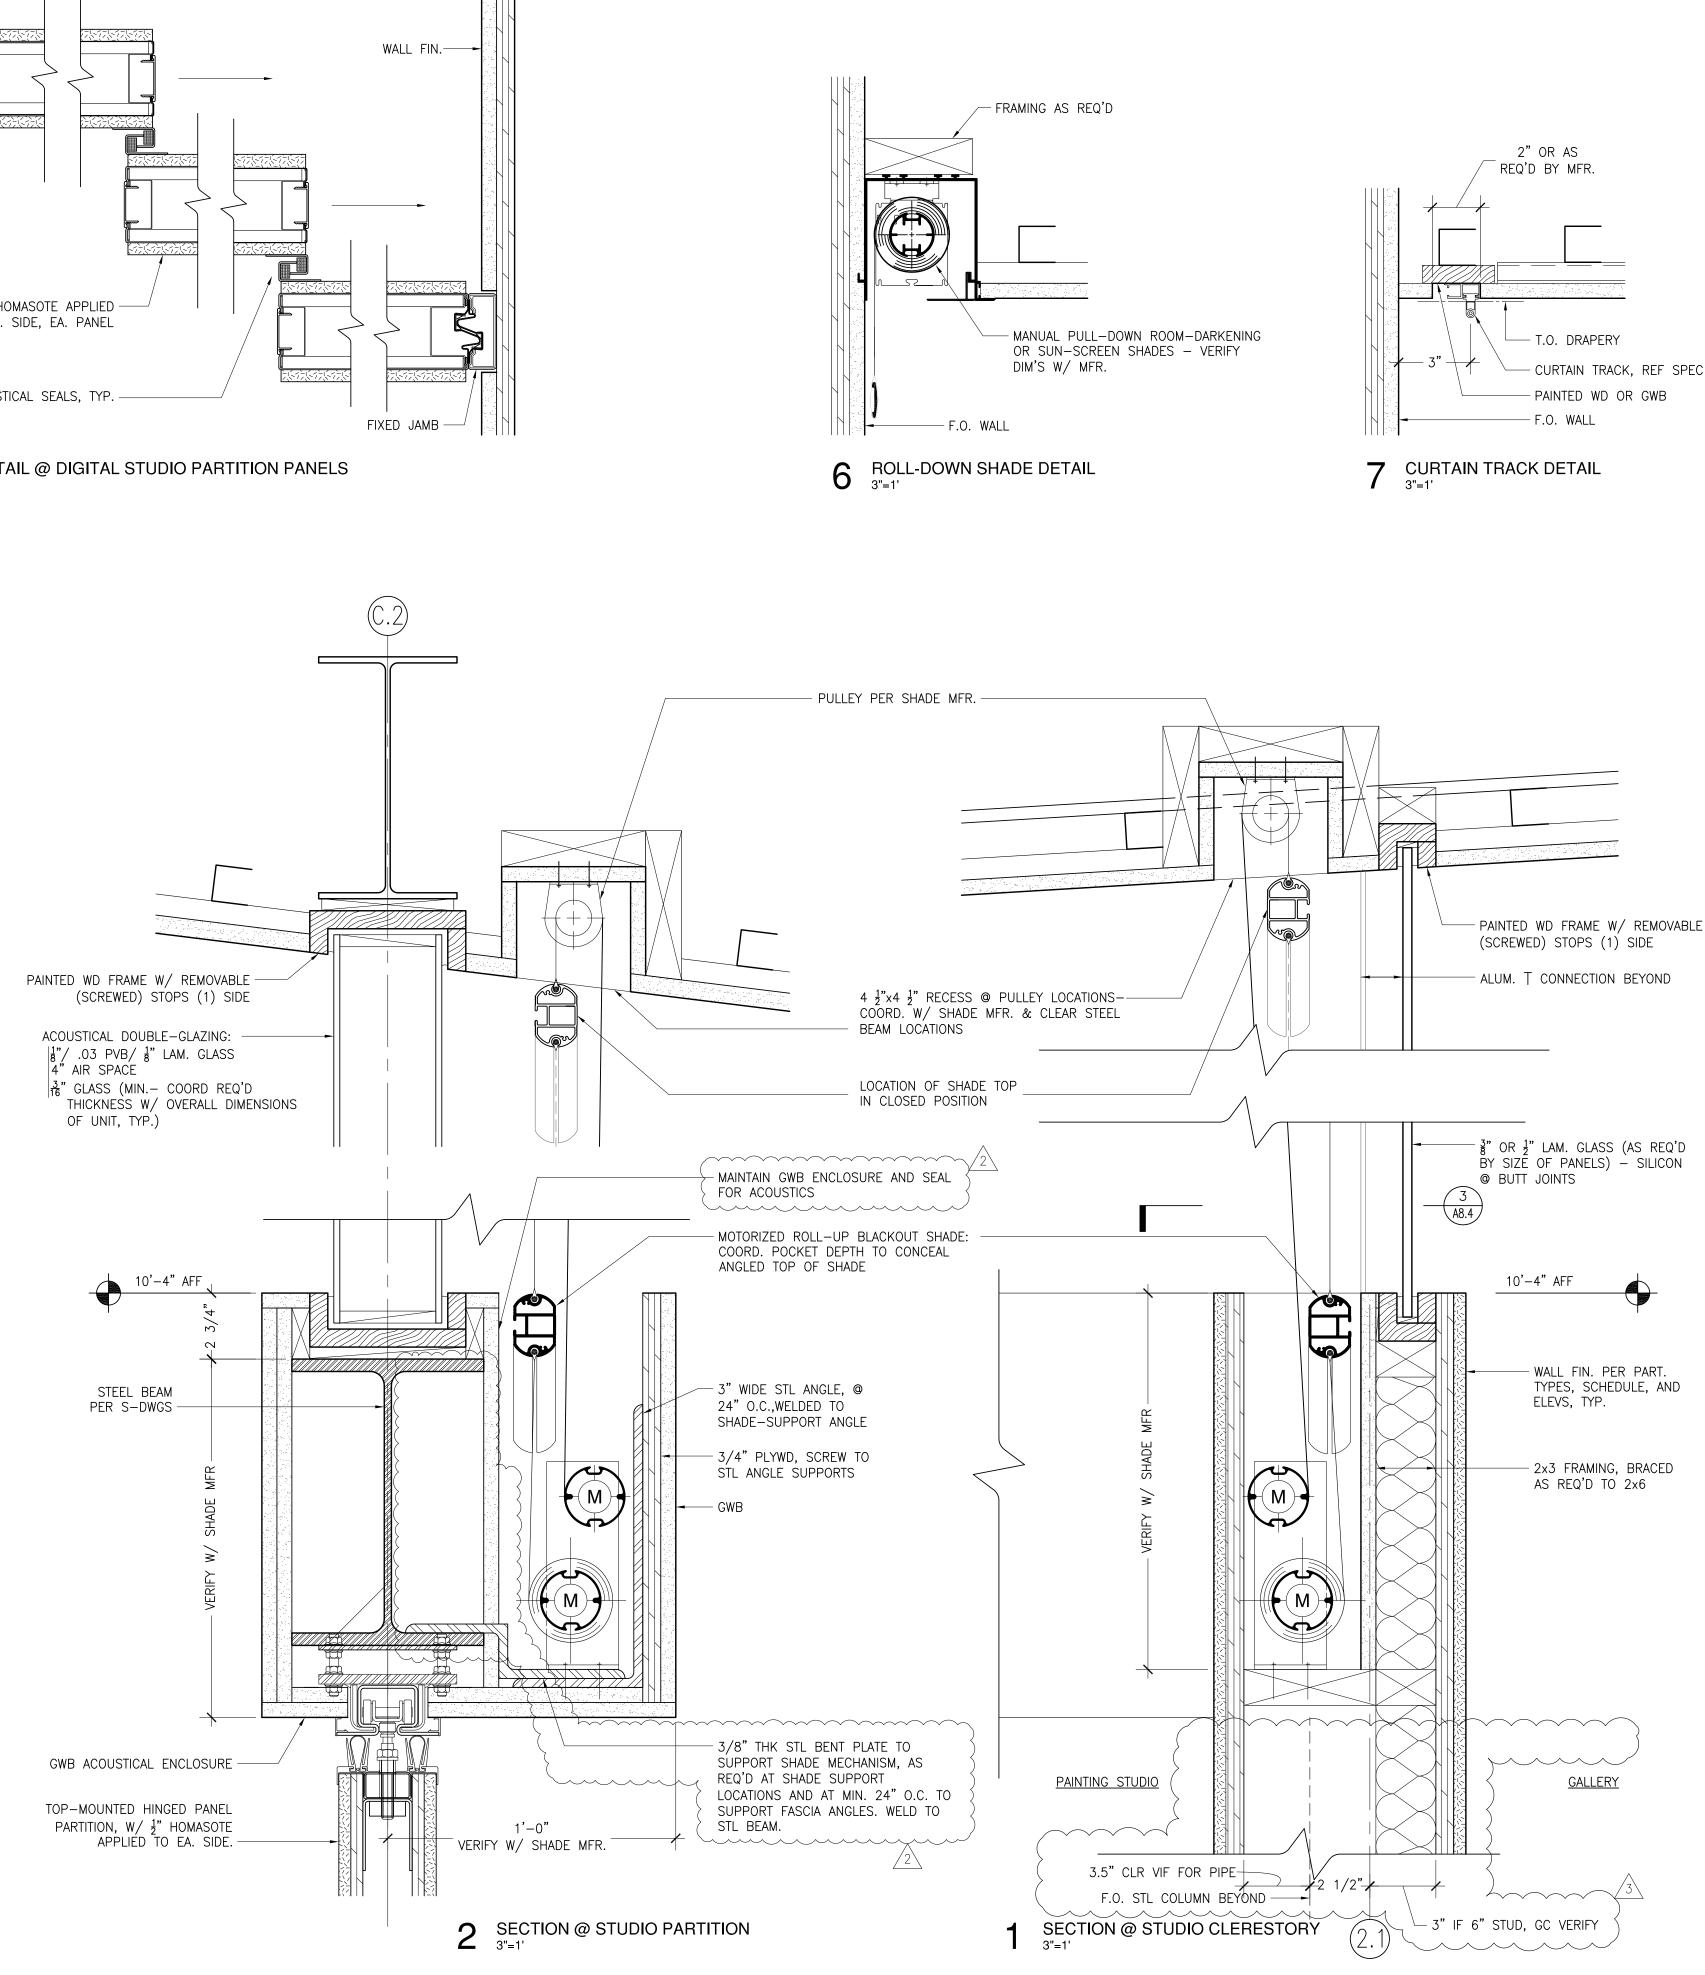

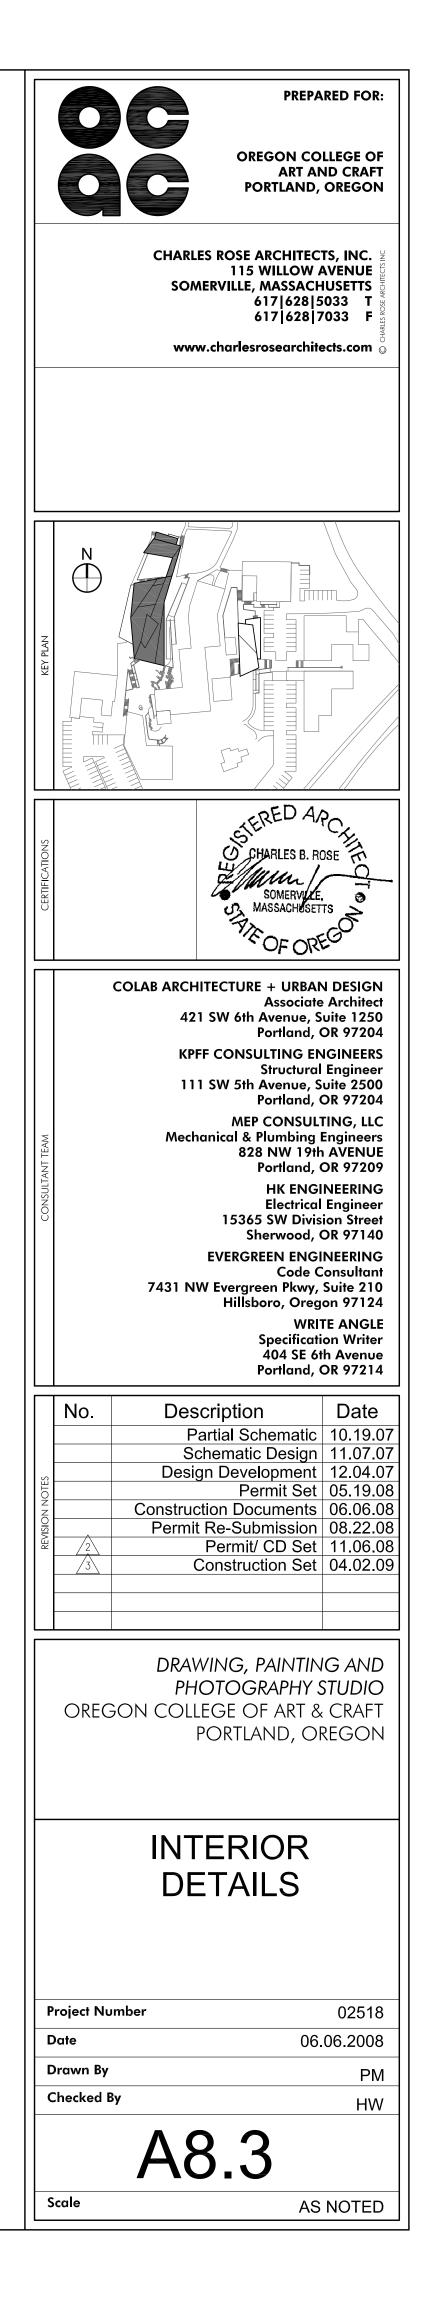

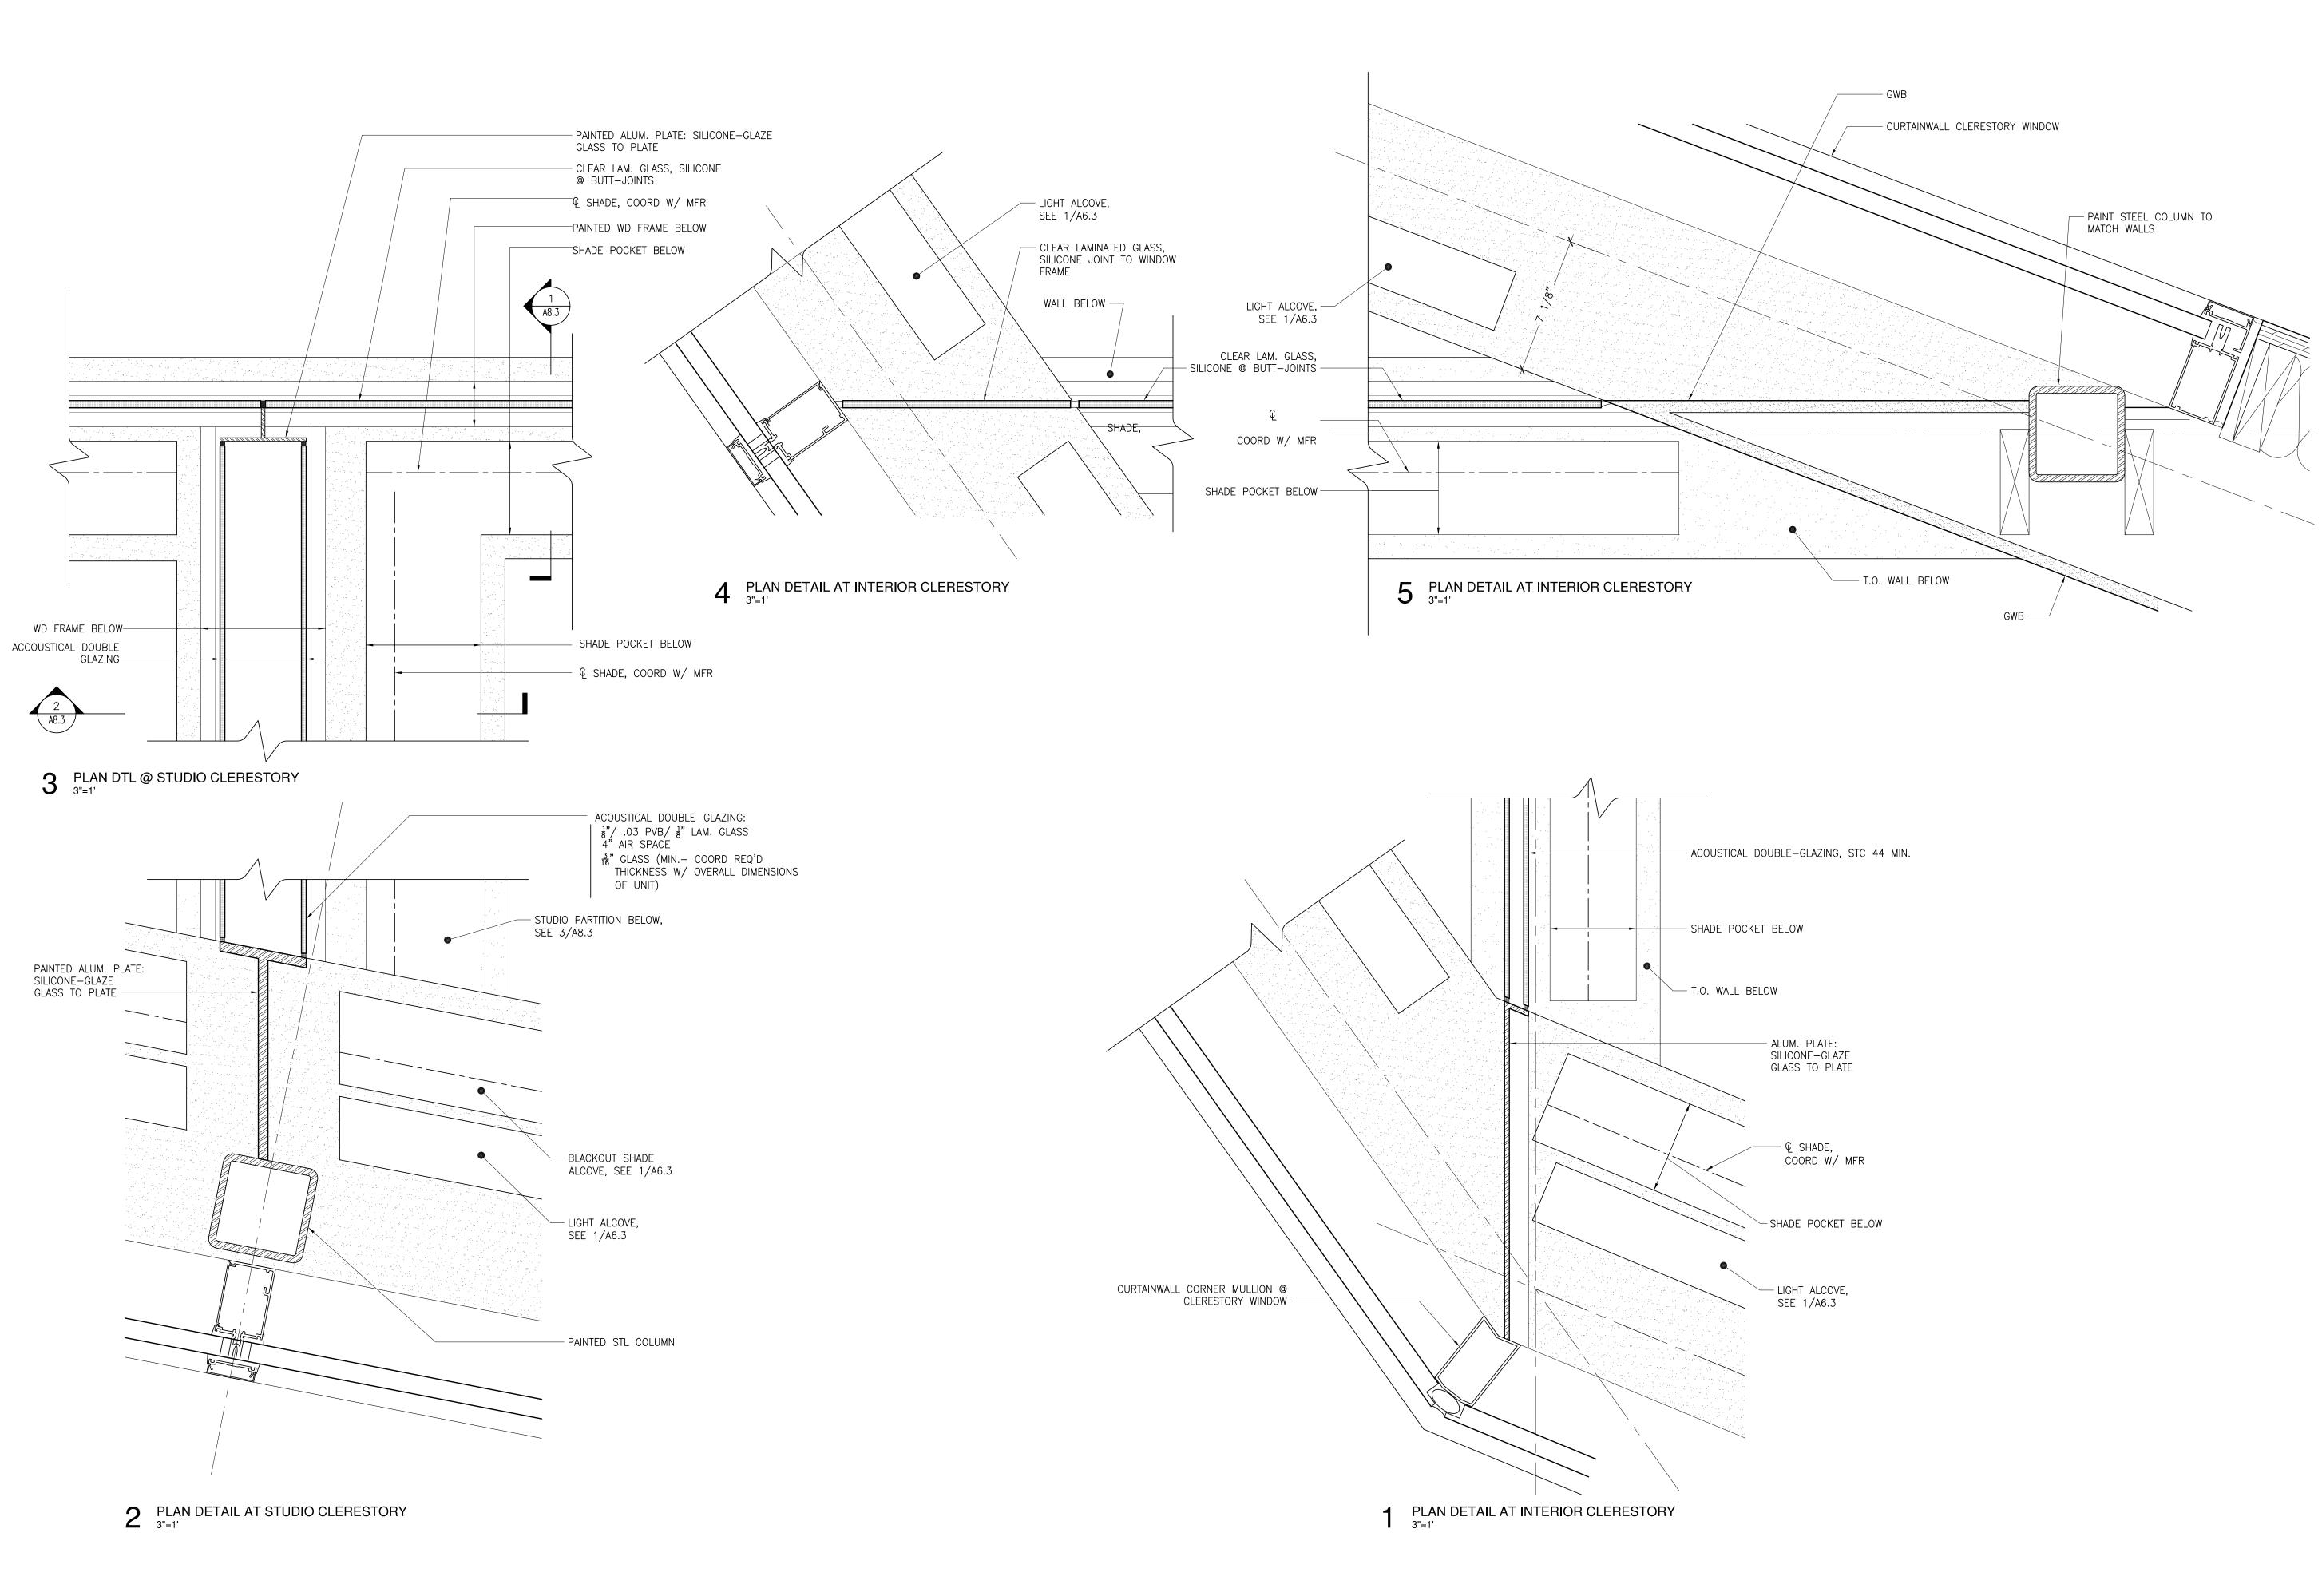

OC OREGON COLLEGE OF ART AND CRAFT PORTLAND, OREGON C OCHARLES ROSE ARCHITECTS, INC. 115 WILLOW AVENUE SOMERVILLE, MASSACHUSETTS 617|628|5033 T 617|628|7033 F www.charlesrosearchitects.com \bigcirc TERED APCL O CHARLES B. ROSE SOMERVILLE, MASSACHUSETTS VIE OF OREG 1 COLAB ARCHITECTURE + URBAN DESIGN Associate Architect 421 SW 6th Avenue, Suite 1250 Portland, OR 97204 **KPFF CONSULTING ENGINEERS** Structural Engineer 111 SW 5th Avenue, Suite 2500 Portland, OR 97204 MEP CONSULTING, LLC Mechanical & Plumbing Engineers 828 NW 19th AVENUE Portland, OR 97209 **HK ENGINEERING** Electrical Engineer 15365 SW Division Street Sherwood, OR 97140 EVERGREEN ENGINEERING Code Consultant 7431 NW Evergreen Pkwy, Suite 210 Hillsboro, Oregon 97124 WRITE ANGLE Specification Writer 404 SE 6th Avenue Portland, OR 97214 No. Description Date Partial Schematic 10.19.07 Schematic Design 11.07.07 Design Development 12.04.07 Permit Set 05.19.08 Construction Documents06.06.08Permit Re-Submission08.22.08Permit/ CD Set11.06.08Construction Set04.02.09 DRAWING, PAINTING AND PHOTOGRAPHY STUDIO OREGON COLLEGE OF ART & CRAFT PORTLAND, OREGON MONITOR DETAILS Project Number 02518 Date 06.06.2008 Drawn By РM Checked By HW A8.4 Scale AS NOTED


PREPARED FOR:

UNDERSIDE OF DECK, TYP. ACOUSTICAL SEALANT @ TOP, BOTTOM, AND ALL SIDES (A3, A4)	 ¹/₂" GWB ABOVE, IF HOMASOTE STOPS SHORT OF CLG: SEE ELEVS. ³/₄" PLYWD ³/₄" GWB ³/₄ Coustical sealant @ top, Bottom, AND ALL SIDES (B3, B4) ³/₈" GWB ³/₄" Acoustical Batt (B3, B4) ³/₄ Acoustical Batt (B3, B4) ¹/₄ NT. FINISH @ WALL & BASE - SEE FINISH SCHEDULE & INTERIOR ELEVATIONS, TYP.
 TYP. INTERIOR WALL SAME AS A1 BUT WITH 2X4 STUDS (A2) (A3) SAME AS A1 BUT WITH ACOUSTICAL SEALANT / BATT SAME AS A2 BUT WITH ACOUSTICAL SEALANT / BATT 	 TYP. WALL WITH PINNABLE SURFACE SAME AS B1 BUT WITH 2X4 STUDS G16"o.c. (OR 3-§" METAL STUDS) SAME AS B1 BUT WITH ACOUSTICAL SEALANT / BATT SAME AS B2 BUT WITH ACOUSTICAL SEALANT / BATT
GENERAL NOTES: 1. MOISTURE RESISTANT GWB @ ALL WET LOCATIONS 2. PROVIDE BLOCKING @ ALL PARTITIONS AS REQ'D TO SUPPORT WALL-MOUNTED CASEWORK, EQUIPMENT, HANDRAILS, ETC. DO NOT ALLOW BLOCKING TO BRIDGE STAGGERED STUDS @ ACOUSTICAL TYPE F OR G PARTITIONS. 3. FOR PARTITION TYPES NOTED "SIM", SEE APPLICABLE WALL SECTIONS/DTLS.	1/2" GWB ABOVE, IF HOMASOTE STOPS SHORT 0F CLG: SEE ELEVS. 1/2" PLYWD ACOUSTICAL BATT B.O. DECK, TYP. ACOUSTICAL SEALANT @ TOP, BOTTOM, AND ALL SIDES 8" GWB 1" HOMASOTE (OR OTHER PINNABLE MATERIAL: SEE INT. ELEVS AND FIN. SCHEDULE) INT. FINISH @ WALL & BASE - SEE FINISH SCHEDULE & INTERIOR ELEVATIONS, TYP. INT. FINISH @ WALL & BASE - SEE FINISH SCHEDULE & INT. FINISH @ WALL & BASE - SEE FINISH SCHEDULE & INT. FINISH @ WALL & BASE - SEE FINISH SCHEDULE & INT. FINISH @ WALL & BASE - SEE FINISH SCHEDULE & INT. FINISH @ WALL & BASE - SEE FINISH SCHEDULE & INTERIOR ELEVATIONS, TYP.


F2 SIM TO F1, WITH PLY & HOMASOTE ON EACH SIDE


⟨F3⟩ SIM TO F1, BUT §" GWB ON EACH SIDE


(F4) SIM TO F1, BUT 8" TOP & BOTTOM PLATE

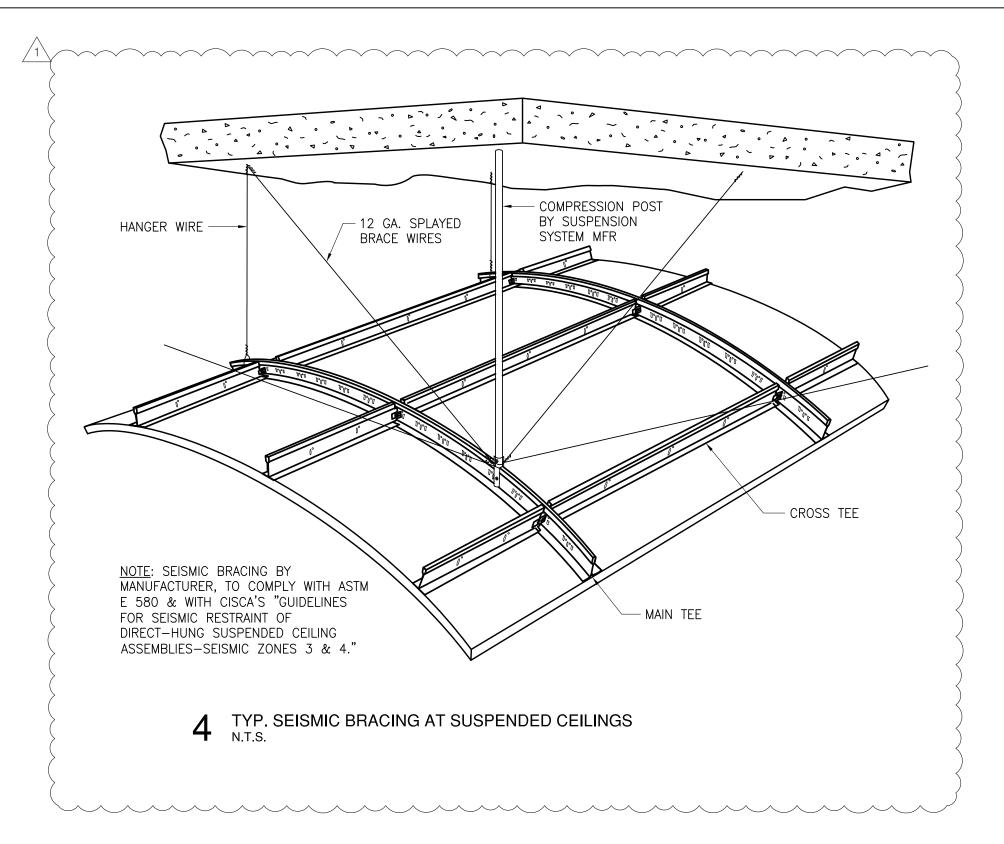

© Copyright 2010

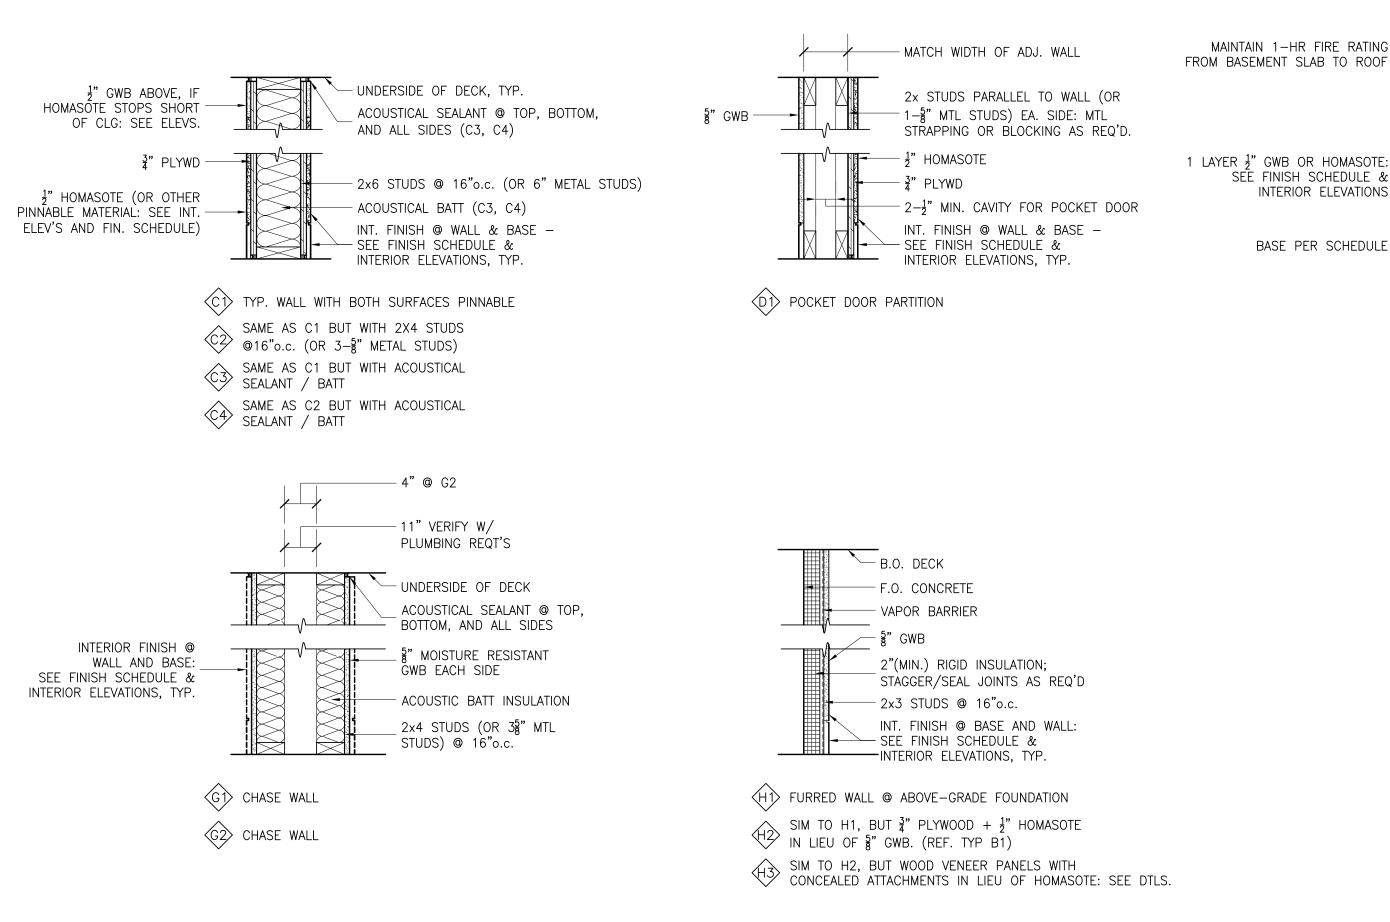


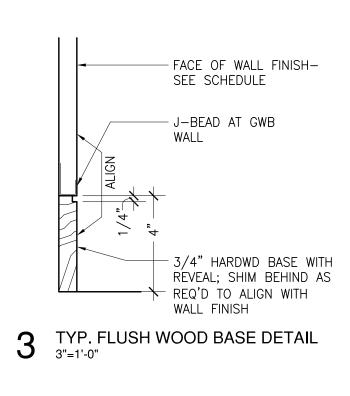

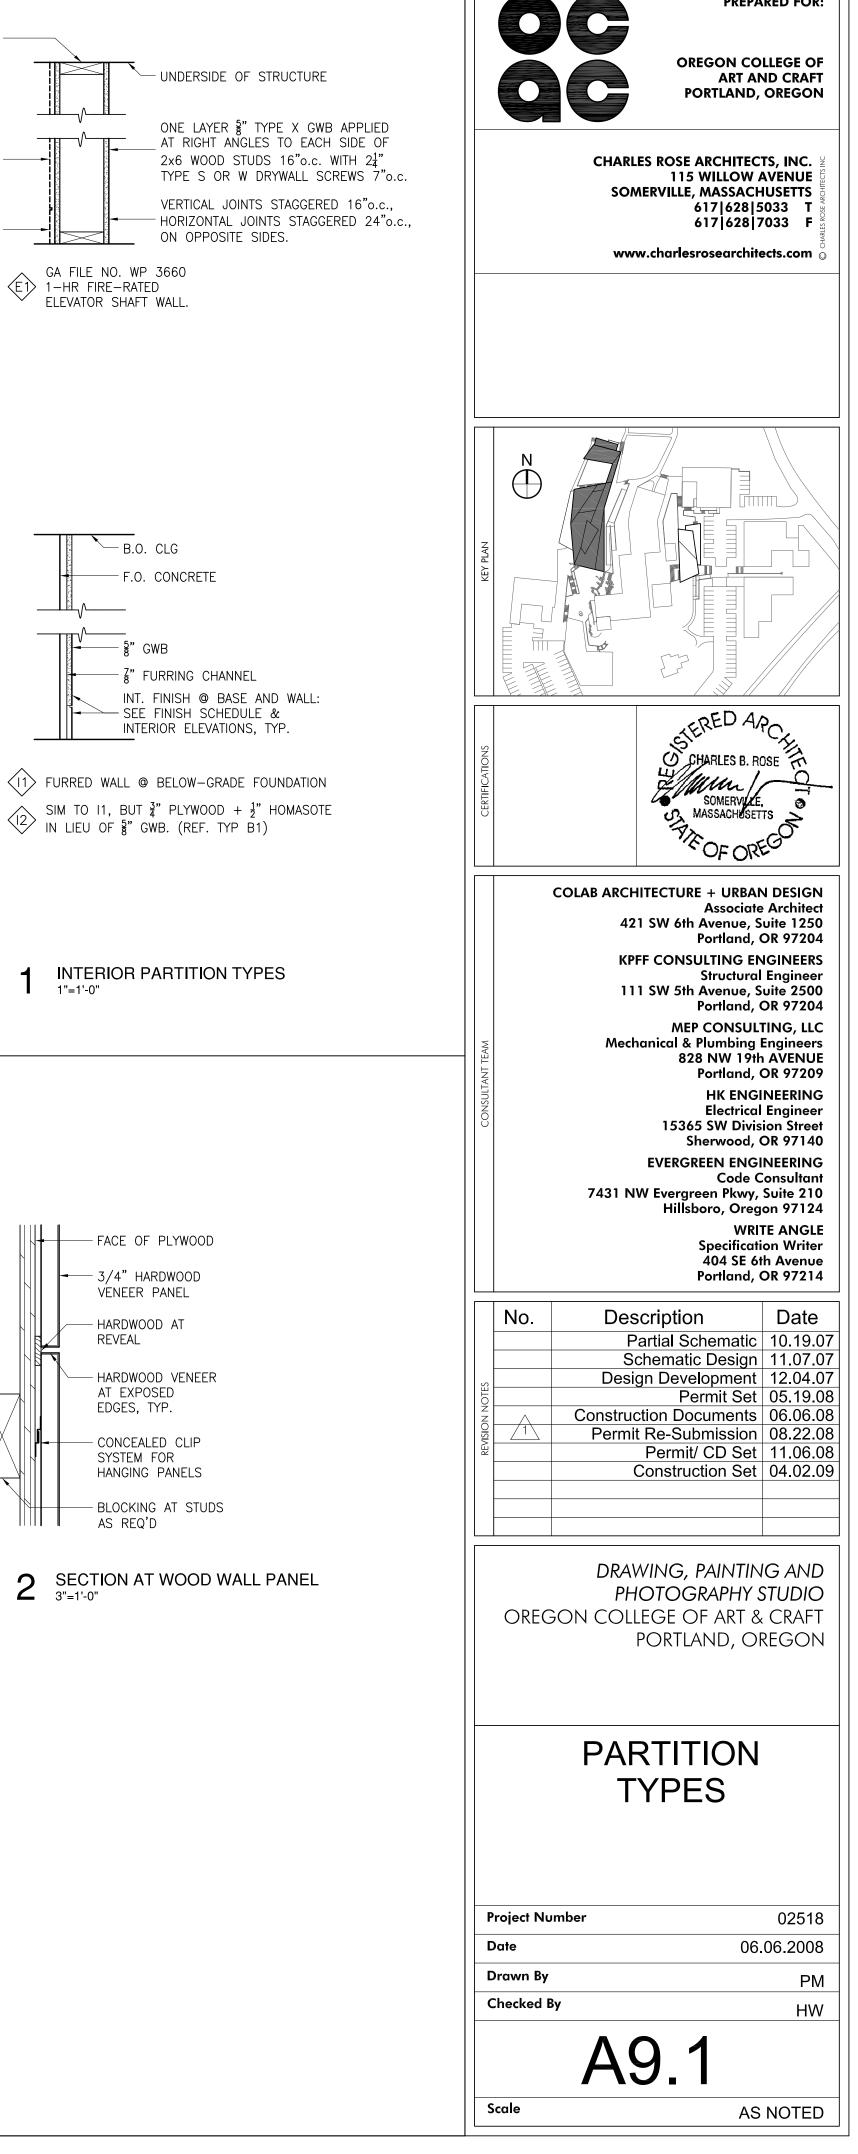

PREPARED FOR:

1"=1'-0"

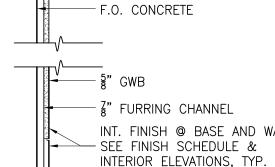

GA FILE NO. WP 3660 E1 1-HR FIRE-RATED ELEVATOR SHAFT WALL.


MAINTAIN 1-HR FIRE RATING FROM BASEMENT SLAB TO ROOF

SEE FINISH SCHEDULE & -

INTERIOR ELEVATIONS

BASE PER SCHEDULE -

MARK	DESCRIPTION	COLOR	ROOM NAME		tun	FLOOR	CEILING	WALLS					NOTES	
FLOOR FIN Conc	ISHES Exposed concrete slab, integrally-colored & sealed	COBBLESTONE", DAVIS COLORS)			3		NORTH	EAST	SOUTH	WEST	BASE	3	
-Conc-2	Exposed concrete slab, integrally believed a bealed Exposed concrete slab, sealed)	100A SOUTH	VESTIBULE	F-Conc2	C-Gpsm	W-Hmste	-	W-Cork	-	B-Wood 2 @ COF	/	
_ino_1	Linoleum w/ acoustical backing	Marmoleum Decibel 62435	1ST FLOOR PHOTOGRAPHY	100B SOUTH	CORRIDOR	F-Conc2	C-Wood	W—Hmste/Glass	W-Cork/Tile-Custom	W-Cork	W-Hmste	B-Wood @ HMSTE B-Wood 2 @ COF		
<u>_ino-2</u> _ino-3	Linoleum Linoleum w/ acoustical backing	Marmoleum Reale "KYOTO" Marmoleum Decibel 62935	DEPARTMENT								W THISE	B-Wood @ HMSTE	E WALLS	
	Ceramic mosaic tile	Daltile Keystones SUEDE GRAY D182, 1x1	$\langle $	101A MECHA	NICAL ROOM	F-Conc2	Exposed	W-Gpsm	W-Gpsm 3	W-Gpsm	W-Gpsm	B-Vinyl		
			$\langle $		FOR MACHINE ROOM	F-Conc2	Exposed	W-Gpsm	W-Gpsm	W-Gpsm	W-Gpsm			
WALL FINIS	SHES		$\left\{ \right\}$		N'S RESTROOM RESTROOM	3 F-Tile	C-Gpsm C-Gpsm	W-Tile W-Tile/Gpsm	W-Gpsm/Tile W-Gpsm/Tile	W-Tile/Gpsm W-Tile/Gpsm	W-Gpsm W-Gpsm	B-Tile B-Tile		
-Conc	Exposed retaining wall, no finish	<u>}</u>	$\left\{ \right\}$	104A DIGITAL		F-Conc2	C-Gpsm	W-Hmste	W-Hmste	W-Hmste	W-Hmste	B-Wood		
-Cork	Cork sheet	CLARIDGE NU-CORK (NATURAL COLOR)	$\langle $	104B FINISH		F-Conc2	C–Gpsm	W-Hmste	W-Hmste	W-Hmste	W-Hmste	B-Wood		
-FWP	Fabric wrapped tackable wall panel	FABRIC="SILVER PAPIER", 2100, GUILFORD OF MAINE	\leq	105 CLASS	ROOM	F-Conc2	C-Gpsm	W-Hmste	W-Hmste	W-Hmste	W-Hmste	B-Wood		
Glass	Glass — see elevations and details	WHITE, U.N.O.	$\left \right\rangle$		OOM VESTIBULE	F-Conc2	Exposed	W-Gpsm	W-Gpsm	W-Gpsm	W-Gpsm	B-Vinyl	PAINT CLG. BLACK	
-Gpsm -Gpsm–2	Painted gypsum wall board Skim-coat plaster on gypsum wall board, painted	WHITE, U.N.O.	$\left \right\rangle$	106B GANG		F-Conc2	Exposed	W-Gpsm	-	W-Gpsm	W-Gpsm	B-Vinyl	PAINT CLG. BLACK	
Hmste	Tackable, painted wall panel	WHITE, U.N.O.	$\sum_{i=1}^{n}$	106C FILM D		F-Conc2	Exposed	W-Gpsm		W-Gpsm	W-Gpsm	B-Vinyl	PAINT CLG. BLACK	
Plywd	Unfinished plywood, over furring strips, over gypsum wall boa		$\langle $	106D FILM F 106E FILM F		F-Conc2	Exposed	W-Gpsm	W-Gpsm W-Gpsm	W-Gpsm W-Gpsm	W-Gpsm	B-Vinyl	PAINT CLG. BLACK	
ile			$\langle $		ROOM #2	F-Conc2 F-Conc2	Exposed Exposed	W-Gpsm W-Gpsm	W-Gpsm W-Gpsm	W-Gpsm W-Gpsm	W-Gpsm W-Gpsm	B–Vinyl B–Vinyl	PAINT CLG. BLACK PAINT CLG. BLACK	
Tile-Custom	n Art Project: OCAC Hand Made lile	MATERIAL BY OCAC; INSTALL BY CONTRACTOR	$\leq $		GRAPHY STUDIO	F-Conc2	Exposed	W-Gpsin W-Hmste	W-Hmste	W-Hmste	W-Hmste	B-Wood	PAINT CLG. BLACK	
Wood	Hardwood veneer panel, concealed attachments	BEECH, PER APPROVED SAMPLE	$\left\{ \right\}$		NATIVE PROCESSING	(F-Conc2)	Exposed	W-Gpsm		W-Hmste	W-Gpsm	B-Vinyl	PAINT CLG. BLACK	
CEILING FII			2	108B COATIN		(F-Conc2)	Exposed	W-Gpsm	W-Gpsm	W-Gpsm	W-Gpsm	B-Vinyl	(PAINT CLG. BLACK)	
Gpsm	Painted gypsum wall board	WHITE, U.N.O.	$\langle $		GRAPHY CORRIDOR	F-Conc2	C-Wood	W-Wood	W-Hmste/Wood	W-Hmste/Wood	W-Hmste/Wood	B-Wood 2 @ WO	DOD PANELS	
Gpsm–2	Skim-coat plaster on gypsum wall board, painted	WHITE, U.N.O.	$\left \right\rangle$									B-Wood @ HMSTE	$\frac{2}{4}$ WALLS $\frac{3}{4}$	
Wood	Suspended grid 2x2 ceiling with wood veneer panels	BEECH, PER APPROVED SAMPLE;	$\langle \rangle$	109B NORTH		F-Conc2	C-Wood	-	_					
		GRID = ARMSTRONG "GUNMETAL GRAY"	$\langle $		MENT CAGE	√ F−Conc.−2	Exposed	W-Gpsm	W-Gpsm	W-Gpsm	W-Gpsm 3	B–Vinyl		
osed	No ceiling finish — structure and duct — work are exposed and painted where indicated		$\langle $	1115 STORA	TMENT HEAD OFFICE	F-Conc2 F-Conc2	C-Gpsm	W-Gpsm/Glass	W-Gpsm W-Gpsm	W-Hmste W-Gpsm		B-Wood		
			$\left\{ \right\}$	112 FACUL		F-Conc2	C-Gpsm C-Gpsm	W-Gpsm W-Glass	W-Gpsm/Glass	W-Gpsm W-Gpsm	W-Gpsm W-Gpsm/Glass	B-Vinyl B-Wood		
BASE FINIS			$\left \right\rangle$		TY OFFICE	(F-Conc2)	C-Gpsm	W-Gpsm	W-Gpsm	W-Glass		B-Wood		N
Tile	Ceramic tile	<pre>> Daltile Keystones SUEDE GRAY D182, 1x1 > (COVE PIECE @ FLOOR)</pre>	\sum		TY OFFICE	F-Conc2	C-Gpsm	W-Glass	W-Gpsm/Glass	W-Gpsm	W-Gpsm	B-Wood		
-Wood	Painted, flush wood base per detail	/ TO MATCH PAINTED WALL	\sum	115 DEPAR	TMENT HEAD OFFICE	F-Conc2	C-Gpsm	W-Gpsm	W-Gpsm/Glass	W-Glass	W-Gpsm	B-Wood		
-Wood-2	Hardwood, flush base per detail, clear finish	(BEECH	$\left \right\rangle$	116 ELECTE	RICAL ROOM	F-Conc2	Exposed	W-Gpsm	W-Gpsm	W-Gpsm	W-Gpsm	B-Vinyl		
-Vinyl	4" resilient base as specified	FLEXCO, 014 MEDIUM GRAY, RUBBER			/									
			1ST FLOOR	120 LOWER		F-Conc2	C-Gpsm	W-Hmste/Gpsm	W-Hmste/Gpsm	W-Hmste	— 	B-Wood		
MISC. FINIS	SHES) THESIS { STUDIOS	121 THESIS	S STUDIO	F-Conc2	C-Gpsm	W-Hmste W-Hmste	W-Hmste W-Hmste	W-Hmste W-Hmste	W-Hmste W-Hmste	B-Wood	+	COLA
LAM. 'A'	PLASTIC LAMINATE, COLOR 'A', WHERE INDICATED IN DRAWINGS	WILSONART D91-60 SLATE GREY	$\langle $	122 THESIS		(F−Conc.−2) F−Conc.−2	C-Gpsm Exposed	W-Hmste W-Gpsm	W-Hmste W-Gpsm	W-Amste W-Gpsm	W-Hmste W-Gpsm	B-Wood B-Vinyl	PAINT CLG. BLACK	
			$\left \right\rangle$		S STUDIO	F-Conc2	C-Gpsm	W-Hmste	W-Hmste	W_Hmste	W-Hmste	B-Wood		
	NOTE: WHITE PAINT TO BE RODDA, LASYN INTERIOR VELVET FL	AT LATEX CH02E575	$\sum_{i=1}^{n}$	125 MECHA		F-Conc2	Exposed	W-Gpsm	-	()	W-Gpsm	B-Vinyl		
~~~~~~~~~~~~~~~~~~~~~~~~~~~~~~~~~~~~~~~				126 STORA	GE	F-Conc2	Exposed	W-Gpsm	W-Gpsm	W-Gpsm	W-Gpsm	B-Vinyl		
			2ND FLOOR			F-Conc.	) C-Gpsm	W-Glass/Wood		W-Gpsm/Wood	W-Gpsm	B-Wood 2		
							C-Gpsm-2	W-Wood W-Hmste/Gpsm	W-FWP/Gpsm-2/Wood W-Hmste/Gpsm	W-Hmste/Gpsm-2	W-FWP/Gpsm-2 W-Hmste/Gpsm		+	
			DRAWING, PAINTING,	201 GALLEF	N		C-Gnem				W-Gpsm	B-Vinyl	+	
				202 DESIGN		F-Lino-1	C-Gpsm C-Gpsm		W-Gpsm	W-Gpsm		+ - · · · · <i>j</i> ·		
			PAINTING,		N STORAGE		C-Gpsm C-Gpsm C-Gpsm	W-Gpsm W-Plywd/Gpsm	W-Gpsm W-Gpsm	W-Gpsm W-Plywd/Gpsm	W-Plywd/Gpsm	B-Vinyl		
			PAINTING,	202DESIGN202SDESIGN203TOOL	N STORAGE	F-Lino-1	C–Gpsm	W-Gpsm			W-Plywd/Gpsm W-Gpsm	B–Vinyl B–Vinyl		
			PAINTING,	202DESIGN202SDESIGN203TOOL	N STORAGE SHOP 2 SPRAY SPACE	F-Lino-1 F-Lino-1 (F-Lino-1)	C-Gpsm C-Gpsm	W-Gpsm W-Plywd/Gpsm	W-Gpsm	W-Plywd/Gpsm	W-Gpsm			
			PAINTING, DESIGN	202         DESIGN           202S         DESIGN           203         TOOL           204         LIMITEL           205         PAINTIN           205S         PAINTIN	N STORAGE SHOP D SPRAY SPACE NG STUDIO NG STORAGE	F-Lino-1 F-Lino-1 F-Lino-1 F-Lino-1 F-Lino-1 F-Lino-1 F-Lino-1	C-Gpsm C-Gpsm C-Gpsm C-Gpsm C-Gpsm	W-Gpsm W-Plywd/Gpsm W-Gpsm W-Hmste W-Gpsm	W-Gpsm W-Gpsm W-Hmste/Gpsm W-Gpsm	W–Plywd/Gpsm W–Gpsm W–Hmste/Gpsm W–Gpsm	W-Gpsm	B-Vinyl		
			PAINTING, DESIGN	202         DESIGN           202S         DESIGN           203         TOOL           204         LIMITEL           205         PAINTIN           206         DRAWIN	N STORAGE SHOP 2 D SPRAY SPACE NG STUDIO NG STORAGE NG STUDIO	F-Lino-1 F-Lino-1 F-Lino-1 F-Lino-1 F-Lino-1 F-Lino-1 F-Lino-1 F-Lino-1	C-GpsmC-GpsmC-GpsmC-GpsmC-GpsmC-GpsmC-Gpsm	W-GpsmW-Plywd/GpsmW-GpsmW-HmsteW-GpsmW-Hmste	W-Gpsm W-Gpsm W-Hmste/Gpsm W-Gpsm W-Hmste	W–Plywd/Gpsm W–Gpsm W–Hmste/Gpsm W–Gpsm W–Hmste	W-Gpsm W-Hmste/Gpsm W-Gpsm W-Hmste	B-Vinyl B-Wood B-Vinyl B-Wood		
			PAINTING, DESIGN	202DESIGN202SDESIGN203TOOL204LIMITEL205PAINTIN205SPAINTIN206DRAWIN206SDRAWIN	N STORAGE SHOP D SPRAY SPACE NG STUDIO NG STORAGE NG STUDIO NG STORAGE	F-Lino-1	C-GpsmC-GpsmC-GpsmC-GpsmC-GpsmC-GpsmC-GpsmC-Gpsm	W-GpsmW-Plywd/GpsmW-GpsmW-HmsteW-GpsmW-HmsteW-GpsmW-Gpsm	W-Gpsm W-Gpsm W-Hmste/Gpsm W-Gpsm W-Hmste W-Gpsm	W-Plywd/Gpsm W-Gpsm W-Hmste/Gpsm W-Gpsm W-Hmste W-Gpsm	W-Gpsm W-Hmste/Gpsm W-Gpsm W-Hmste W-Gpsm	B-Vinyl B-Wood B-Vinyl B-Wood B-Vinyl		
			PAINTING, DESIGN	202DESIGN202SDESIGN203TOOL204LIMITEL205PAINTIN205SPAINTIN206DRAWIN206SDRAWIN	N STORAGE SHOP 2 D SPRAY SPACE NG STUDIO NG STORAGE NG STUDIO	F-Lino-1 F-Lino-1 F-Lino-1 F-Lino-1 F-Lino-1 F-Lino-1 F-Lino-1 F-Lino-1	C-GpsmC-GpsmC-GpsmC-GpsmC-GpsmC-GpsmC-Gpsm	W-GpsmW-Plywd/GpsmW-GpsmW-HmsteW-GpsmW-Hmste	W-Gpsm W-Gpsm W-Hmste/Gpsm W-Gpsm W-Hmste	W–Plywd/Gpsm W–Gpsm W–Hmste/Gpsm W–Gpsm W–Hmste	W-Gpsm W-Hmste/Gpsm W-Gpsm W-Hmste	B-Vinyl B-Wood B-Vinyl B-Wood		
			PAINTING, DESIGN	202         DESIGN           202S         DESIGN           203         TOOL           204         LIMITEL           205         PAINTIN           206         DRAWIN           207         CONFE	N STORAGE SHOP D SPRAY SPACE NG STUDIO NG STORAGE NG STUDIO NG STORAGE RENCE ROOM	F-Lino-1         F-Lino-2	C-GpsmC-GpsmC-GpsmC-GpsmC-GpsmC-GpsmC-GpsmC-GpsmC-Gpsm	W-Gpsm W-Plywd/Gpsm W-Gpsm W-Hmste W-Gpsm W-Hmste W-Gpsm W-Hmste/Gpsm	W-Gpsm W-Gpsm W-Hmste/Gpsm W-Gpsm W-Hmste W-Gpsm	W–Plywd/Gpsm W–Gpsm W–Hmste/Gpsm W–Gpsm W–Hmste W–Gpsm W–Hmste/Gpsm	W-Gpsm W-Hmste/Gpsm W-Gpsm W-Hmste W-Gpsm	B-Vinyl B-Wood B-Vinyl B-Wood B-Vinyl B-Wood		
			PAINTING, DESIGN 2ND FLOOR THESIS	202         DESIGN           202S         DESIGN           203         TOOL           204         LIMITEL           205         PAINTIN           206S         DRAWIN           207         CONFE           220         UPPER	N STORAGE SHOP D SPRAY SPACE NG STUDIO NG STORAGE NG STUDIO NG STORAGE RENCE ROOM	F-Lino-1 $F-Lino-1$ $F-Lino-1$ $F-Lino-1$ $F-Lino-1$ $F-Lino-1$ $F-Lino-1$ $F-Lino-1$ $F-Lino-1$ $F-Lino-2$	C-GpsmC-GpsmC-GpsmC-GpsmC-GpsmC-GpsmC-GpsmC-GpsmC-GpsmC-GpsmC-Gpsm	W-GpsmW-Plywd/GpsmW-GpsmW-HmsteW-GpsmW-HmsteW-GpsmW-Gpsm	W-Gpsm W-Gpsm W-Hmste/Gpsm W-Gpsm W-Hmste W-Gpsm W-Glass/Gpsm	W-Plywd/Gpsm W-Gpsm W-Hmste/Gpsm W-Gpsm W-Hmste W-Gpsm	W-Gpsm W-Hmste/Gpsm W-Gpsm W-Hmste W-Gpsm	B-Vinyl B-Wood B-Vinyl B-Wood B-Vinyl		0   1   1 
			PAINTING, DESIGN 2ND FLOOR THESIS	202         DESIGN           202S         DESIGN           203         TOOL           204         LIMITEL           205         PAINTIN           206         DRAWIN           207         CONFE	N STORAGE SHOP D SPRAY SPACE NG STUDIO NG STORAGE NG STUDIO NG STORAGE RENCE ROOM CORRIDOR S STUDIO	F-Lino-1         F-Lino-3	C-GpsmC-GpsmC-GpsmC-GpsmC-GpsmC-GpsmC-GpsmC-GpsmC-Gpsm	W-GpsmW-Plywd/GpsmW-GpsmW-HmsteW-GpsmW-HmsteW-GpsmW-Hmste/GpsmW-Hmste/Gpsm	W-Gpsm W-Gpsm W-Hmste/Gpsm W-Gpsm W-Gpsm W-Glass/Gpsm	W-Plywd/Gpsm W-Gpsm W-Hmste/Gpsm W-Hmste W-Gpsm W-Hmste/Gpsm W-Hmste/Gpsm	W-Gpsm W-Hmste/Gpsm W-Gpsm W-Gpsm W-Cork/Gpsm - W-Hmste	B-Vinyl B-Wood B-Vinyl B-Wood B-Wood B-Wood		
			PAINTING, DESIGN 2ND FLOOR THESIS STUDIOS	202         DESIGN           202S         DESIGN           203         TOOL           204         LIMITEL           205         PAINTIN           206S         DRAWIN           207         CONFE           220         UPPER           221         THESIS           223         THESIS	N STORAGE SHOP 2 D SPRAY SPACE NG STUDIO NG STORAGE NG STUDIO NG STORAGE RENCE ROOM R CORRIDOR S STUDIO S STUDIO S STUDIO	F-Lino-1         F-Lino-1         F-Lino-1         F-Lino-1         F-Lino-1         F-Lino-1         F-Lino-1         F-Lino-1         F-Lino-3         F-Lino-3	C-GpsmC-GpsmC-GpsmC-GpsmC-GpsmC-GpsmC-GpsmC-GpsmC-GpsmC-GpsmC-Gpsm	W-GpsmW-Plywd/GpsmW-GpsmW-HmsteW-GpsmW-HmsteW-HmsteW-Hmste/GpsmW-Hmste/GpsmW-Hmste/GpsmW-Hmste/Gpsm	W-Gpsm W-Gpsm W-Hmste/Gpsm W-Gpsm W-Gpsm W-Glass/Gpsm - W-Hmste	W-Plywd/Gpsm W-Gpsm W-Hmste/Gpsm W-Hmste W-Gpsm W-Hmste/Gpsm W-Hmste/Gpsm W-Hmste	W-GpsmW-Hmste/GpsmW-GpsmW-GpsmW-Cork/Gpsm-W-Hmste	B-Vinyl B-Wood B-Vinyl B-Wood B-Wood B-Wood B-Wood		
			PAINTING, DESIGN 2ND FLOOR THESIS STUDIOS	202         DESIGN           202S         DESIGN           203         TOOL           204         LIMITEL           205         PAINTIN           206S         DRAWIN           206S         DRAWIN           207         CONFE           220         UPPER           221         THESIS           223         THESIS           224         THESIS	N STORAGE SHOP D SPRAY SPACE NG STUDIO NG STORAGE NG STUDIO NG STORAGE RENCE ROOM R CORRIDOR S STUDIO S STUDIO S STUDIO S STUDIO S STUDIO	F-Lino-1         F-Lino-1         F-Lino-1         F-Lino-1         F-Lino-1         F-Lino-1         F-Lino-1         F-Lino-1         F-Lino-1         F-Lino-3         F-Lino-3         F-Lino-3         F-Lino-3         F-Lino-3         F-Lino-3         F-Lino-3         F-Lino-3	C-GpsmC-GpsmC-GpsmC-GpsmC-GpsmC-GpsmC-GpsmC-GpsmC-GpsmC-GpsmC-GpsmC-GpsmC-GpsmC-GpsmC-GpsmC-GpsmC-GpsmC-GpsmC-GpsmC-GpsmC-GpsmC-GpsmC-GpsmC-GpsmC-Gpsm	W-GpsmW-Plywd/GpsmW-GpsmW-HmsteW-GpsmW-GpsmW-HmsteW-Hmste/GpsmW-Hmste/GpsmW-HmsteW-HmsteW-HmsteW-HmsteW-HmsteW-HmsteW-Hmste	W-Gpsm W-Gpsm W-Hmste/Gpsm W-Gpsm W-Hmste W-Glass/Gpsm - W-Hmste W-Hmste/Gpsm W-Hmste W-Hmste	W-Plywd/Gpsm W-Gpsm W-Hmste/Gpsm W-Hmste W-Gpsm W-Hmste/Gpsm W-Hmste/Gpsm W-Hmste W-Hmste W-Hmste W-Hmste	W-GpsmW-Hmste/GpsmW-GpsmW-GpsmW-Cork/GpsmW-Cork/GpsmW-HmsteW-HmsteW-Hmste/GpsmW-HmsteW-Hmste	B-Vinyl B-Wood B-Vinyl B-Wood B-Vinyl B-Wood B-Wood B-Wood B-Wood B-Wood B-Wood		No.
			PAINTING, DESIGN 2ND FLOOR THESIS STUDIOS	202         DESIGN           202S         DESIGN           203         TOOL           204         LIMITEL           205         PAINTIN           206S         DRAWIN           206S         DRAWIN           207         CONFE           220         UPPER           221         THESIS           223         THESIS           224         THESIS           225         RESTRY	N STORAGE SHOP D SPRAY SPACE NG STUDIO NG STORAGE NG STUDIO NG STORAGE RENCE ROOM R CORRIDOR S STUDIO S STUDIO S STUDIO S STUDIO S STUDIO OOM	F-Lino-1         F-Lino-3         F-Lino-3         F-Lino-3         F-Lino-3         F-Lino-3         F-Lino-3         F-Lino-3         F-Lino-3	C-GpsmC-GpsmC-GpsmC-GpsmC-GpsmC-GpsmC-GpsmC-GpsmC-GpsmC-GpsmC-GpsmC-GpsmC-GpsmC-GpsmC-GpsmC-GpsmC-GpsmC-GpsmC-GpsmC-GpsmC-GpsmC-GpsmC-GpsmC-GpsmC-GpsmC-Gpsm	W-GpsmW-Plywd/GpsmW-GpsmW-HmsteW-GpsmW-HmsteW-Hmste/GpsmW-Hmste/GpsmW-HmsteW-HmsteW-HmsteW-HmsteW-HmsteW-HmsteW-HmsteW-HmsteW-HmsteW-Hmste	W-Gpsm W-Gpsm W-Hmste/Gpsm W-Gpsm W-Hmste W-Glass/Gpsm - W-Hmste W-Hmste W-Hmste W-Hmste W-Hmste W-Hmste	W-Plywd/Gpsm W-Gpsm W-Hmste/Gpsm W-Hmste W-Gpsm W-Hmste/Gpsm W-Hmste/Gpsm W-Hmste W-Hmste W-Hmste W-Hmste W-Hmste W-Hmste	W-Gpsm W-Hmste/Gpsm W-Gpsm W-Gpsm W-Cork/Gpsm - W-Hmste W-Hmste W-Hmste/Gpsm W-Hmste/Gpsm W-Hmste/Gpsm	B-Vinyl B-Wood B-Vinyl B-Wood B-Vinyl B-Wood B-Wood B-Wood B-Wood B-Wood B-Wood B-Tile		
			PAINTING, DESIGN 2ND FLOOR THESIS STUDIOS	202         DESIGN           202S         DESIGN           203         TOOL           204         LIMITEL           205         PAINTIN           206S         PAINTIN           206S         DRAWIN           207         CONFE           220         UPPER           221         THESIS           223         THESIS           224         THESIS           225         RESTR           226         THESIS	N STORAGE SHOP 2 SPRAY SPACE NG STUDIO NG STORAGE NG STUDIO NG STORAGE RENCE ROOM R CORRIDOR S STUDIO S STUDIO S STUDIO S STUDIO OOM S STUDIO	F-Lino-1         F-Lino-3         F-Lino-3	C-GpsmC-GpsmC-GpsmC-GpsmC-GpsmC-GpsmC-GpsmC-GpsmC-GpsmC-GpsmC-GpsmC-GpsmC-GpsmC-GpsmC-GpsmC-GpsmC-GpsmC-GpsmC-GpsmC-GpsmC-GpsmC-GpsmC-GpsmC-GpsmC-GpsmC-GpsmC-Gpsm	W-GpsmW-Plywd/GpsmW-GpsmW-HmsteW-GpsmW-HmsteW-GpsmW-Hmste/GpsmW-Hmste/GpsmW-HmsteW-HmsteW-HmsteW-HmsteW-HmsteW-HmsteW-HmsteW-HmsteW-HmsteW-HmsteW-HmsteW-HmsteW-HmsteW-HmsteW-HmsteW-HmsteW-HmsteW-HmsteW-HmsteW-GpsmW-Hmste/Gpsm	W-Gpsm W-Gpsm W-Hmste/Gpsm W-Gpsm W-Gpsm W-Glass/Gpsm - W-Hmste W-Hmste W-Hmste/Gpsm W-Hmste/Gpsm W-Tile W-Hmste/Gpsm	W-Plywd/Gpsm W-Gpsm W-Hmste/Gpsm W-Hmste W-Gpsm W-Hmste/Gpsm W-Hmste/Gpsm W-Hmste W-Hmste W-Hmste W-Hmste/Gpsm W-Hmste/Gpsm W-Hmste/Gpsm	W-GpsmW-Hmste/GpsmW-GpsmW-GpsmW-Cork/GpsmW-Cork/GpsmW-HmsteW-Hmste/GpsmW-Hmste/GpsmW-Hmste/GpsmW-GpsmW-Hmste/GpsmW-Hmste/Gpsm	B-Vinyl B-Wood B-Vinyl B-Wood B-Vinyl B-Wood B-Wood B-Wood B-Wood B-Wood B-Wood B-Tile B-Wood		
			PAINTING, DESIGN 2ND FLOOR THESIS STUDIOS	202         DESIGN           202S         DESIGN           203         TOOL           204         LIMITEL           205         PAINTIN           206S         DRAWIN           206S         DRAWIN           207         CONFE           220         UPPER           221         THESIS           223         THESIS           224         THESIS           225         RESTR           226         THESIS           227         THESIS           227         THESIS	N STORAGE SHOP D SPRAY SPACE NG STUDIO NG STORAGE NG STUDIO NG STORAGE RENCE ROOM R CORRIDOR S STUDIO S STUDIO	$\begin{array}{c c} F-Lino-1 \\ \hline F-Lino-2 \\ \hline $	C-GpsmC-GpsmC-GpsmC-GpsmC-GpsmC-GpsmC-GpsmC-GpsmC-GpsmC-GpsmC-GpsmC-GpsmC-GpsmC-GpsmC-GpsmC-GpsmC-GpsmC-GpsmC-GpsmC-GpsmC-GpsmC-GpsmC-GpsmC-GpsmC-GpsmC-GpsmC-GpsmC-GpsmC-Gpsm	W-GpsmW-Plywd/GpsmW-GpsmW-HmsteW-GpsmW-HmsteW-Hmste/GpsmW-Hmste/GpsmW-HmsteW-HmsteW-HmsteW-HmsteW-HmsteW-HmsteW-HmsteW-HmsteW-HmsteW-HmsteW-HmsteW-HmsteW-HmsteW-HmsteW-HmsteW-HmsteW-HmsteW-HmsteW-HmsteW-HmsteW-HmsteW-HmsteW-HmsteW-Hmste	W-Gpsm W-Gpsm W-Hmste/Gpsm W-Hmste W-Gpsm W-Glass/Gpsm - W-Hmste W-Hmste/Gpsm W-Hmste W-Hmste/Gpsm W-Tile W-Hmste/Gpsm W-Hmste/Gpsm	W-Plywd/Gpsm W-Gpsm W-Hmste/Gpsm W-Hmste W-Gpsm W-Hmste/Gpsm W-Hmste/Gpsm W-Hmste/Gpsm W-Hmste W-Hmste/Gpsm W-Hmste/Gpsm W-Gpsm W-Hmste/Gpsm	W-GpsmW-Hmste/GpsmW-GpsmW-GpsmW-Cork/GpsmW-Cork/GpsmW-HmsteW-HmsteW-Hmste/GpsmW-Hmste/GpsmW-Hmste/GpsmW-Hmste/GpsmW-Hmste/GpsmW-Hmste/GpsmW-Hmste/GpsmW-Hmste/GpsmW-Hmste/GpsmW-Hmste/GpsmW-Hmste/GpsmW-Hmste/GpsmW-Hmste/Gpsm	B-Vinyl B-Wood B-Vinyl B-Wood B-Vinyl B-Wood B-Wood B-Wood B-Wood B-Wood B-Tile B-Wood B-Wood		
			PAINTING, DESIGN 2ND FLOOR THESIS STUDIOS	202         DESIGN           202S         DESIGN           203         TOOL           204         LIMITEL           205         PAINTIN           206S         PAINTIN           206S         DRAWIN           207         CONFE           220         UPPER           221         THESIS           223         THESIS           224         THESIS           225         RESTR           226         THESIS	N STORAGE SHOP D SPRAY SPACE NG STUDIO NG STORAGE NG STUDIO NG STORAGE RENCE ROOM R CORRIDOR S STUDIO S STUDIO	F-Lino-1         F-Lino-3         F-Lino-3	C-GpsmC-GpsmC-GpsmC-GpsmC-GpsmC-GpsmC-GpsmC-GpsmC-GpsmC-GpsmC-GpsmC-GpsmC-GpsmC-GpsmC-GpsmC-GpsmC-GpsmC-GpsmC-GpsmC-GpsmC-GpsmC-GpsmC-GpsmC-GpsmC-GpsmC-GpsmC-Gpsm	W-GpsmW-Plywd/GpsmW-GpsmW-HmsteW-GpsmW-HmsteW-GpsmW-Hmste/GpsmW-Hmste/GpsmW-HmsteW-HmsteW-HmsteW-HmsteW-HmsteW-HmsteW-HmsteW-HmsteW-HmsteW-HmsteW-HmsteW-HmsteW-HmsteW-HmsteW-HmsteW-HmsteW-HmsteW-HmsteW-HmsteW-GpsmW-Hmste/Gpsm	W-Gpsm W-Gpsm W-Hmste/Gpsm W-Gpsm W-Gpsm W-Glass/Gpsm - W-Hmste W-Hmste/Gpsm W-Hmste/Gpsm W-Tile W-Hmste/Gpsm W-Hmste/Gpsm W-Hmste/Gpsm	W-Plywd/Gpsm W-Gpsm W-Hmste/Gpsm W-Hmste W-Gpsm W-Hmste/Gpsm W-Hmste/Gpsm W-Hmste W-Hmste W-Hmste W-Hmste/Gpsm W-Hmste/Gpsm W-Hmste/Gpsm	W-GpsmW-Hmste/GpsmW-GpsmW-GpsmW-Cork/GpsmW-Cork/GpsmW-HmsteW-Hmste/GpsmW-Hmste/GpsmW-Hmste/GpsmW-GpsmW-Hmste/GpsmW-Hmste/Gpsm	B-Vinyl B-Wood B-Vinyl B-Wood B-Vinyl B-Wood B-Wood B-Wood B-Wood B-Wood B-Wood B-Tile B-Wood		
		3	PAINTING, DESIGN 2ND FLOOR THESIS STUDIOS	202         DESIGN           202S         DESIGN           203         TOOL           204         LIMITEL           205         PAINTIN           206S         PAINTIN           206S         DRAWIN           207         CONFE           220         UPPER           221         THESIS           223         THESIS           224         THESIS           225         RESTR           226         THESIS           227         THESIS           228         VESTIB	N STORAGE SHOP D SPRAY SPACE NG STUDIO NG STORAGE NG STUDIO NG STORAGE RENCE ROOM R CORRIDOR S STUDIO S STUDIO	$\begin{array}{c c} F-Lino-1 \\ F-Lino-2 \\ \hline \end{array}$	C-GpsmC-GpsmC-GpsmC-GpsmC-GpsmC-GpsmC-GpsmC-GpsmC-GpsmC-GpsmC-GpsmC-GpsmC-GpsmC-GpsmC-GpsmC-GpsmC-GpsmC-GpsmC-GpsmC-GpsmC-GpsmC-GpsmC-GpsmC-GpsmC-GpsmC-GpsmC-GpsmC-GpsmC-GpsmC-GpsmC-Gpsm	W-GpsmW-Plywd/GpsmW-GpsmW-GpsmW-HmsteW-GpsmW-HmsteW-Hmste/GpsmW-Hmste/GpsmW-HmsteW-HmsteW-HmsteW-HmsteW-HmsteW-HmsteW-HmsteW-HmsteW-HmsteW-HmsteW-HmsteW-HmsteW-GpsmW-GpsmW-HmsteW-GpsmW-Gpsm	W-Gpsm W-Gpsm W-Hmste/Gpsm W-Gpsm W-Gpsm W-Glass/Gpsm - W-Hmste W-Hmste W-Hmste/Gpsm W-Hmste/Gpsm W-Tile W-Hmste/Gpsm W-Tile W-Hmste/Gpsm X-Hmste/Gpsm	W-Plywd/Gpsm W-Gpsm W-Hmste/Gpsm W-Hmste W-Gpsm W-Hmste/Gpsm W-Hmste/Gpsm W-Hmste/Gpsm W-Hmste W-Hmste/Gpsm W-Hmste/Gpsm W-Gpsm W-Hmste/Gpsm	W-GpsmW-Hmste/GpsmW-GpsmW-GpsmW-Cork/GpsmW-Cork/GpsmW-HmsteW-HmsteW-Hmste/GpsmW-Hmste/GpsmW-Hmste/GpsmW-Hmste/GpsmW-Hmste/GpsmW-Hmste/GpsmW-Hmste/GpsmW-Hmste/GpsmW-Hmste/GpsmW-Hmste/GpsmW-Hmste/GpsmW-Hmste/GpsmW-Hmste/Gpsm	B-Vinyl B-Wood B-Vinyl B-Wood B-Vinyl B-Wood B-Wood B-Wood B-Wood B-Wood B-Tile B-Wood B-Wood		
		<u>3</u>	PAINTING, DESIGN 2ND FLOOR THESIS STUDIOS	202         DESIGN           202S         DESIGN           203         TOOL           204         LIMITEL           205         PAINTIN           206S         PAINTIN           206S         DRAWIN           207         CONFE           220         UPPER           221         THESIS           223         THESIS           224         THESIS           225         RESTR           226         THESIS           227         THESIS           228         VESTIB	N STORAGE SHOP D SPRAY SPACE NG STUDIO NG STORAGE NG STUDIO NG STORAGE RENCE ROOM R CORRIDOR S STUDIO S STUDIO	$\begin{array}{c c} F-Lino-1 \\ F-Lino-2 \\ \hline \end{array}$	C-Gpsm C-Gpsm C-Gpsm C-Gpsm C-Gpsm C-Gpsm C-Gpsm C-Gpsm C-Gpsm C-Gpsm C-Gpsm C-Gpsm C-Gpsm C-Gpsm C-Gpsm C-Gpsm C-Gpsm	W-GpsmW-Plywd/GpsmW-GpsmW-GpsmW-HmsteW-GpsmW-HmsteW-Hmste/GpsmW-Hmste/GpsmW-HmsteW-HmsteW-HmsteW-HmsteW-HmsteW-HmsteW-HmsteW-HmsteW-HmsteW-HmsteW-HmsteW-HmsteW-GpsmW-GpsmW-HmsteW-GpsmW-Gpsm	W-Gpsm W-Gpsm W-Hmste/Gpsm W-Gpsm W-Gpsm W-Glass/Gpsm - W-Hmste W-Hmste W-Hmste/Gpsm W-Hmste/Gpsm W-Tile W-Hmste/Gpsm W-Tile W-Hmste/Gpsm X-Hmste/Gpsm	W-Plywd/Gpsm W-Gpsm W-Hmste/Gpsm W-Hmste W-Gpsm W-Hmste/Gpsm W-Hmste/Gpsm W-Hmste/Gpsm W-Hmste W-Hmste/Gpsm W-Hmste/Gpsm W-Gpsm W-Hmste/Gpsm	W-GpsmW-Hmste/GpsmW-GpsmW-GpsmW-Cork/GpsmW-Cork/GpsmW-HmsteW-HmsteW-Hmste/GpsmW-Hmste/GpsmW-Hmste/GpsmW-Hmste/GpsmW-Hmste/GpsmW-Hmste/GpsmW-Hmste/GpsmW-Hmste/GpsmW-Hmste/GpsmW-Hmste/GpsmW-Hmste/GpsmW-Hmste/GpsmW-Hmste/Gpsm	B-Vinyl B-Wood B-Vinyl B-Wood B-Vinyl B-Wood B-Wood B-Wood B-Wood B-Wood B-Tile B-Wood B-Wood		

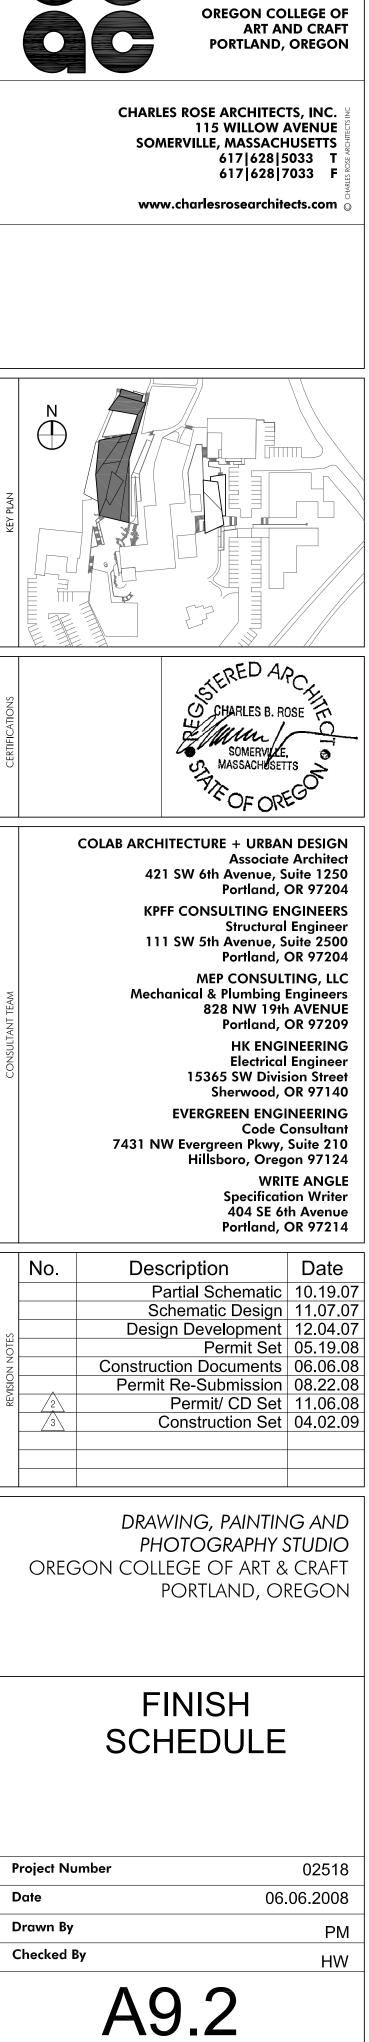

Scale

AS NOTED

PREPARED FOR:

PREPARED FOR: PREPARED FOR: OREGON COLLEGE OF ART AND CRAFT PORTLAND, OREGON	CHARLES ROSE ARCHITECTS, INC. 115 WILLOW AVENUE 30MERVILLE, MASSACHUSETTS 617/628/5033 T 617/628/7033 F www.charlesrosearchitects.com			CERTIFICATIONS CERTIFICATIONS COMERNUE.	COLAB ARCHITECTU 421 SW 6 KPFF CON 111 SW 5 Mechanical	828 NW 19th AVENUE Portland, OR 97209 HK ENGINEERING Electrical Engineer 15365 SW Division Street Sherwood, OR 97140 EVERGREEN ENGINEERING Code Consultant 7431 NW Evergreen Pkwy, Suite 210 Hillsboro, Oregon 97124 WRITE ANGLE Specification Writer 404 SE 6th Avenue Portland, OR 97214	No.       Description       Date         No.       Description       Date         Partial Schematic       10.19.07         Schematic Design       11.07.07         Design Development       12.04.07         Permit Set       05.19.08         Onstruction Documents       06.06.08         Image: Set	DRAWING, PAINTING AND PHOTOGRAPHY STUDIO OREGON COLLEGE OF ART & CRAFT PORTLAND, OREGON	DOOR SCHEDULE	Project Number02518Project Number06.06.2008Date06.06.2008Drawn ByJMDrawn ByJMDrawn ByJMDrawn ByJMScaleAS NOTEDScaleAS NOTED
	RISER LOCATION.		ENTRANCE: USE MAIN ENTRANCE DOORS TO THE SOUTH.		THAT DR IS TO REMAIN UNLOCKED DURING BUSINESS HRS	THAT DR IS TO REMAIN UNLOCKED DURING BUSINESS HRS			TYP. WALL LOCATION WHEN DOOR IS NEAR CORNER, U.N.O. – SEE PLAN	ALIGN, TYP. ALIGN, TYP. ALIGN, TYP. ALIGN, TYP. BEE SCHEDULE SCHEDULE SEE SCHEDULE SEE SCHEDULE & NOTE: HEAD DTL SIM. BEE SCHEDULE & SEE SCHEDULE & 11/2"=1'-0"
	DOOR: 1 HOUR DOOR IDENTIFYING SPRINKLER	& ELEVATIONS FOR FRAME DIMENSIONS TIVE	DOOR PER MECH DOOR PER MECH DOOR PER MECH DOOR PER MECH RED ON DOOR AT EXTERIOR: NOT AN ACCESSIBLE ENTF RED ON DOOR AT EXTERIOR: NOT AN ACCESSIBLE ENTF IN METAL TO MATCH FLASHING MATERIAL; NON-RATED		DE OF DR PER 3/A6.1; SIGN © INTERIOR INDICATING - & ELEVATIONS FOR FRAME DIMENSIONS OD TRANSFER GRILLE IN DOOR 2 ANIC HARDWARE & ELEVATIONS FOR FRAME DIMENSIONS & ELEVATIONS FOR FRAME DIMENSIONS	PANIC HARDWARE, BOTH LEAVES 2 & ELEVATIONS FOR FRAME DIMENSIONS IDE OF DR PER 3/A6.1; SIGN @ INTERIOR INDICATING PANIC HARDWARE 2 ANIC HARDWARE 2		DOOR PER MECH DOOR PER MECH DOOR PER MECH DOOR PER MECH DOOR PER MECH DOOR PER MECH DOOR PER MECH	DIM PER PLAN DOOR DIM PER SCHEDULE F.O. FRAMING 1/4"2" 3/8" (VERIFY WITH HINGE)	FABRIC WRAPPED 2" HOMASOTE 2" HOMASOTE 1.1/2"=1'-0" FABRIC WRAPPED 3/8" (VERIEY WITH HINGE) 3/8" (VERIEY WITH HINGE)


NOTE: SHOP DRAWINGS REQ'D FOR ALL DOORS (ELEVATIONS & DETAILS). SUBMITTAL REQ'D FOR ALL	HARDWARE, FLASHING & WEATHERSTRIPPING SHOP DWGS SHALL BE PREPARED USING FIELD MEASUREMENTS.
NOTE: SI	3 H

		) ) )			) ) )						
	ROOM	SIZE WIDTH	HEIGHT	THICKNESS	DOOR	MAT'L	FRAME DTL	MAT'L	HW SET	HANDING	REMARKS
	SOUTH VESTIBULE SOUTH CORRIDOR	2'-11" × 2 2'-11" × 2	7, 7,		1 1	ALUM/GLASS ALUM/GLASS	1 1	ALUM	03 05	LH/RH LH/RH	
	MECH_ROOM		· · · · · · · · · · · · · · · · · · ·	1-3/4"	A.V.			WOOD	20	LHR	SIG
}		3'-6"	7'			METAL		METAL			FIRE-RATED DOOI
		0, <u>v</u>	, , , , , , , , , , , , , , , , , , , ,		D	WOOD	-	WOOD	11	LHR	اد
	MEN'S RESTROOM	, м <b>,</b>	7,	-3/4	A	MOOD	~	WOOD	11	LHR	1
	3	n ju	, <b>,</b> , ,	- 1-3/4"	I A	3	-	WOOD	15	LHR	1 1
~	DIGITAL STUDIO	, Д	7,	, /~ _ ~	4	ALUM/GLASS	-	ALUM	01 15	RH	
	CLASSROOM	o, o	,	1-3/4"	( <b>4</b>	MOOD		WOOD	15	RHR	1
~	CLASSROOM DAPKPOOM VESTIBLIE	ч, Q,	7,	۲/ ۲ -	<	ALUM/GLASS	-	ALUM	01	LHR	1
	*		, <b>, , ,</b>		<b>E E</b>	WOOD		MOOD	- 1 4	H	1 1
	FILM ROOM	2'-6"	1 1	-3/4	<b>A</b> •	MOOD		MOOD	4 4	RH H	I
	-ILM ROOM # PHOTOGRAPHY	3' × 2		4 4	A F	WOOD	<del>-</del> -	MOOD	21	RH LHR/RHR	1 1
RM	STUDIO	<	. 1		_ 1		2/A6.1		-	SLIDING	EE PLA
	ALTERNATIVE PROCESSING	3' and 2' 3'	7,	1-3/4" 1-3/4"	L A	doow	<del>-</del> -	MOOD	22	RHR/LHR I HR	3' LEAF ACTIVE -
	EQUIPMEN	0, ju	·	4	; ш	DOOM		DOOM	16	RHR	
с С С С С С	EACULTY OFFICE	, M	,,,,,,,,	1 1		ALUM/GLASS ALUM/GLASS	1 1	ALUM	1 - 1 1 - 1	LHR RHR	UNDERCUT DOOR
EQ 1	FACULTY OFFICE	3,	7,	1	1		I	ALUM	13	RHR	UNDERCUT DOOR
	DEPARTMENT HEAD OFFICE	3,	7,	1	1	ALUM/GLASS	1	ALUM	13	LHR 2	UNDERCUT DOOR
к ЕQ.	DEPARTMENT HEAD OFFICE	о <b>,</b> о	7,	1 1		ALUM/GLASS	1 1	ALUM	13	LHR	
	DEPT. HEAD STORA(	д,	7,	1-3/4"	A 3		1	WOOD	12	RHR	
		n	~	101	٩	MEIAL	<b>c</b>	MEIAL	0	E	NUOK IN
	ROOM	SIZE WIDTH	HEIGHT	THICKNESS	DOOR	MΔT'I	FRAME	MΔT'I	HW SET	HANDING	REMARKS
	SOUTH VESTIBULE	3' × 2	7,		J - - -	ALUM/GLASS	1 5	ALUM	03	LHR/RHR	1
~	C		7,		<	ALUM/GLASS	l c		06	LHR/RHR Du	I
	DESIGN STUDIO 202	o, jo	, <b>, , ,</b>		( <b>4</b>	WOOD	7 7	MOOD		RH HR	
	TOOL SHOP DFSIGN STORAGE		7,	1-3/4" 1-3/4"	A Q	doow	- M	doow doow	10(	LH SI IDING	1
	DESIGN S	0, 0, 0	, <u>, </u> , <u>,</u>	5	A, SIM	HDWD		HDWD	60	LHR	D EA. SIDE
M	DESIGN STUDIO	л, г С	- <b>`</b> ^	1.1.	І ц		2/A6.1 2	-	1 0	SLIDING	SEE PLANS & EL 
	LIMITED SPRAY SPACE	0, 00 1	, <b>, , ,</b>	-3/	- <	MOOD	2	wood	1	LH	CUSTOM WOOD TH
		٦, ٩	7,	Π.	< 0	DOOM	2	WOOD 2	15-P	RH	
RM	AINTING S	5 I	~ 1	í  .			2/A6.1		2 1	SLIDING	SEE PLANS & EL
	AINTING	î M	í J	1-3/4"	< 1	DOOM		MOOD Z	15-P		REQUIRES PANIC
NA	DRAWING STUDIO DRAWING STUDIO	3: × 2	. 1	M	<u> </u>	- W00D		MOOD -	21-P		SFF PLANS & FL
	DRAWING STUDIO	Q,	7,		A, SIM	HDWD	/A6.	HDWD	60		CLAD EA. SIDE O
	DRAWING STORAGE	ъ, 6,	7,	1-3/4"	- 10	doow	2 2	WOOD 2	10 15,0	RHR	
К ЕQ.	CONFEREN		, ,, ,, ,, ,, ,, ,, ,, ,, ,, ,, ,, ,, ,		ς Ι	/GLAS	1 1	ALUM		RHR	<u>,  </u> 5
	GALLERY		1 1	1	1	-UM/GL	1	ALUM	04		I
	NOT USED	×				ALUM GLASS		ALUM	44 2		
	NOT USED NOT USED										~~~~
		CITE					EDAME				DEMADIZO
		WIDTH	HEIGHT	THICKNESS	TYPE		DTL	MAT'L	·		
~		, о,	7,	- 1-3/4"		ALUM/GLASS		ALUM	02	RH HR	
	HESIS STUDIO 12	о, <mark>с</mark>	,	-3/	( <	WOOD		MOOD	- <u>-</u> - 15	RHR	1 1
	STORAGE THESIS STUDIO 124	, д	7,	1-3/4" 1-3/4"	< <	MOOD	<del></del>	MOOD COOW	17	LHR	1
	ECHANICAL	о, с		-3/4	. <b>A</b>	MOOD		MOOD	20	RHR	
	UPPER CORRIDOR	3,	7	1	1	ALUM/GLASS	1	ALUM	02	H	
	SIS STUDIO 22	1 01	î J	1-3/4"	Α.			WOOD	15	LHR	RCUT
	THESIS STUDIO 224 RESTROOM	3. 3,	7	<u>1-5/4</u> 1-3/4"	<b>4 4</b>	WOOD	<del>.</del> .	MOOD	15 18	LH RHR	UNDERCUT DOOR UNDERCUT DOOR
	THESIS STUDIO 226	1 M 1	- <b>1</b> ,	1-3/4"		DOOM		MOOD	15	LHR	RCUT
		ν 'n	<u></u>	1-3/4"	<u>ح</u>	WOOD MOOD		MOOD WOOD	ן5 זא	LHR RHR	UNDERCUT DOOR UNDERCUT DOOR
	THESIS STUDIO 221	3,	7,	1-3/4"	. <b>V</b>	MOOD		MOOD	15	RHR	
•	:										

tails

TYP. POCKET DOOR JAMB DETAIL 1 1/2"=1'-0" ALIGN, 1,1/4" - FACE OF WALL FINISH-SEE SCHEDULE & DETAILS DOOR DIM PER SCHED. HTCH WIDTH OF WALL NOTE: HEAD DTL SIM. 3/8" TU 1/4"2"  $\mathfrak{O}$ 3 NOT USED 1 1/2"=1'-0" 4 - EXT. FACE OF CONCRETE 9 . V H.M. FRAME AT CONCRETE 1 1/2"=1'-0" **`**~ SEALANT, TYP -H.M. FRAME -DOOR DIM. PER -SCHEDULE NEOPRENE WASHER @ SCREW; SEALANT BEHIND METAL --

TZP.

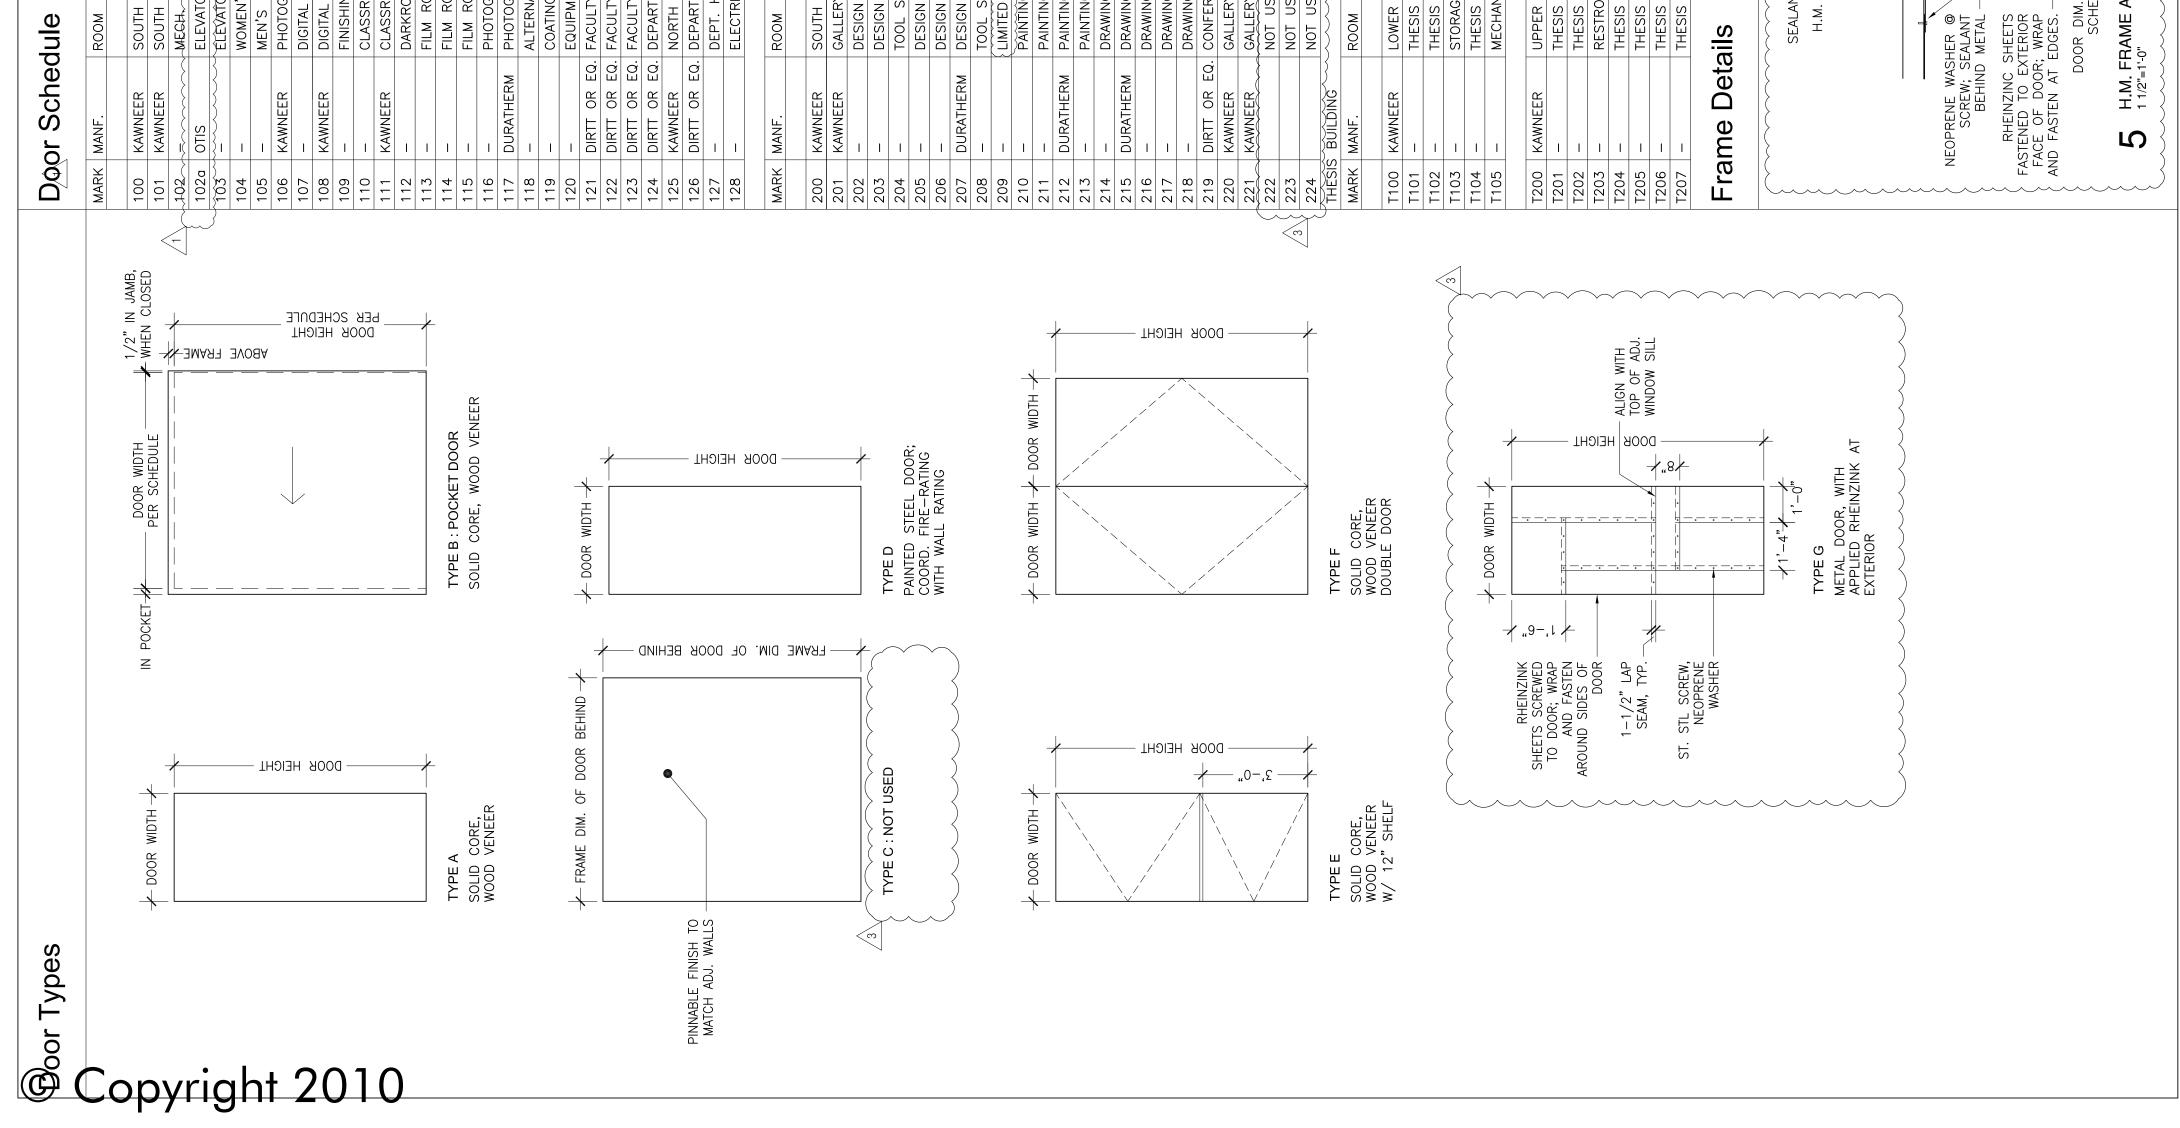

MECH	HANICAL LEGE	ND AND SYMBOLS	MECHANICAL			L ABE	BREVIATIONS				DIF			ERS, REGIST e Imodule siz			
SA	$\ge$	SUPPLY AIR DUCT CROSS-SECTION	ABBR.	DE	SCRIPTION	ABBR.	DESCRIPTION	SYMBOL CD-1	MODEL TITUS		ITPE EILING SUPP		CE N ORATED	40DULE 24x24		RAME RE AY-IN 1,2	
RA		RETURN AIR DUCT CROSS-SECTION	ABV	ABOVE		GPM	GALLONS PER MINUTE	CD-2 CD-3	TITUS TITUS		EILING SUPF EILING SUPF		ORATED ORATED	24x24 12x12		IRFACE 1,2 IRFACE 1,2	
RA	$\sim$	EXHAUST AIR DUCT CROSS-SECTION	AFF	ABOVE FINISHE	FLOOR	HP	HORSE POWER	CD=3 CE-1	TITUS		ILING EXHAU		ORATED	12x12		IRFACE 1,2	
OSA		OUTSIDE AIR DUCT CROSS-SECTION	AD	ACCESS DOOR		HZ	HERTZ	CE-2 CR-1	TITUS TITUS		EILING EXHAUST PERFORA			24x24 24x24		IRFACE 1,: AY—IN 1,2	
CD		CEILING DIFFUSER, 2 - WAY	AP	ACCESS PANEL		KW	KILOWATT	CR-1 CR-2	TITUS		EILING RETU		ORATED	24x24 24x24		IRFACE 1,2	
CD		CEILING DIFFUSER, 4 – WAY	A/C	AIR CONDITIONI	IG	LAT	LEAVING AIR TEMPERATURE	FG-1 FGR-1	TITUS C		LOOR SUPP			SEE DRAW		IRFACE 1,2	
CD		CEILING DIFFUSER, 4 - WAT	ARCH	ARCHITECTURAL		LBS	POUNDS	SLS-1	TITUS		LOOR RETUR		ARS "SLOTS	48"LON		IRFACE 1,2 IRFACE 1,2	
CR		CELING RETURN AIR GRILLE	BDD	BACKDRAFT DAM	IPER	МА	MIXED AIR	SLS-2	PRICE		-SLOT SUPP DEWALL RETU	$\mathbf{v} \mathbf{v} \mathbf{v}$	"SLOTS	24"LON SEE DRAV		IRFACE 1,2 IRFACE 1,2	
CE		CELING EXHAUST AIR GRILLE	BHP	BRAKE HORSE	POWER	MUA	MAKE-UP AIR UNIT	SWR-1		ATG2 TR	ANSFER GRI	LLE BL	ADES	SEE DRAV	WING SL	IRFACE 1,2	2,5
sws		SIDE WALL SUPPLY REGISTER	BTU	BRITISH THERM	L UNIT	MAX.	MAXIMUM	NOTES:		RAWINGS FOR NE	ECK SIZES.	3. FURNIS	SH RETURN	AIR SIGH	T BAFFLE.		
SWR		SIDE WALL RETURN GRILLE	втин	BTU PER HOUR		MIN.	мілімим		2. PROVIL	E WITH PAINTABI	LE FINISH.	4. PROVIL		AND ACC	ESSURIES F	OR HARD CE	
CD	— CD —	CONDENSATE DRAIN	CEG	CEILING EXHAUS	ST GRILLE	(N)	NEW							EXHA		FAN S	
		ROOM THERMOSTAT	CER	CEILING EXHAUS	ST REGISTER	N/A	NOT APPLICABLE	MARI	ĸ	LOCATION	CF	M SP		VE H	P/ TTS RP		POWE
		EQUPIMENT IDENTIFICATION	CLG	CEILING OR CO	DLING	NO	NUMBER			RESTROOM							
			CRG	CEILING RETUR	I GRILLE	NIC	NOT IN CONTRACT			CEILING	60	.35		1	/3 1,85	9 80	115
SINGLE LINE	DOUBLE LINE	DESCRIPTION	CRR	CEILING RETURN	I REGISTER	NTS	NOT TO SCALE		$\longrightarrow$		INE 25	0.75	N		0W 1,05		115
		VOLUME DAMPER	CSD	CEILING SUPPL	DIFFUSER	OAI	OUTSIDE AIR INTAKE			DARK ROOM SIN		0 1.0	D		<b>× × ×</b> /3 2,12	v	115
	FD F	FIRE DAMPER	<u>କ</u>	CENTER LINE		OSA	OUTSIDE AIR			DARK ROOM SIN		-	$+\!\!\!\!\!\!\!\!\!\!\!\!\!\!\!\!\!\!\!\!\!\!\!\!\!\!\!\!\!\!$				
FD	FSD +		COL	COLUMN		OBD	OPPOSED BLADE DAMPER			SINKS			<u></u>	1	/2 2,18	9 80	115
FSD		FIRE/SMOKE DAMPER	CONT	CONT CONTINUATION		PD	PRESSURE DROP	$\left  \left\{ \left  \left\langle \frac{EF}{4} \right\rangle \right. \right. \right $		DARK ROOM SIN	NK 120	0 { 1.0	λ –	1	/2 1,97	4 85	115
		SMOKE DAMPER	cv	CONSTANT VALV	E	PH	PHASE			DARK ROOM SIN	NK 25	$\sim$ $1.0$	$\mathbb{K}_{-}$	1	/3 1,89	8 80	115
		MOTORIZED DAMPER	СР	CONTROL PANE		PSI(G)	POUNDS PER SQUARE INCHES (GAUGE)			SINKS DARK ROOM SIN			+				
ЪмD	MD ⊡		сс	COOLING COIL		QTY	QUANTITY			SINKS	25	D 1.0	<u>}</u> -	1	/3 1,89	8 80	115
		MITERED ELBOW WITH TURNING VANES	CFM	CUBIC FEET PE	R MINUTE	R	RISE			DARK ROOM SIN	NK 67	0 1.0	{ -	1	/2 2,22	6 80	115
Ĵ	Ĵ	RADIUSED ELBOW	CU	CONDENCING U	NIT	RA	RETURN AIR	EF 8		DARK ROOM SIN	NK 27	0 1.0		1	/3 2,13	4 80	115
		RADIOSED ELBOW	DIA. or ø	DIAMETER		RPM	REVOLUTION PER MINUTE			SINKS DARK ROOM SIN			-		·		
, T		RECTANGULAR MAIN WITH ROUND BRANCH	DN	DOWN		RTU	ROOF TOP UNIT			SINKS	120	0 ( 1.0	ノ	1	/2 1,97	4 85	115
· · · · · · ·		RECTANGULAR MAIN WITH RECTANGULAR BRANCH	DWG	DRAWING		SA	SUPPLY AIR			DARK ROOM SIN	NK 120			1	/2 1,97	4 85	115
L	لملا		DB	DRY BULB		SEER	SEASONAL ENERGY EFFICIENCY RATING					.35	<u>acc</u>				115
		CONCENTRIC SQUARE TO ROUND	DBT	DRY BULB TEM	р.	SP	STATIC PRESSURE			MITED SPRAY SF						-	
, <b>→ →</b> →		CONCENTRIC TRANSITION, RECTANGULAR OR ROUND	DX	DIRECT EXPANS	ON	SPEC.	SPECIFICATION			CEILING	19				3W 1,00		115
	┟╌╷╌╁	ECCENTRIC TRANSITION, RECTANGULAR OR	EA	EXHAUST AIR		мвн	THOUSAND BTU PER HOUR			BACK DRAFT DA HANGING VIBRATI						6. CONT	
		ROUND	EAT	ENTERING AIR 1	EMPERATURE	TEMP.	TEMPERATURE										
<u>}</u> {		NON-SYMMETRICAL WYE	EF EXHAUST FAN		TG	TRANSFER GRILLE	┫┣──		I								
		SYMMETRICAL WYE	EER			TYP.	TYPICAL	MARK		ACTURER		NDOOR		MIN. OSA	BTUH		
	► 		ELEC.			v	VOLT	FCU						G. WATTS		TOTAL	SEEF
		RECTANGULAR DUCT RISER	ET	EXPANSION TAN	к	VD	VOLUME DAMPER			FXMC	aikin: Q30MVJU	56	5 0.35	307W	140	30,000	-
$\otimes \longrightarrow$		ROUND DUCT RISER	EX.			w/	with				AIKIN: Q30MVJU	69	0 0.35	307W	170	30,000	-
		RECTANGULAR DUCT DROP	(E)			w/o	WITHOUT	FCU FC	:U\	D/		95	0 0.35	467W	235	36,000	<u> </u>
	(×) S	ROUND DUCT DROP	FC	FLEXIBLE CONN	ECTION	w	WATT				Q36MVJU 						+
			FLR			WB	WET BULB	FCU FCU FCU FCU FCU		10 FXSC	AIKIN: Q48MVJU	1,3	00 0.35	745W	325	48,000	-
		RECTANGULAR OFFSET LESS THAN 15"	FPM			wc	WATER COLUMN		2 FCU F 2 13		AIKIN: Q48MVJU	1,3	00 0.35	745W	325	48,000	-
		RECTANGULAR OFFSET MORE THAN 15°				<u> </u>	•	FCU FC		D/		70	0 0.35	745W	175	24,000	<u> </u>
,`		ROUND WYE						16 1 /FCU	/ \ 18 /		Q24MVJU AIKIN:						
								19			AIKIN: Q24MVJU	90	0 0.35	745W	200	24,000	
, → Ţ →		ROUND DUCT WITH ROUND BRANCH			DRAW	'ING L	IST	NOTES:	1. PROVIDE	FACTORY INSTAL	LED DISCON	NECT		2. T'STAT	PROVIDED	BY DIV. 15,	INSTALL
<u>}</u>		ACCOUSTICALLY LINED DUCT (SIZES SHOWN ARE NET INSIDE)		DRAWING M0.1 M0.2	TITLE HVAC SCH	IEDULES AN	D LEGEND							DOOR	HEA	T PUN	IP V
	·	FLEXIBLE CONNECTION		M0.2 M1.1	HVAC DIAG	GRAMS & O	SA REQUIREMENTS HESIS FLOOR PLAN		MANUE	ACTURER &	U	NIT FAN		C00		HEATI	
<b>~~~~</b>				M1.1 M1.2 M1.3	HVAC FIRS	ST FLOOR S	TUDIO FLOOR PLAN TUDIO FLOOR PLAN TUDIO FLOOR PLAN	MARK		NUMBER	CFM	ESP IN WG.	MTR. WATTS	BTUH TOTAL	EER	(KW)	втин
				M2.1 M2.2	HVAC SEC	OND FLOOR	THESIS FLOOR PLAN STUDIO FLOOR PLAN			IKIN: D72MTJU	7,400	_	750W	72,000	11.1		81,000
				M2.2 M6.1	HVAC SEC				DA	IKIN:			0) 7500	100.005			
										68MTJU	(2) 7,400	- (	2) 750W	168,000	11.1	- 1	89,000

NOTES: 1. PROVIDE FACTORY MANIFOLD KIT.

(2) 7,400

—

DAIKIN: RXYQ168MTJU

HP 3

	S AN				N	AIR	G	RIL	LE	S											
	RAME AY-IN	REI 1,2	MARKS																		
	JRFACE JRFACE	1,2																			
	JRFACE JRFACE	1,2 1,2																			
	JRFACE AY-IN	1,2 1,2																			
	JRFACE	1,2																			
	JRFACE JRFACE	1,2 1,2																			
	JRFACE	1,2,	4																		
$\sim$	JRFACE	1,2, 1,2	4																		
	JRFACE	1,2,	5			$\sim$	$\sim$				$\sim$	$\overline{}$	$\overline{}$								
.E. ES F	FOR HARE	) CEI	LING INS	STALLATI	ON.	5. LI					FER			)							
Т	FAN	S	CHE	DUL	.E																
RP	M WEIG		POWE VOLT	R SUF PH	PL\ Hz	_	MAK	E/M	ODE	EL		N	DTE	S							
,85	9 80		115	1	60	G	REEN	HECK:	BS	Q—80—	3	1,2	2,3								
,05	0 21		115	1	60				CSI	P-B290		1,2	2,4,5	j							
2,12	2 80	-	115	1	60	G	REEN	HECK:	BS	Q-70-	3	1,2	2,3	<u>}</u>							
2,18	9 80		115	1	60	G	REEN	HECK:	BS	Q—70—	5	1,2	2,3	$\frac{1}{3}$							
97,97	4 85		115	1	60	GI	REENH	HECK:	BSQ	-100-	-5	1,2	2,3	<u> </u>							
1,89	8 80		115	1	60	G	REEN	HECK:	BSC	Q—70—	4	1,2	2,3	$\downarrow$							
,89	8 80		115	1	60	G	REEN	HECK:	BSC	Q—70—/	4	1,2	2,3	<u>}</u>							
2,22	.6 80		115	1	60	G	REEN	HECK:	BS	Q—80—	5	1,2	2,3	$\left\langle \right\rangle$							
2,13	4 80		115	1	60	G	REEN	HECK:	BSC	Q—70—	4	1,2	2,3	}							
,97	4 85		115	1	60	GI	REENH	HECK:	BSQ	-100-	-5	1,2	2,3	<u>}</u>							
,97 •		$\simeq$	115		60	**	$\sim$	~~	3		$\Rightarrow$	R	Þ	, ~							
950			115	1	60	_				-100-5 1,2,3 P-B110 1,2,3,5 P-A250 1,2,5,6											
,00, 			115		60					P-A250		1,2 	2,5,6	كر أ							
			OLLED M	IOTION	SENS	OR															
Ν													17.4								
DSA M)	BTL		SEEF	<u>к</u> (к)		EATING UNIT POWER UTILIZATION NOTES															
)	<u> </u>					34,00		100		208		╉	60	1.6	15	1,2					
) )	30,00	000 -											60 60	1.6	15	1,2					
5	36,00				-	34,000     100     208     1       40,000     125     208     1			60	2.9	15	1,2									
5	48,00		_			54,00		125		208			60	4.4	15	1,2					
	48,00		_	+	-	54,00		125		208			60	4.4	15	1,2					
ו	,		_	+	-	26,00		125		208			60	4.4	15	1,2					
	24,00	)0	-	_	_	26,00		125		208			60	4.4	15	1,2					
5	24,00		_	-		1				1				<u> </u>							
5		00	- INSTALLE	D BY [	DIV. 1	6.															
5 ) )ED	24,00 BY DIV.	)0 15,					) UI														
5 DED	24,00 BY DIV. T PL HE	00 15, JM ATIN	PV G	R V unit	SC	HE[ powe	r ut	TLIZA						NOTE	 S						
5 DED	24,00 BY DIV. T PL	00 15, JM ATIN	РV G втин	R V UNIT WEIGH	SC	HE[ powe volt	r ut Ph	TLIZA Hz	M	CA	MO			NOTES	S						
5 DED	24,00 BY DIV. T PL HE	00 15, JM ATIN E 8	P V g 3tuh 1,000	RV UNIT WEIGH 666	SC IT	HE POWE VOLT 208	R UT PH 3	TLIZA Hz 60	M' 44	CA 4.8	60	)			S						
	24,00 BY DIV. T PL HE	00 15, JM ATIN E 8 18	РV G втин	R V UNIT WEIGH	SC IT	HE[ powe volt	r ut Ph	ILIZA Hz 60 60	M 44 (2)	CA		) 60		NOTES 1	S						

11.1

(2) 750W 168,000

